


LATERAL 6 MAIN 23 SAN SEWER NO 22
BUILT BY: CCC OF WICHITA INC.
PROJ. NO 468-76-245-80190-000-000-001
BOOKED 8-16-80 FROM A611

on map


SCALE 1" = 150'

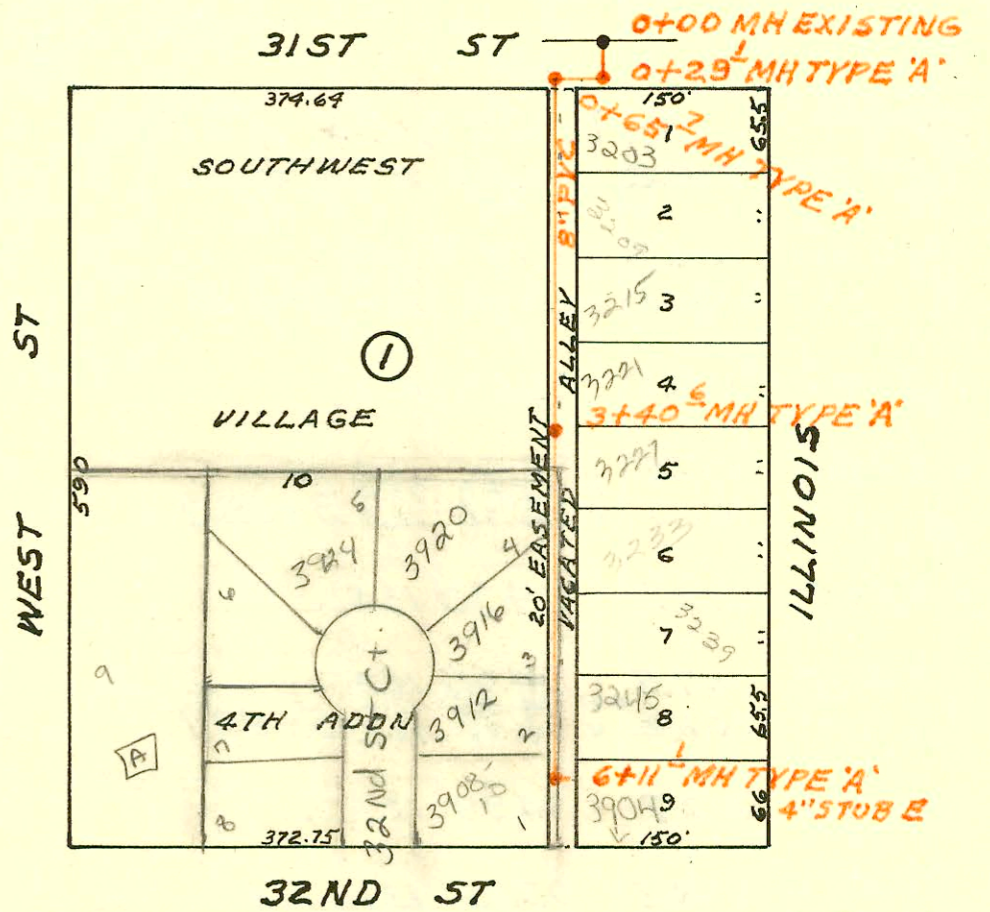

LATERAL 17 MAIN 1 WESTLINK SAN
BUILT BY: COLEMAN EXCAVATING INC.
PROJ. NO 468-76-245-80730-000-000-001
BOOKED 8-16-80 FROM A611

on map

SCALE 1" = 150'

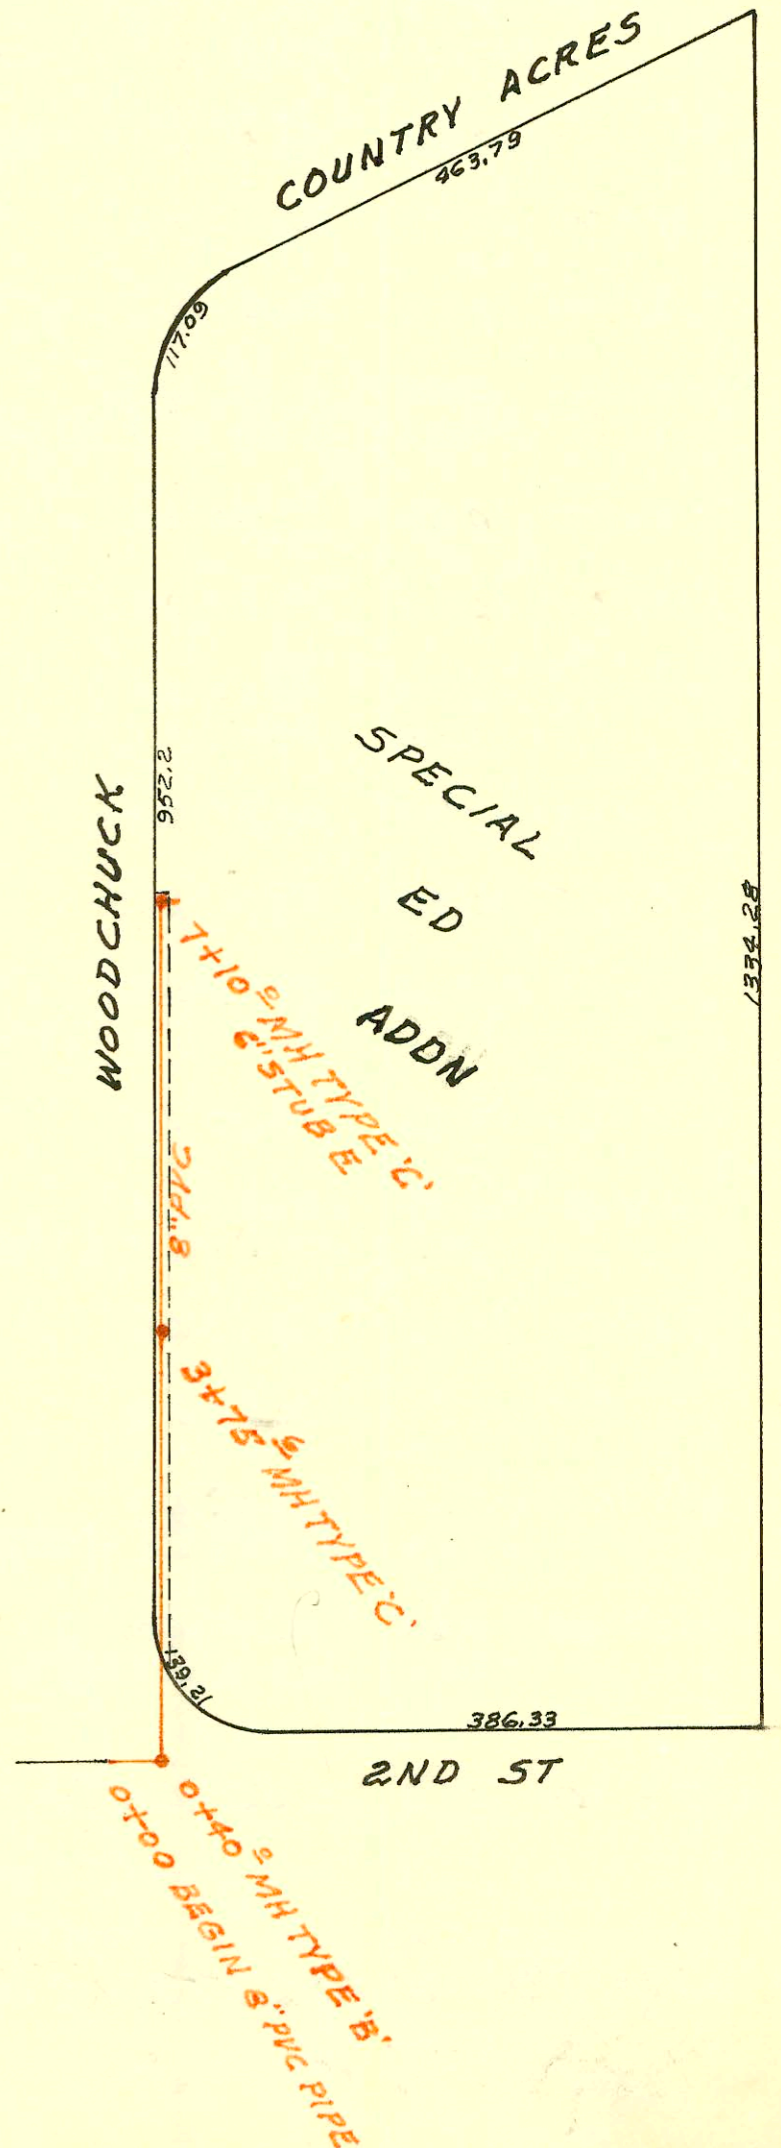

CONSTRUCTION RECORD

SERVICE RECORD

STATION	ELEVATION		Depth	MANHOLE	4-INCH "Y" BRANCHES		No. of Permit		House Number		DATE OF PERMITS	
	Ground	Grade			North West	South East	North West	South East	North West	South East	North West	South East
LATERAL 6 MAIN 23 SAN SEWER N#22												
0+00	102.0	90.62	11.4	EXISTING								
	102.5	90.71 90.81	11.8 11.7	0+29.1								
	102.4	90.92 91.02	11.5 11.4	0+65.7								
1+00	102.4	91.12	11.3		1+00.9		954		3203		8-12-80	
					1+12.7		5403		3209 S		3-22-82	
2+00	102.1	91.42	10.7		1+88.7		5557		3215 S		4-7-82	
3+00	101.9	91.72	10.2		NE side of mH tap		8003		3221 S		5-2-83	
	101.8	91.84	10.0	3+40.6	SE side of mH tap		23944	8002	3920 W W 32nd St	3227 S Illinois	9-25-89	5-2-83
4+00	101.9	92.02	9.9		4+20.6		10579		3233 S		4-5-84	
					4+67.7 TAP	4+95.7	23523	5404	3916 W 32nd	3237 S Illinois	7-12-89	3-22-82
5+00	101.8	92.32	9.5		5+56.6 TAP	5+39.0	23522	955	3912 W 32nd	3245 S Illinois	7-12-89	8-12-80
6+00	101.7	92.62	9.1		4" SDR 35 6+06.1 tap	4" STUB E 4" 5+6.5	28141-7	956	3908-10 W 32nd St	3251 S Illinois 3214 S	7-29-91	8-12-80
	101.7	92.65	9.1	6+11.1				956				8-12-80
LATERAL 17 MAIN 1 WESTLINK SAN												
0+00	152.5	140.17	12.3	Begin Pipe								
	151.4	OUT 140.29 IN 140.39	11.1 11.0	0+40.0								
1+00	152.6	140.59	12.0									
2+00	152.4	140.93	11.5									
3+00	152.5	141.27	11.2									
	153.4	141.53	11.9	3+75.6								
4+00	153.0	141.61	11.4									
5+00	153.5	141.95	11.6									
6+00	153.2	142.29	12.9									
7+00	156.2	142.63	13.6									
	154.5	142.67	11.8	7+10.0		6" STUB E		?	400 Woodchuck	See Below		?
LATERAL 55 N#8 (CONT'D)												
LINE 3 0+00	106.5	96.79	9.7	0+00=3+52.7 LINE 1								
	106.2	97.10	9.1	0+76.4	4" STUB N 4" STUB NW		12736 16115		1706 Harry 1750 Harry		12-11-81 4-7-86	
LINE 4 0+00	108.4	95.75	12.7	0+00=8+50.5 LINE 1								
1+00	107.3	96.15	11.2		CITY TAP 4" Predeo 1+06 4" PVC		2003 00592		1912 Harry		3-7-03	
2+00	107.3	96.55	10.8									
	106.6	96.85	9.8	2+74.5	4" STUB W 4" STUB NW							
LINE 5 0+00	107.3	99.67	7.6	0+00=19+42.5 LINE 1								
1+00	107.3	99.97	7.3									
2+00	108.0	100.28	7.7									
	108.0	100.38	7.6	2+34.6								
3+00	107.9	100.58	7.3		4" ABS 40 2+26.6 tap		11209		2118 W Harry		7-9-85	
4+00	107.1	100.88	6.2			4+03.6 tap		99-6883-1 16217	2000 R W Harry		4-16-89 8-8-86	
	106.7	101.10	5.6	4+74.8	4" STUB NW 4" STUB NE		2000 02406		2140 Harry Ct		11-29-00	

Private Sample

400 N Woodchuck - Levy school - NO orig. Record of conn for school
 Sep 2001 03056 11/30/01 400 N Woodchuck - Roof Plb (Bldg add)