


DOOLEY (VAC)

ELIZABETH (VAC)

ST CLAIR

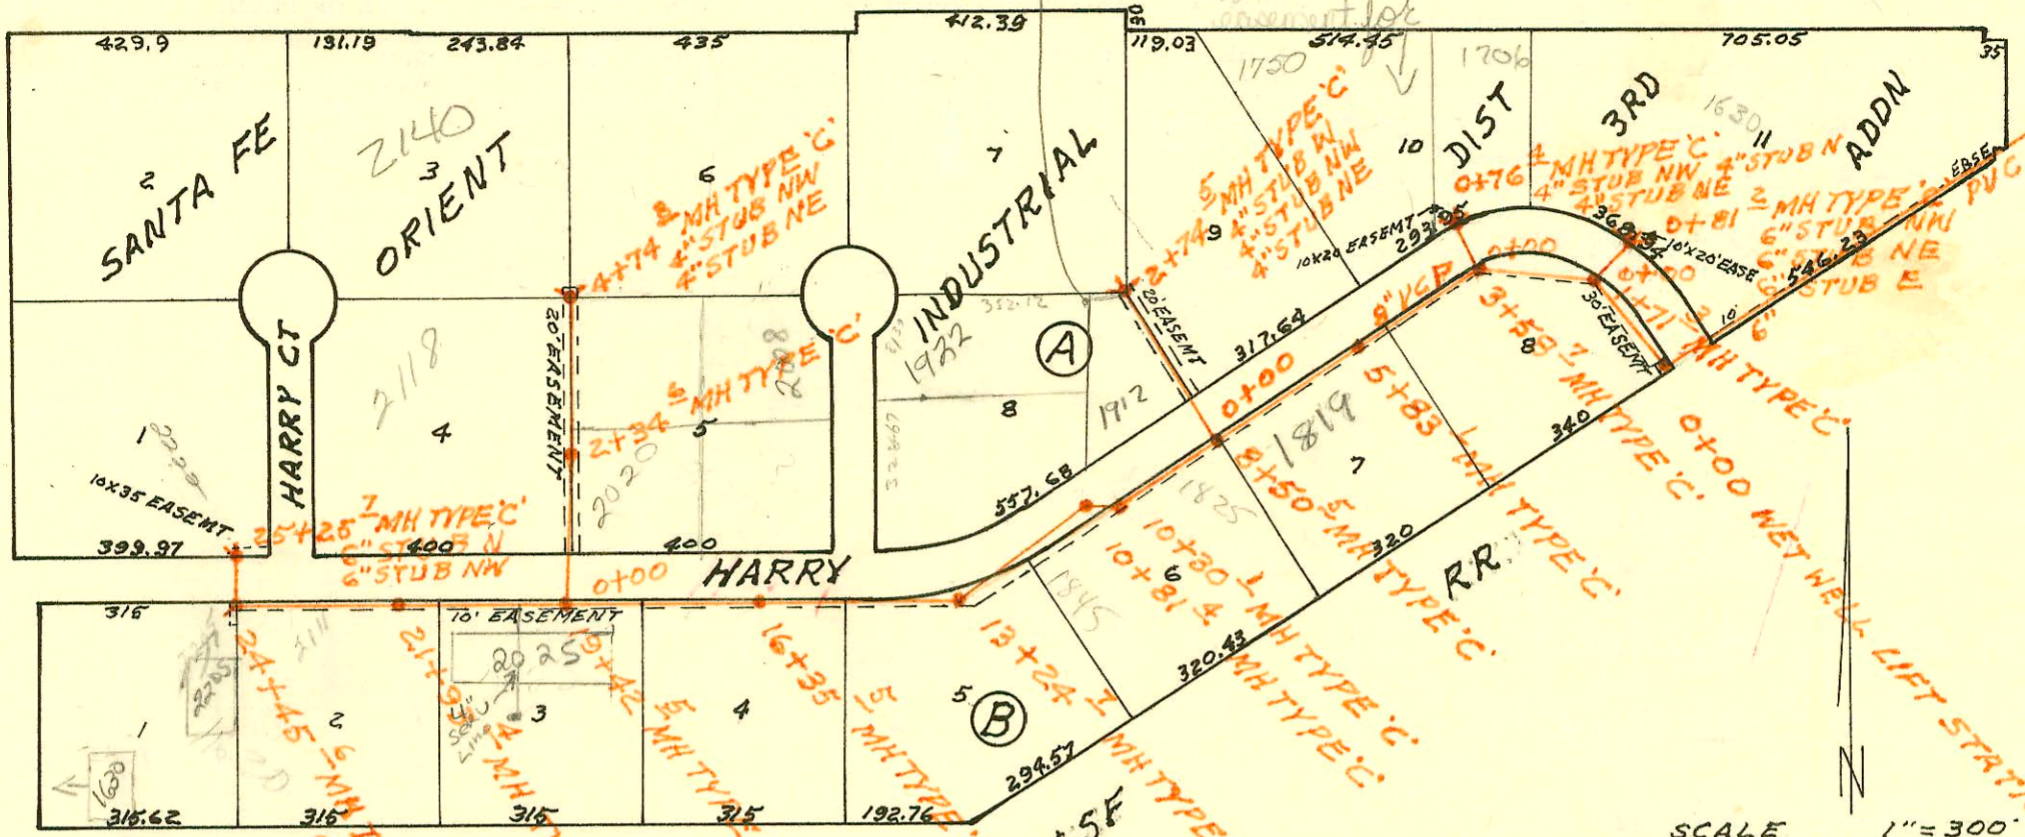

See P 226  
Map Main Fx  
P.M.S.  
C.O. & S.  
C.B.L.

LATERAL R SAN SEWER NO. 8  
 BUILT BY: UTILITY CONTR. INC.  
 PROJ. NO. 468-76-245-80673-000-000-001  
 BOOKED 8-23-80 FROM DCD 95  
 LATR SS NO. 8 FORCE MAIN  
 BOOKED 10-17-81 FROM KW #18  
 (SEE PAGE E272)

2-5-80

CONSTRUCTION RECORD

SERVICE RECORD

STATION	ELEVATION		Depth	MANHOLE	4-INCH "Y" BRANCHES		No. of Permit		House Number		DATE OF PERMITS	
	Ground	Grade			North West	South East	North West	South East	North West	South East	North West	South East
<b>LATERAL 6 MAIN 23 SAN SEWER N#22</b>												
0+00	102.0	90.62	11.4	EXISTING								
	102.5	90.71 90.81	11.8 11.7	0+29.1								
	102.4	90.92 91.02	11.5 11.4	0+65.7								
1+00	102.4	91.12	11.3		1+00.9		954		3203		8-12-80	
					1+12.7		5403		3209 S		3-22-82	
2+00	102.1	91.42	10.7		1+88.7		5557		3215 S		4-7-82	
3+00	101.9	91.72	10.2		NE side of MH tap		8003		3221		5-2-82	
	101.8	91.84	10.0	3+40.6	SE side of MH tap	23944	8002	3920	3227	9-25-84	5-2-83	
4+00	101.9	92.02	9.9		4+20.6		10579		3233 S		4-5-84	
					4+69.7 TAP		23523	5916 W	3239 S	7-12-89	3-22-82	
5+00	101.8	92.32	9.5		5+56.6 TAP		23522	3912 W	3245 S	7-12-89	8-10-80	
6+00	101.7	92.62	9.1		4" SDR 35		28141-17	3908-10	3251 S	7-29-91	8-12-80	
	101.7	92.65	9.1	6+11.1	6" O.D. 1 tap	4" STUB E	956	3212 W	3212 S		8-12-80	
						4" STUB S	956					
<b>LATERAL 17 MAIN 1 WESTLINK SAN</b>												
0+00	152.5	140.17	12.3	Begin Pipe								
	151.4	140.29 140.39	11.1 11.0	0+40.0								
1+00	152.6	140.59	12.0									
2+00	152.4	140.93	11.5									
3+00	152.5	141.27	11.2									
	153.4	141.53	11.9	3+75.6								
4+00	153.0	141.61	11.4									
5+00	153.5	141.95	11.6									
6+00	155.2	142.29	12.9									
7+00	156.2	142.63	13.6									
	154.5	142.67	11.8	7+10.0		6" STUB E			400 Woodchuck			
									50' below			
<b>LAT R 55 N# 8 (CONT'D)</b>												
LINE 3 0+00	106.5	96.79	9.7	0+00=3+58.7								
	106.2	97.10	9.1	0+76.4	4" STUB N	4" STUB NE	12736		1706		12-11-84	
					4" STUB NW		16115		1750		4-17-86	
LINE 4 0+00	108.4	95.75	12.7	0+00=8+50.5								
1+00	107.3	96.15	11.2		CITY TAP	4" Predco 1 to 6 4" PVC	2003 00592		1912		3-7-03	
2+00	107.3	96.55	10.8									
	106.6	96.85	9.8	2+74.5	4" STUB W	4" STUB NE						
					4" STUB NW							
LINE 5 0+00	107.3	99.67	7.6	0+00=13+42.5								
1+00	107.3	99.97	7.3									
2+00	108.0	100.28	7.7									
	108.0	100.38	7.6	2+34.6								
3+00	107.9	100.58	7.3		4" ABS 40		11209		2118 W		7-9-85	
					2+216.6 tap							
4+00	107.1	100.88	6.2					99-68837	2020 B		4-16-89	
	106.7	101.10	5.6	4+74.8	4" STUB NW	4" STUB NE	2000 02606	16217	2140	W Harry Ct	11-29-00	8-8-86

400 N Woodchuck - Levy school - NO orig. Record of com for school  
 Set 2001 03056 11/30/01 400 N Woodchuck - Roof P/b (Bldg add)