


DOOLEY (VAC)

ELIZABETH (VAC)

ST CLAIR

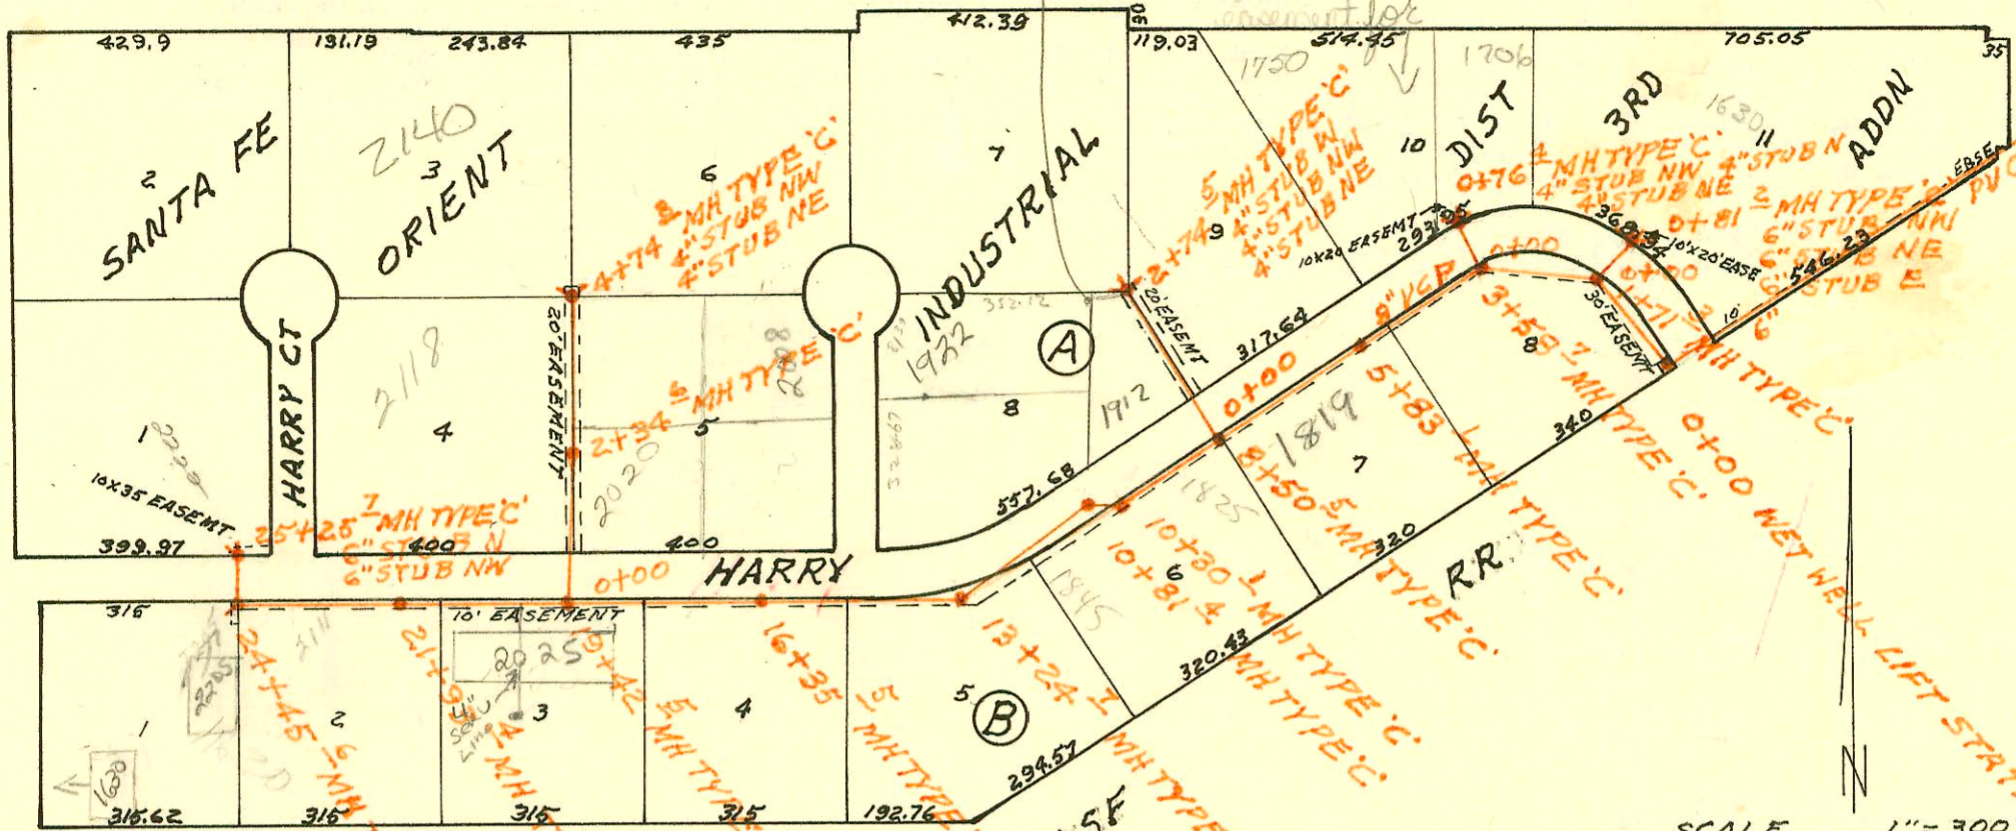

SCALE 1" = 300'

LATERAL R SAN SEWER N<sup>o</sup> 8  
 BUILT BY: UTILITY CONTR. INC.  
 PROJ. N<sup>o</sup> 468-76-245-80673-000-000-001  
 BOOKED 8-23-80 FROM DCD 95  
 LAT R SS N<sup>o</sup> 8 FORCE MAIN  
 BOOKED 10-17-81 FROM KW #18  
 (SEE PAGE E272)

See P. 226  
 Prop. Main Ext.  
 P. 1115  
 Corner  
 BK

Point  
 Assent lot

8-5-80

CONSTRUCTION RECORD

SERVICE RECORD

| STATION                  | ELEVATION |        | Depth | MANHOLE              | 4-INCH "Y" BRANCHES        |            | No. of Permit |            | House Number                   |            | DATE OF PERMITS |            |
|--------------------------|-----------|--------|-------|----------------------|----------------------------|------------|---------------|------------|--------------------------------|------------|-----------------|------------|
|                          | Ground    | Grade  |       |                      | North West                 | South East | North West    | South East | North West                     | South East | North West      | South East |
| LATERAL R SAN SEWER No 8 |           |        |       |                      |                            |            |               |            |                                |            |                 |            |
| LINE 1 0+00              | 108.2     | 92.90  | 15.3  | LIFT STATION         |                            |            |               |            |                                |            |                 |            |
| 1+00                     | 104.7     | 93.20  | 11.5  |                      |                            |            |               |            |                                |            |                 |            |
|                          | 106.3     | 93.42  | 12.9  | 1+71.3               |                            |            |               |            |                                |            |                 |            |
|                          |           | 93.52  | 12.8  |                      |                            |            |               |            |                                |            |                 |            |
| 2+00                     | 106.1     | 93.60  | 12.5  |                      |                            |            |               |            |                                |            |                 |            |
| 3+00                     | 107.5     | 93.90  | 13.6  |                      |                            |            |               |            |                                |            |                 |            |
|                          | 106.5     | 94.08  | 12.7  | 3+58.7               |                            |            |               |            |                                |            |                 |            |
|                          |           | 94.18  | 12.3  |                      |                            |            |               |            |                                |            |                 |            |
| 4+00                     | 107.7     | 94.30  | 13.4  |                      |                            |            |               |            |                                |            |                 |            |
| 5+00                     | 107.5     | 94.60  | 12.9  |                      |                            |            |               |            |                                |            |                 |            |
|                          | 107.4     | 94.85  | 12.6  | 5+83.1               |                            |            |               |            |                                |            |                 |            |
|                          |           | 94.95  | 12.5  |                      |                            |            |               | 97-35707   | 1819 HARRY                     |            | 3-10-97         |            |
| 6+00                     | 107.7     | 94.99  | 12.7  |                      |                            |            |               |            |                                |            |                 |            |
| 7+00                     | 108.3     | 95.25  | 13.1  |                      |                            |            |               |            |                                |            |                 |            |
| 8+00                     | 108.0     | 95.50  | 12.5  |                      |                            |            |               |            |                                |            |                 |            |
|                          | 108.4     | 95.63  | 12.8  | 8+50.5               |                            |            |               |            |                                |            |                 |            |
|                          |           | 95.73  | 12.7  |                      |                            |            |               |            |                                |            |                 |            |
| 9+00                     | 108.1     | 95.85  | 12.3  |                      |                            |            |               |            |                                |            |                 |            |
|                          |           |        |       |                      | 9+16.9                     |            |               | 7344       | 1825 W HARRY                   |            | 1-11-83         |            |
| 10+00                    | 107.7     | 96.10  | 11.6  |                      |                            |            |               |            |                                |            |                 |            |
|                          | 107.6     | 96.18  | 11.4  | 10+30.1              | 4" SCH 40 CITY 10+20.1 Tap |            |               | 2003 0981  | 1825 W HARRY (OPERA AT TRACKS) |            | 4-15-83         |            |
|                          |           | 96.28  | 11.3  |                      |                            |            |               |            |                                |            |                 |            |
|                          | 108.6     | 96.41  | 12.2  | 10+81.4              |                            |            |               |            |                                |            |                 |            |
|                          |           | 96.51  | 12.1  |                      |                            |            |               |            |                                |            |                 |            |
| 11+00                    | 107.7     | 96.56  | 11.1  |                      |                            |            |               |            |                                |            |                 |            |
| 12+00                    | 108.0     | 96.81  | 11.2  |                      |                            |            |               |            |                                |            |                 |            |
| 13+00                    | 108.0     | 97.07  | 10.9  |                      |                            |            |               |            |                                |            |                 |            |
|                          | 107.9     | 97.13  | 10.8  | 13+24.7              |                            |            |               |            |                                |            |                 |            |
|                          |           | 97.23  | 10.7  |                      |                            |            |               |            |                                |            |                 |            |
| 14+00                    | 108.0     | 97.53  | 10.5  |                      |                            |            |               |            |                                |            |                 |            |
| 15+00                    | 107.7     | 97.92  | 9.8   |                      |                            |            |               |            |                                |            |                 |            |
| 16+00                    | 108.0     | 98.32  | 9.7   |                      |                            |            |               |            |                                |            |                 |            |
|                          | 108.2     | 98.46  | 9.7   | 16+35.5              |                            |            |               |            |                                |            |                 |            |
| 17+00                    | 107.9     | 98.71  | 9.2   |                      |                            |            |               |            |                                |            |                 |            |
| 18+00                    | 107.3     | 99.11  | 8.2   |                      |                            |            |               |            |                                |            |                 |            |
| 19+00                    | 107.8     | 99.50  | 8.3   |                      |                            |            |               |            |                                |            |                 |            |
|                          | 107.3     | 99.67  | 7.6   | 19+42.5              | 4" SCH 40 CITY 19+70.5 TAP |            |               | 2000-02555 | 2025 W HARRY                   |            | 11-21-80        |            |
| 20+00                    | 107.8     | 99.90  | 7.9   |                      |                            |            |               |            |                                |            |                 |            |
| 21+00                    | 107.3     | 100.30 | 7.0   |                      |                            |            |               |            |                                |            |                 |            |
|                          | 107.6     | 100.67 | 6.9   | 21+93.4              |                            |            |               |            |                                |            |                 |            |
| 22+00                    | 107.3     | 100.70 | 6.6   |                      |                            |            |               |            |                                |            |                 |            |
|                          |           |        |       |                      | 22+23.0 Tap                |            |               | 4114       | 2111 W HARRY                   |            | 9-14-81         |            |
|                          |           |        |       |                      | 22+74.4 Tap                |            |               | 12129      | 2111 W HARRY                   |            | 7-28-84         |            |
| 23+00                    | 108.0     | 101.10 | 6.9   |                      |                            |            |               |            |                                |            |                 |            |
| 24+00                    | 108.2     | 101.50 | 6.7   |                      |                            |            |               |            |                                |            |                 |            |
|                          | 108.4     | 101.69 | 6.7   | 24+45.6              | 24+28.6 Tap                |            |               | 7-17-87    | 1630 SR St Clair               |            | 9-30-97         |            |
|                          |           | 101.79 | 6.6   |                      | 6" stub SW                 |            |               | 4222       | 2705 W HARRY                   |            | 10-1-81         |            |
|                          |           |        |       |                      |                            |            |               | 4115       |                                |            | 9-11-81         |            |
| 25+00                    | 108.4     | 102.01 | 6.4   |                      |                            |            |               |            |                                |            |                 |            |
|                          | 108.4     | 102.11 | 6.3   | 25+25.7              | 6" STUB N                  |            |               | 5130       | 2222 W HARRY                   |            | 1-7-82          |            |
|                          |           |        |       |                      | 6" STUB NW                 |            |               |            |                                |            |                 |            |
| LINE 2 0+00              | 106.3     | 93.52  | 12.8  | 0+00 = 1+71.3 LINE 1 |                            |            |               |            |                                |            |                 |            |
|                          | 107.0     | 93.84  | 13.2  | 0+81.2               | 6" STUB NW                 |            |               | 274109     | 1630 W HARRY                   |            | 9-5-79          |            |
|                          |           |        |       |                      | 6" STUB E                  |            |               |            |                                |            |                 |            |
|                          |           |        |       |                      | 6" STUB NE                 |            |               |            |                                |            |                 |            |

CONTD ON PREVIOUS PAGE

C-72687 - 1814 W HARRY - 8-17-79 - Don Coleman 50.8E of MN? (Do not show an 1814 W HARRY)