


MAIN 7 SOUTHWEST INTERCEPTOR SEWER
 BUILT BY: UTILITY CONTR. INC.
 PROJ. No 468-76-245-80229-000-000-001
 BOOKED 8-23-80 FROM GB

on map

E281A

31ST ST

SCALE 1" = 300'

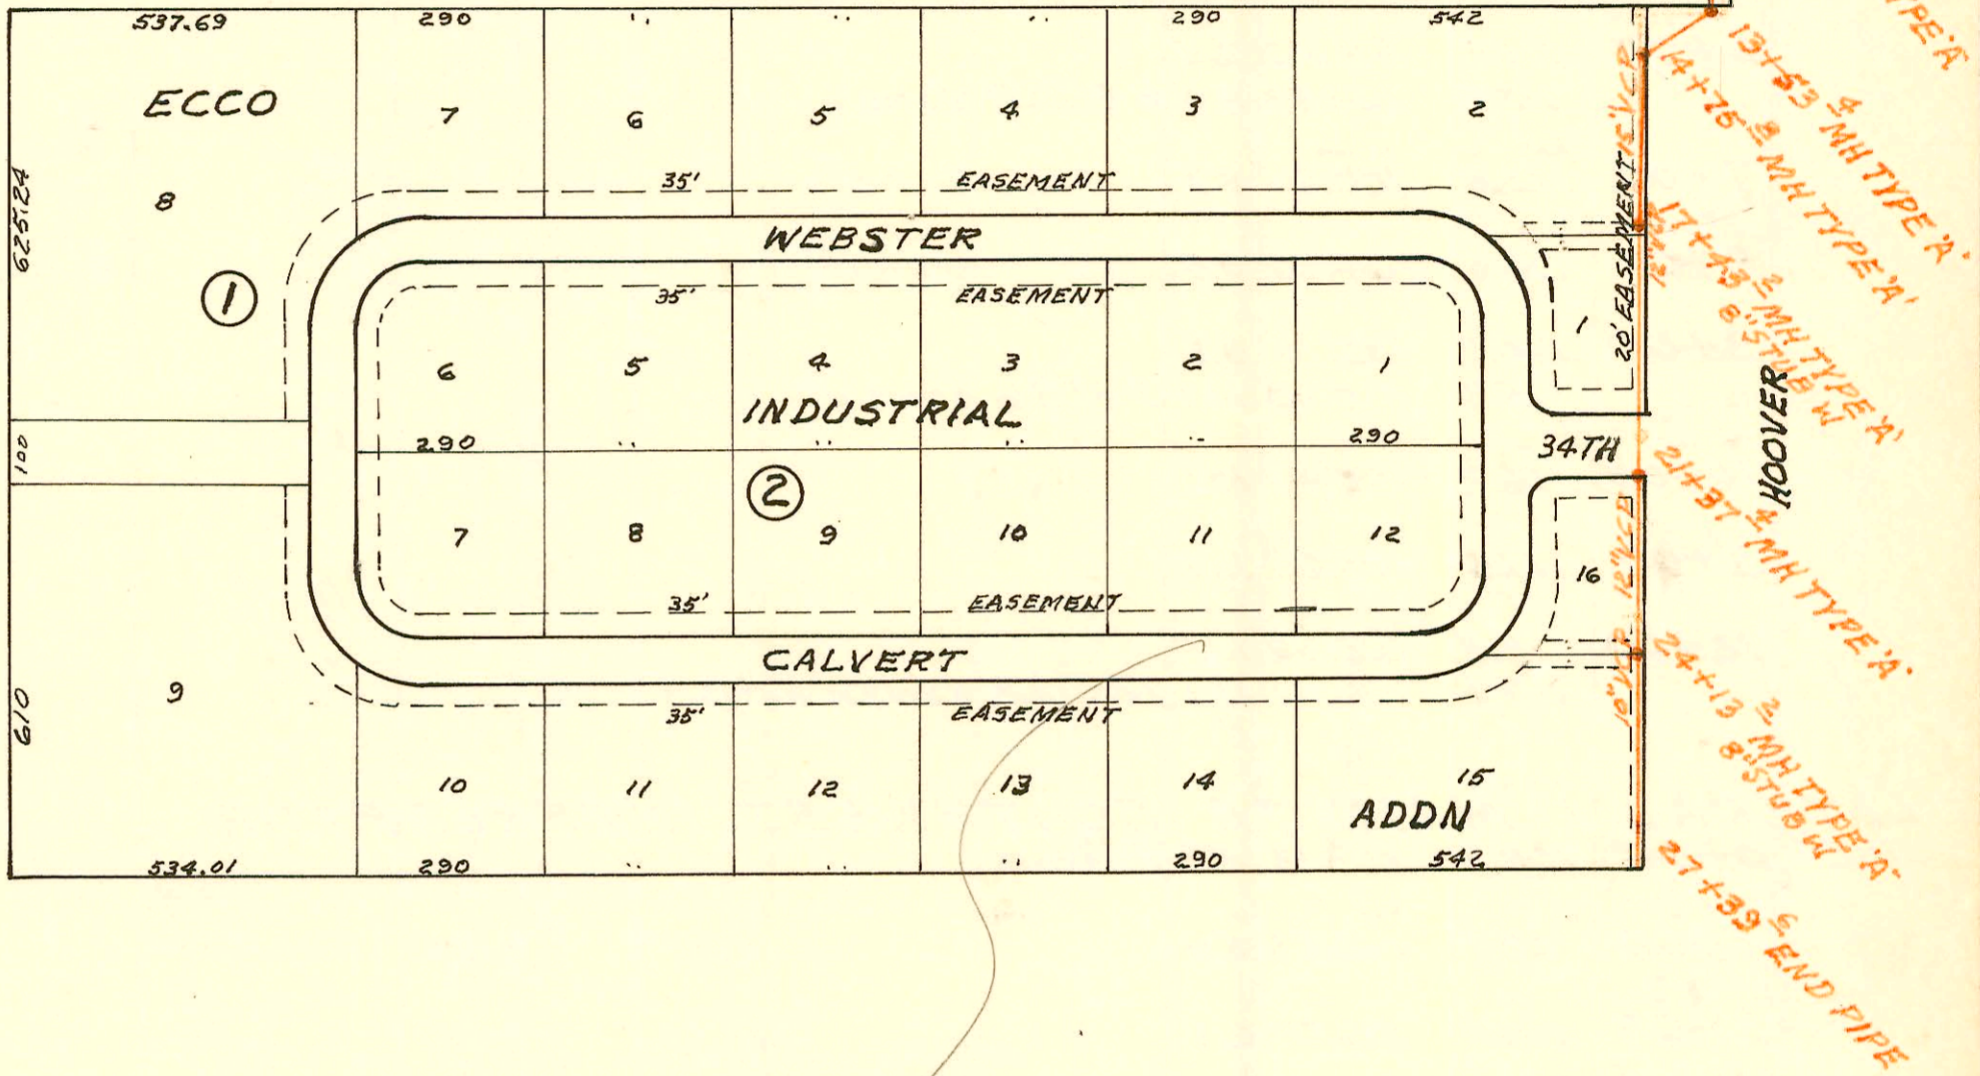

9/28/06
 Replattins into
 one large lot -
 lateral sewer & water
 to be extended off
 Main to serve lot
 Do not allow bidg connections
 to Main ^
 9/28/06
 BK

