


SCALE 1" = 150'

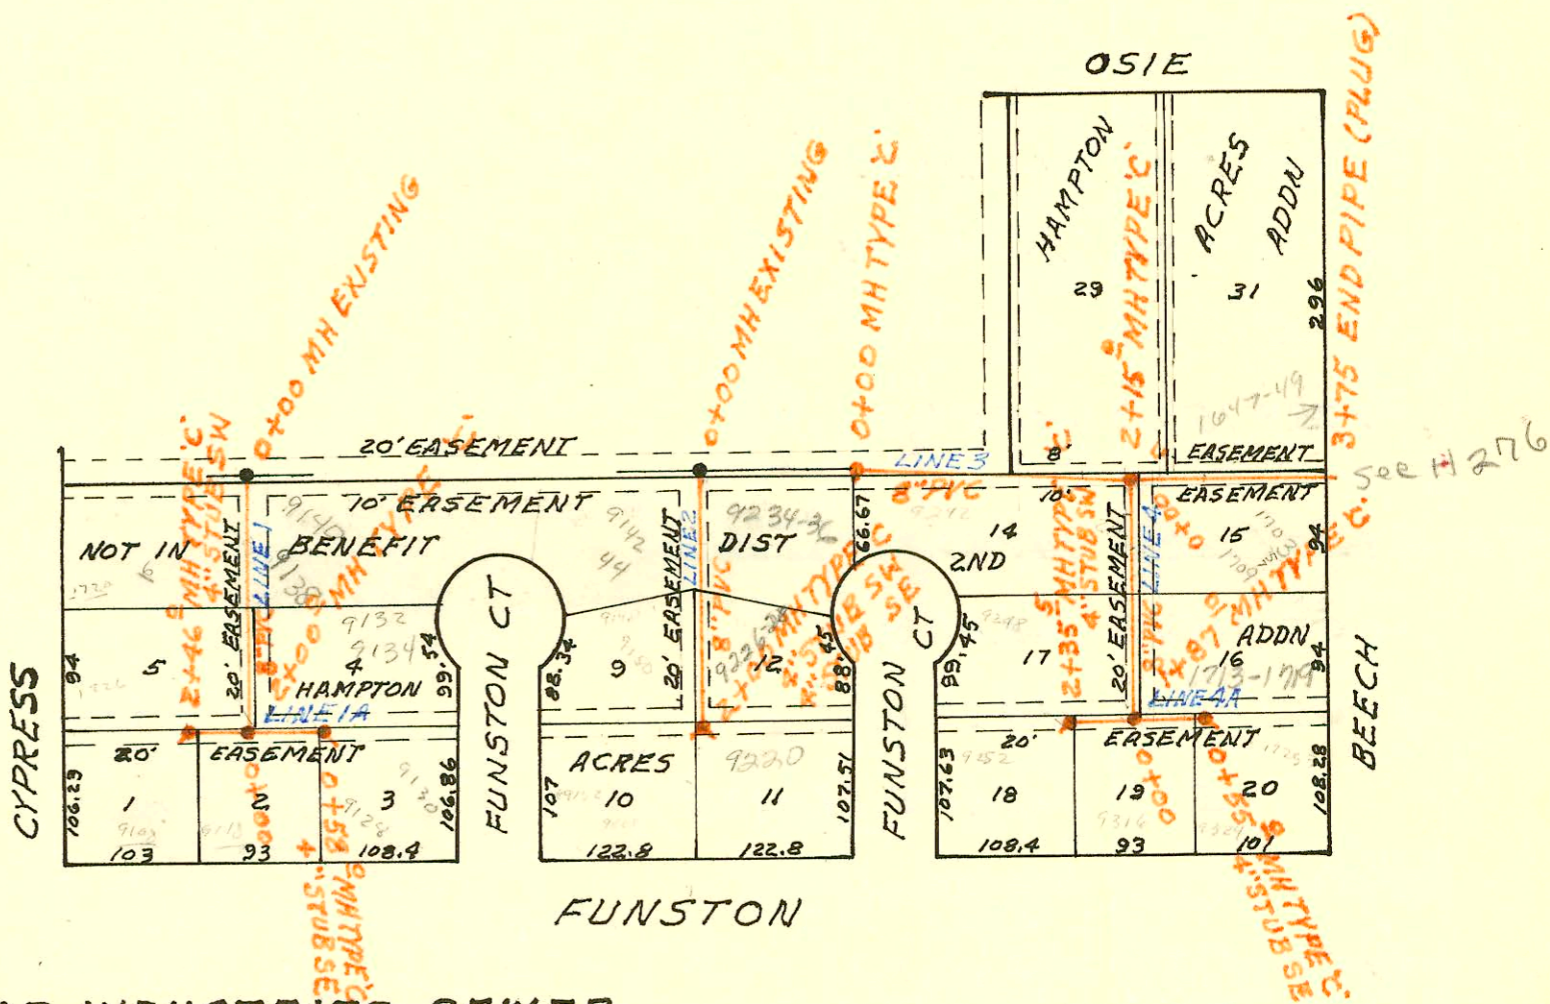

LATERAL 9 MAIN 19 WAR INDUSTRIES SEWER  
 BUILT BY: ARKANSAS CONST. CO.  
 PROJ. NO 468-76-245-80831-000-000-001  
 BOOKED 9-13-80 FROM SRL 1

19-61

CONSTRUCTION RECORD

SERVICE RECORD

STATION	ELEVATION		Depth	MANHOLE	4-INCH "Y" BRANCHES		No. of Permit		House Number		DATE OF PERMITS	
	Ground	Grade			North West	South East	North West	South East	North West	South East	North West	South East
<b>LAT 34 MAIN 4 SWI (CONT'D)</b>												
LINE 8 0+00	150.5	138.04	12.5	EXISTING								
1+00	148.8	138.44	10.4				17700		7722			3-10-87
	148.0	138.58	9.4	1+33.4	4" STUB S		19789	19679	160 N Mainfield	150 N Mainfield		2-11-87
<b>LATERAL 9 MAIN 19 WAR INDUSTRIES SEWER</b>												
LINE 1 0+00	169.4	161.14	8.3	EXISTING			11569	6386	1720 Cypress	9138 Junston		7-27-84
1+00	169.6	161.54	8.1									8-20-82
2+00	169.6	161.94	7.7	2+00.0			12214	9533	1736 Cypress	9132 E Junston		10-11-84
	169.6	162.22	7.4	2+46.0	4" STUB SW			11559		9108 E Junston		7-24-84
LINE 1A 0+00	169.6	162.04	7.6	EXISTING			11558			9118 Junston		7-24-84
	169.7	162.27	7.4	0+58.0	4" STUB SE			9490		9128-30 Junston		10-24-83
<b>LINE 2</b>												
0+00	170.7	162.07	8.6	EXISTING			9597		9142 Junston			11-3-82
1+00	170.8	162.47	8.3				9596	19450	9144 Junston	9234-36 Junston		11-3-83
	171.2	162.87	8.3	2+00.0	4" STUB SW 4" STUB SE		11233	19308	9148 E Junston	9288 E Junston		6-20-84
							11234	19261	9150 E Junston	9226 Junston		6-20-84
							11986	2396	9204-9152 Junston	9220 E Junston		9-11-84
<b>LINE 3</b>												
0+00	171.3	162.44	8.9	0+00								
1+00	172.0	162.84	9.2									
2+00	172.7	163.24	9.5									
	173.1	163.30	9.8	2+15.0			15323		9225 Beech			12-27-85
							15322		1647-9 Beech			12-27-85
3+00		163.64										
3+75		163.94										
<b>LINE 4</b>												
0+00	173.1	163.40	9.7	EXISTING			11046		9242 #5 Junston			5-29-84
1+00	173.2	163.80	9.4					8611		1703-5-7 Beech		7-5-83
	173.5	164.15	9.4	1+87.0			11697		9248 #4 Junston	1317-179 Beech		4-13-82
		164.25	9.3									5-29-84
2+00	173.3	164.30	9.0					11050		9316-1-4 Junston		5-30-84
	173.2	164.44	8.8	2+35.5	4" STUB SW		11048		9252 Junston			5-29-84
<b>LINE 4A</b>												
0+00	173.5	164.25	9.3	EXISTING								
	173.7	164.47	9.2	0+55.0	4" STUB SW			11010		9324 Junston		5-29-84
<b>LATERAL 6 MAIN 10 SOUTHWEST INTERCEPTOR</b>												
LINE 1 0+00	153.6	141.80	11.8									
1+00	153.3	142.40	10.9				1700.9	073976		11204 W. Jennie		8-29-79
2+00	153.6	143.00	10.6				1771.5	073975		11210 W. Jennie		8-29-79
	153.3	143.60	9.7	3+00.5			2+96.5	073974		11228 W. Jennie		8-29-79
4+00	153.7	144.20	9.5					073973		11308 Jennie		8-29-79
5+00	154.2	144.80	9.4				4+34.6	073971		11314 Jennie		8-29-79
	154.5	145.40	9.1	6+00.5			5+06.6	073972		11322 Jennie		8-29-79
							5+53.4	073977		11404 Jennie		8-29-79
							6+59.8	073970		11412 Jennie		8-29-79
7+00	155.8	146.00	9.8				6+91.6					
8+00	157.3	146.60	10.7				7+99.9	073968		11418 Jennie		8-29-79
	159.2	147.15	12.1	8+91.3			8+46.7	073969		11504 Jennie		8-29-79

CONT'D NEXT PAGE