

SCALE 1" = 200'

LATERAL 6 MAIN 10 SOUTHWEST INTERCEPTOR SEWER  
 BUILT BY: MID STATES CONST. CO.  
 PROJ. NO 468-76-245-80722-000-000-001  
 BOOKED 9-25-80 FROM LES 22

See G-297  
 for line ext.


CONSTRUCTION RECORD

SERVICE RECORD

STATION	ELEVATION		Depth	MANHOLE	4-INCH "Y" BRANCHES		No. of Permit		House Number		DATE OF PERMITS	
	Ground	Grade			North West	South East	North West	South East	North West	South East	North West	South East
LAT 6 MAIN 10 SWI CONT'D												
LINE 3A CONT'D	3+00	152.7 152.9	142.28 142.49	10.4 10.4	3+24.3	4" STUB NW	4" STUB NE	175295	175523	638 N Covington	625 Shefford	11-9-79 11-29-79
LINE 3B	0+00	154.5	141.63	12.9	0+00=11+16.2 LINE 3	0+22.1		1129		526 Covington		9-4-80
	1+00	154.2	142.03	12.2		0+60.5	0+96.8	1045	1779	522 Covington	533 Langdon	8-22-80 11-7-80
	2+00	154.0	142.43	11.6		2+06.7	1+97.4	1046	1778	518 Covington	519 N. Covington	8-22-80 11-7-80
	3+00	154.0	143.03	11.0		2+88.2	3+30.5	1047	2548	512 Covington	11416 Hardtner	8-22-80 2-4-81
		154.0	143.63	10.4		3+79.6	4" STUB SW	1048	1050	508 Covington	502 Covington	8-22-80 8-22-80
LINE 3C	0+00	154.2	142.96	11.2	0+00=2+80.5 LINE 3B							
	1+00	153.5	143.36	10.1		1+29.6	1+48.1	1777	12829	613 Covington	11410 Hardtner	11-7-80 3-12-81
		153.5	143.72	9.8		1+89.6	4" STUB NE	1776	1775	509 N. Covington	503 N. Covington	11-7-80 11-7-80
LINE 3D	0+00	155.3	142.96	12.3	0+00=14+00.2 LINE 3							
	1+00	154.0	143.36	10.6		0+62.0		2335		11405 Taylor	627 N. Covington	1-12-81 4-29-81
		153.5	143.76	9.7		1+36.9	1+84.6	2336	1786	11323 Taylor	635 N. Covington	1-12-81 12-31-81
LINE 4	0+00	150.6	133.82	16.8	0+00=1+08.4 LINE 3							
	1+00	148.6	134.12	14.5		1+00.0	4" STUB E	2550			434 N. Shefford	2-4-81
	2+00	149.6	134.52	15.1		4" RISER 2+74 N	4" RISER 2+71 S	3431	2552	11305 Hardtner	11304 W 3rd St	6-4-81 2-4-81
	3+00	149.8	134.82	15.0		3+73.9	4" STUB N	3253	99-0096	11311 Hardtner	11310 W 3rd St	seen next 5-6-81 2-4-81
	4+00	150.0	135.12	14.9		4" RISER 4+21 N	4" RISER 4+18 S	3627	3681	11319 Hardtner	11318 W. 3rd	7-7-81 7-15-81
	5+00	150.5	135.42	15.1		5+63.9	4" STUB NE	3206	3582	11409 Hardtner	11403 Hardtner	4-28-81 7-1-81
	6+00	151.9	135.83	16.1		6+64.9	4" STUB NE	3845	3467	11415 Hardtner	11410 W 3rd	8-19-83 8-19-83
	7+00	152.7	136.23	16.5								
	8+00	153.0	136.53	16.5		8+09.9	4" STUB NE	3363	3837	11425 Hardtner	11426 W 3rd	5-27-81 8-5-81
		153.6	136.88	16.7		8+83.2	4" STUB NW					
	9+00	153.6	137.03	16.6		9+91.6	8" STUB SE					
	10+00	154.0	142.39	11.6		10+71.7	8" STUB SW		5144		421 N. Covington	2-1-82
	11+00	155.0	142.99	12.0		11+52.2						
	12+00	156.6	143.59	13.0		12+57.8		1374			11504 Hardtner	9-29-80
	13+00	158.0	144.19	13.8		13+41.8		2191	3557	424 N. Parkside	503 N. Covington	12-22-80 2-4-81
	14+00	158.9	144.59	14.3		13+21.3		8014	3534	425 N. Parkside	507 N. Covington	5-2-83 6-18-81

CONT'D NEXT PAGE

519 N. Covington 3-10-82 Gerald Thompson

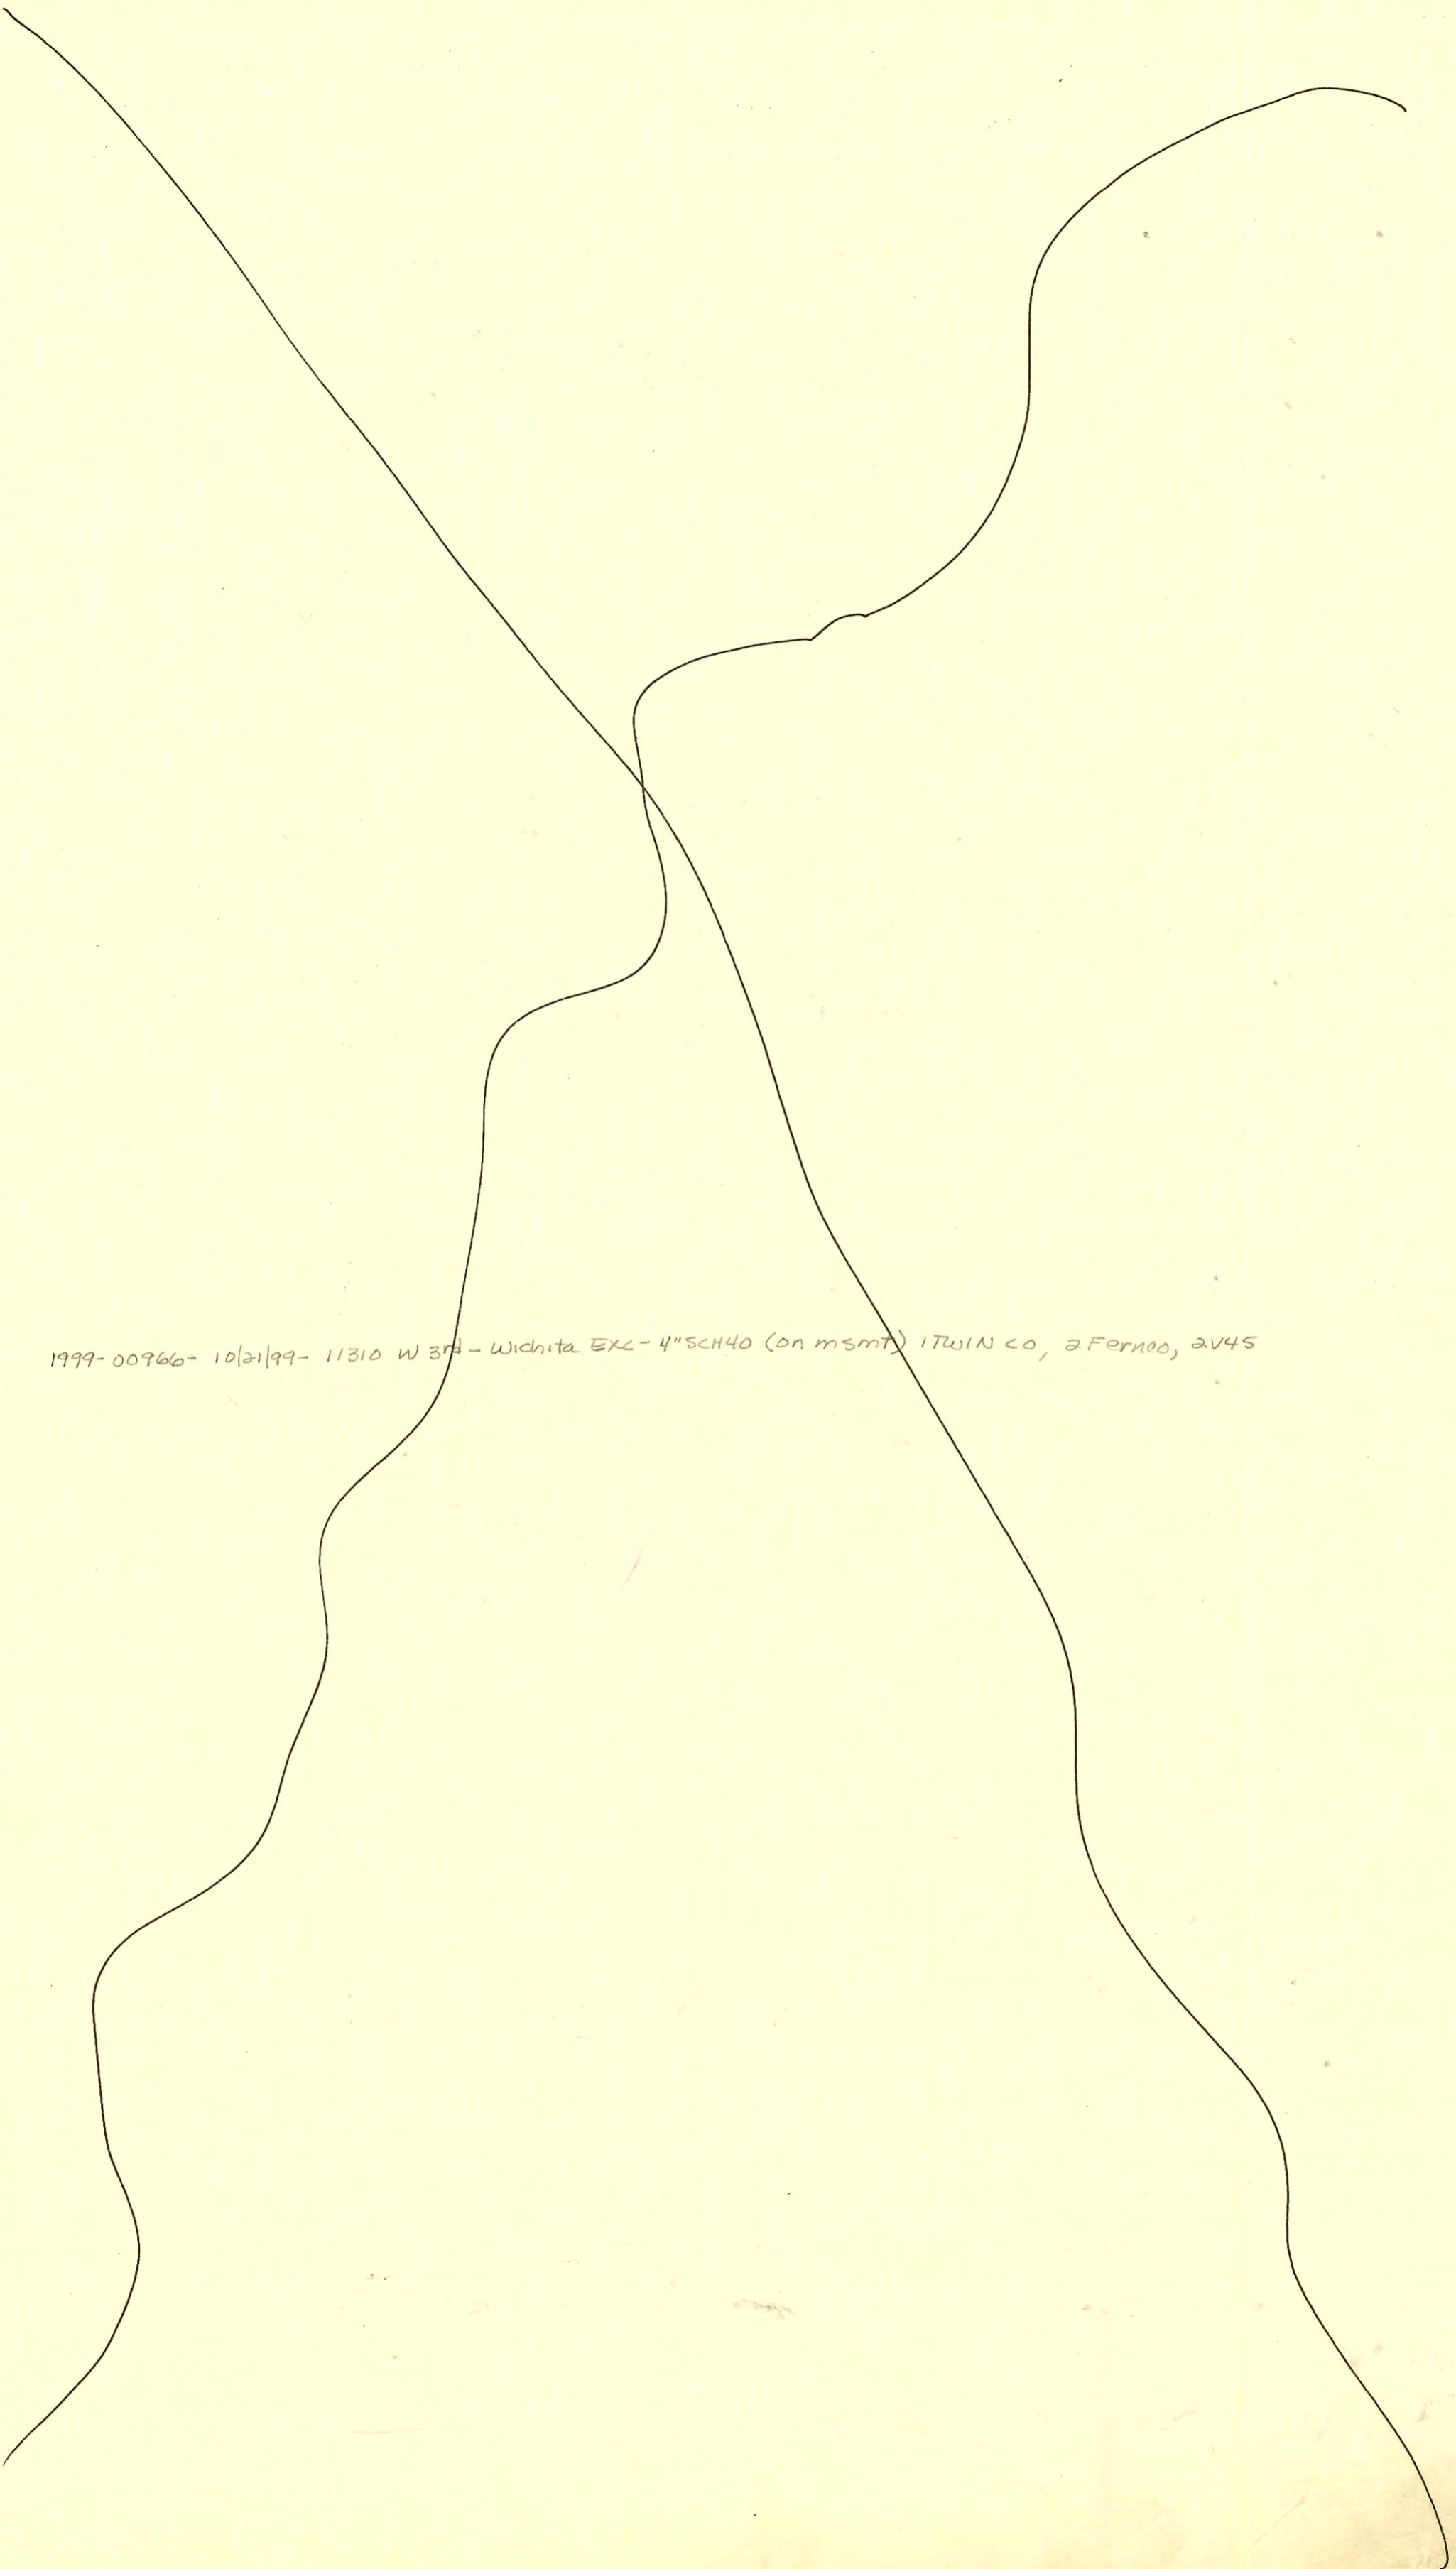

1999-00966- 10/21/99- 11310 W 3<sup>rd</sup> - Wichita EXC - 4" SCH 40 (on msmt) ITWIN CO, a Fernco, av45