



LATERAL I MAIN 22 WAR INDUSTRIES SEWER
 BUILT BY: WB CARTER CONST. CO.
 PROJ. No 468-76-245-80594-000-000-001
 BOOKED 9-27-80 FROM MRT 19

map

SCALE 1" = 150'



P 12-39

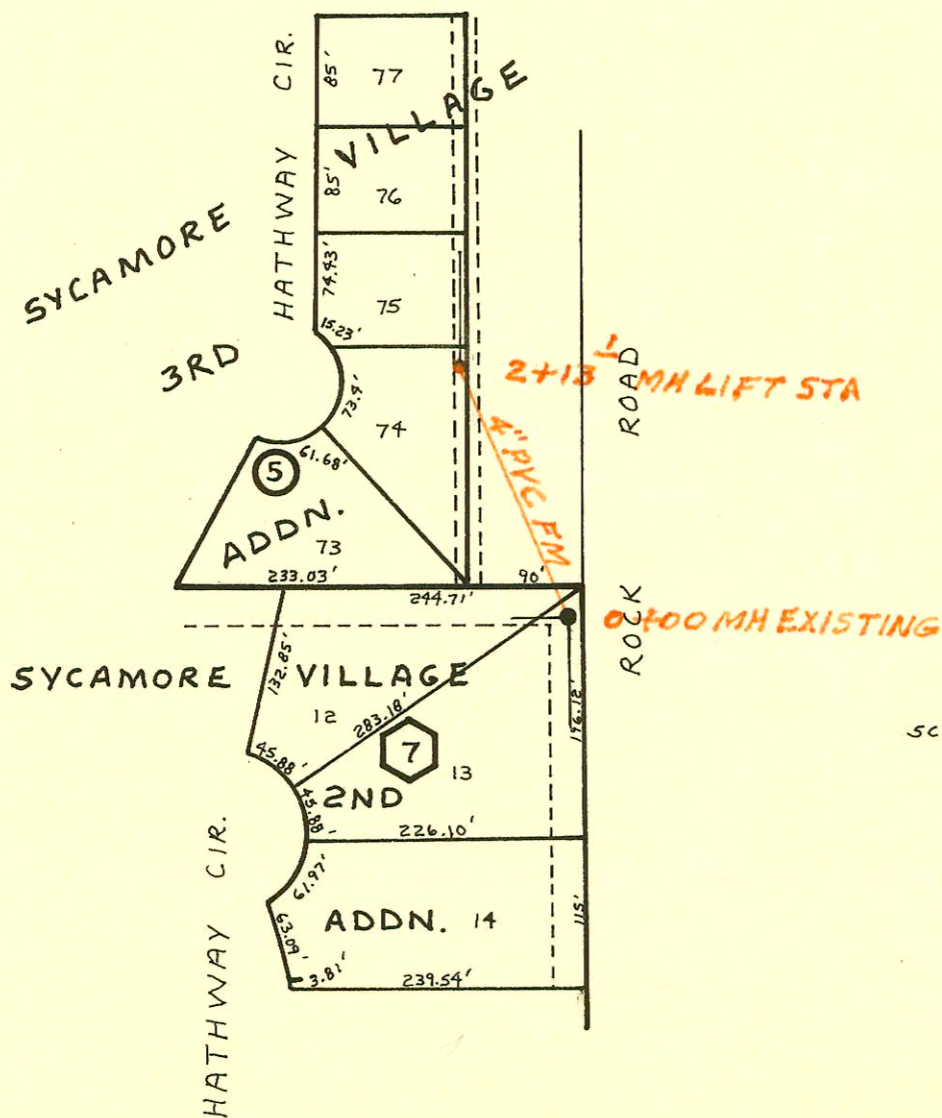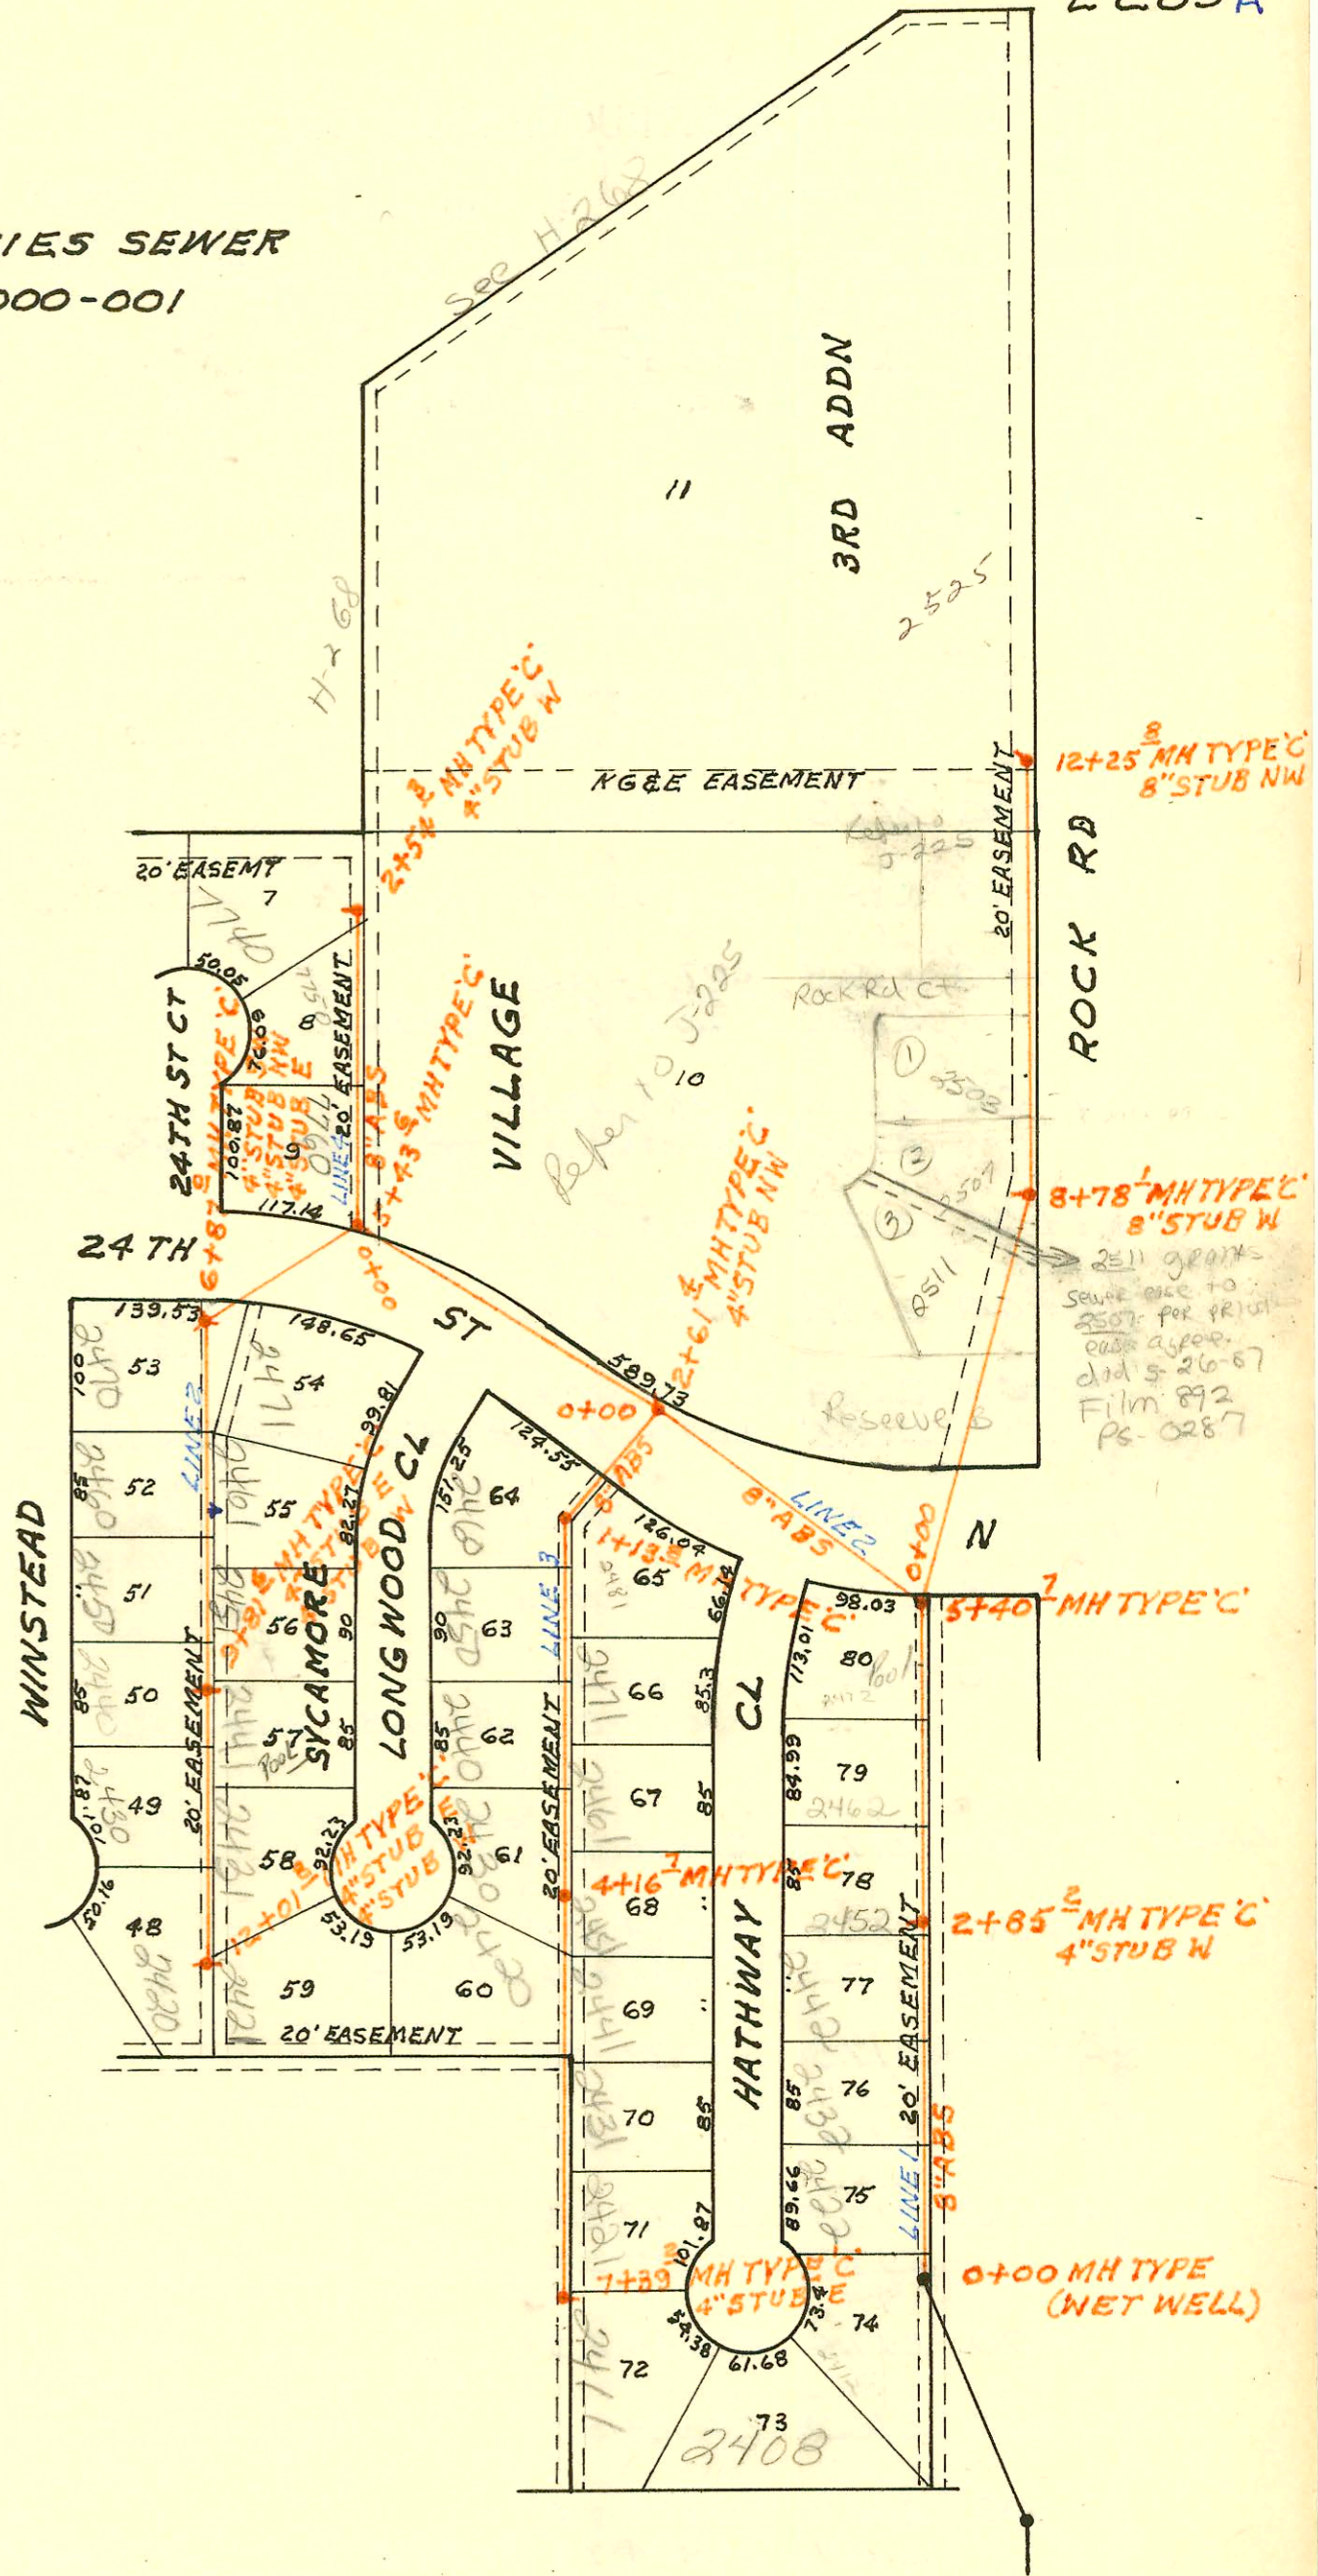

SCALE 1" = 150'

SYCAMORE VILLAGE 3RD ADDN FORCE MAIN
 BUILT BY: UTILITY CONTR. INC.
 PROJ. No 468-76-245-80766-000-000-008
 BOOKED 3-16-82 FROM DCD 197

CONSTRUCTION RECORD

SERVICE RECORD

STATION	ELEVATION		Depth	MANHOLE	4-INCH "Y" BRANCHES		No. of Permit		House Number		DATE OF PERMITS		
	Ground	Grade			North West	South East	North West	South East	North West	South East	North West	South East	
LAT 1 MAIN 22 WIS CONT'D													
LINE 1 CONT'D	12+00	220.2	212.33	7.9									
		220.3	212.40	7.8	12+25.8	8" STUB NW		#4185		2525 N. 32 nd Rock Rd. (Below)		9-24-81	
LINE 2													
	0+00	216.0	205.24	10.8	0+00=5+40.7								
	1+00	215.6	205.63	10.0									
	2+00	216.4	206.02	10.4									
		217.0	206.38	10.6	2+61.4	4" STUB NW							
	3+00	217.6	206.53	11.1									
	4+00	218.7	206.93	11.8									
	5+00	219.8	207.32	12.5									
		218.0	207.59	10.4	5+43.6								
	6+00	220.0	207.81	12.2									
		219.8	208.26	11.5	6+87.0	4" STUB NW	4" STUB E						
	7+00	219.5	208.31	10.8				224		2471 Longwood		5-6-80	
	8+00	219.4	208.71	10.7				C75606		2470 Windstead		12-5-79	
	9+00	219.4	209.11	10.3				C75471		2460 Windstead		11-26-79	
		219.5	209.44	10.1	9+81.6	4" STUB W	4" STUB E	C75410	C75736	2450 Windstead	2461 Longwood	11-20-79	5-20-80
	10+00	219.7	209.50	10.2				C75737		2446 Windstead	2451 Longwood	12-17-79	
	11+00	219.9	209.85	10.1				C75456		2430 Windstead		11-26-79	
	12+00	219.0	210.19	8.8				C75605		2441 Longwood		12-5-79	
		219.0	210.20	8.8	12+01.8	4" STUB W	4" STUB E	C77062		2431 Longwood		3-28-80	
LINE 3													
	0+00	217.0	206.38	10.6	0+00=2+61.4								
	1+00	217.3	206.78	10.5									
		217.3	206.94	10.4	1+13.8			C77005		2460 Longwood		3-25-80	
	2+00	217.3	207.28	10.0									
	3+00	217.5	207.68	9.8									
	4+00	217.5	208.08	9.4									
		217.5	208.15	9.4	4+16.8			C75470	C75577	2430 Longwood	2441 Hathway	11-26-79	12-3-79
	5+00	217.4	208.48	8.9									
	6+00	216.9	208.88	8.0									
	7+00	216.7	209.28	7.4									
		216.7	209.44	7.3	7+39.2								
LINE 4													
	0+00	218.0	210.00	8.0	0+00=5+43.6								
	1+00	221.7	211.20	10.5									
	2+00	222.9	212.40	10.5									
		223.7	213.05	10.7	2+54.3	4" STUB W		1055		7760 E 244 St. Ct.		8-22-80	
SYCAMORE VILLAGE 3RD ADDN FORCE MAIN													
	0+00	213.9	209.92	4.0	0+00 EXISTING								
		215.5	207.73	7.8	2+13.1	LIFT STA		4000		7750 E 244 St. Ct.		8-26-81	
								1044		7740 E 244 St. Ct.		8-22-80	

95-75757 5-22-95 2525 N Rock Rd - Bldg addition - 4" PVC 40 tied into exist 4" SOR 35 Bldg Line just south of CleanOut

E290A

