
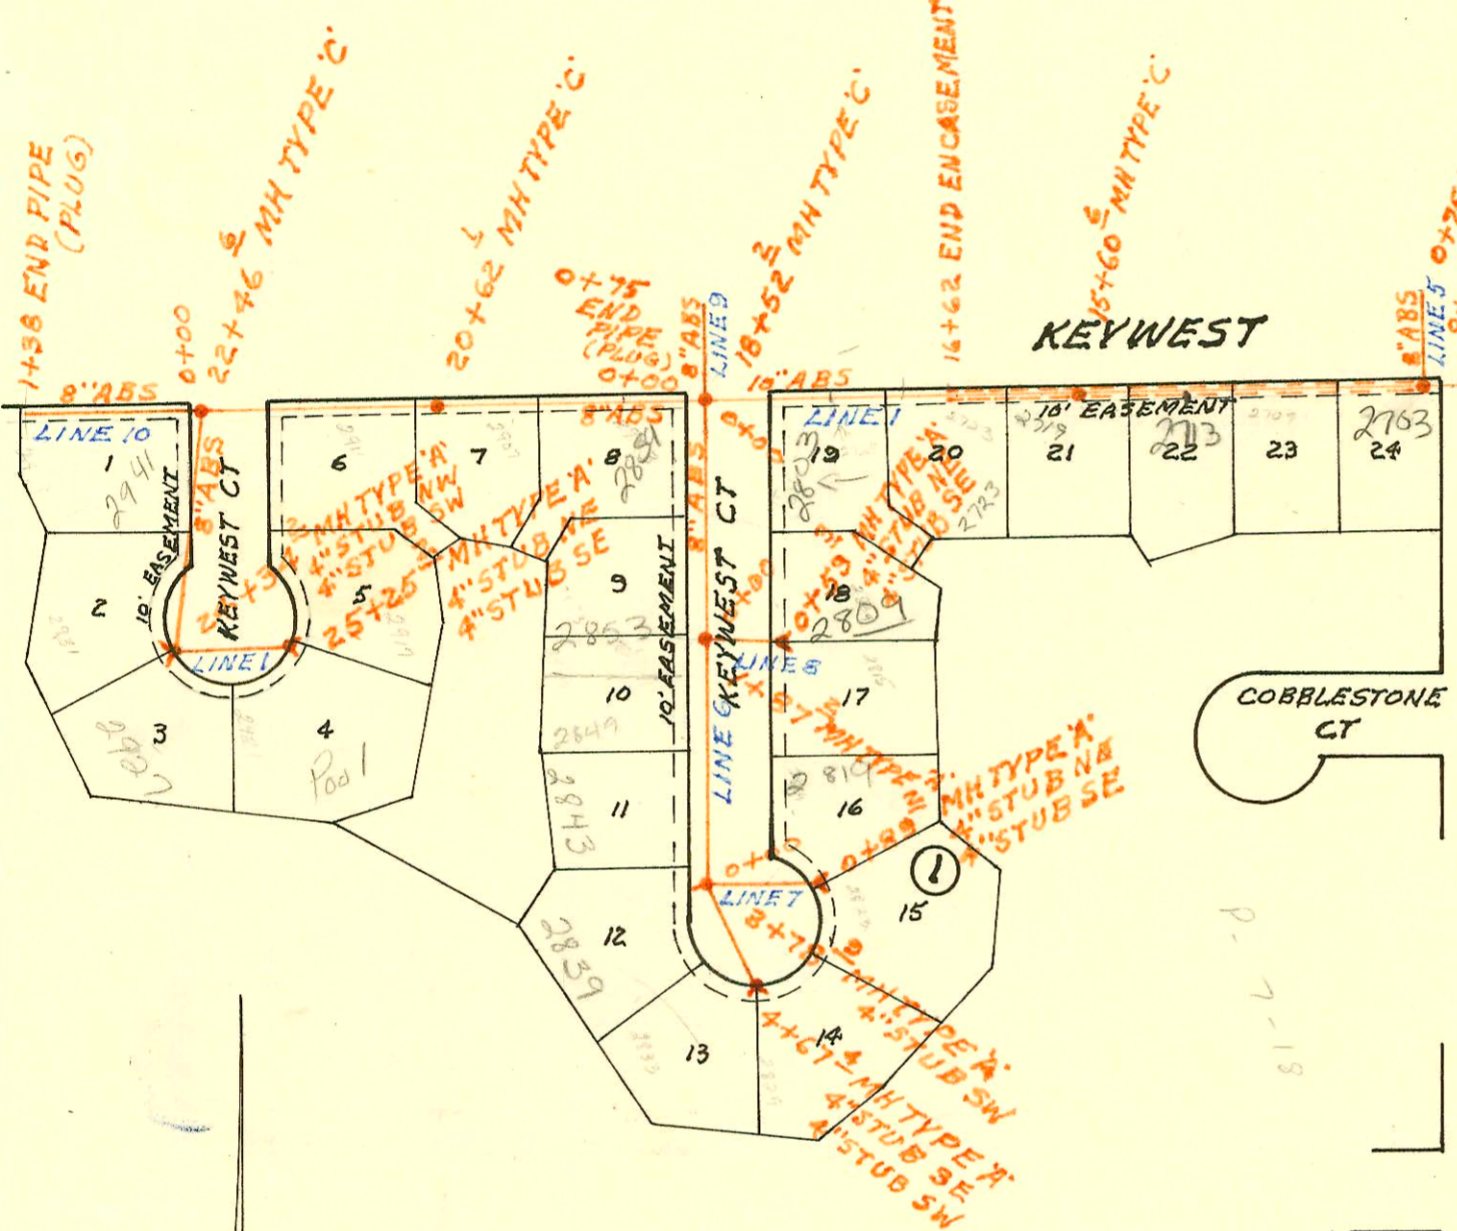


HARRY


SCALE 1" = 150'

LATERAL 10 MAIN 19 WAR INDUSTRIES SEWER
BUILT BY: TRIPLE C OF WICHITA INC.
PROJ. NO 468-76-245-80900-000-000-001
BOOKED 9-29-80 FROM SRL 9

on map

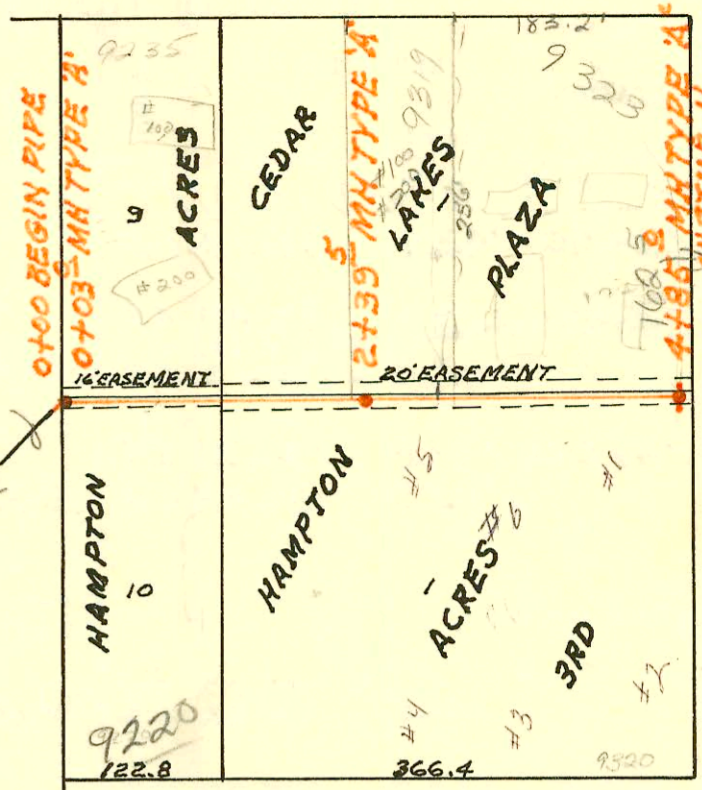


SCALE 1" = 150'

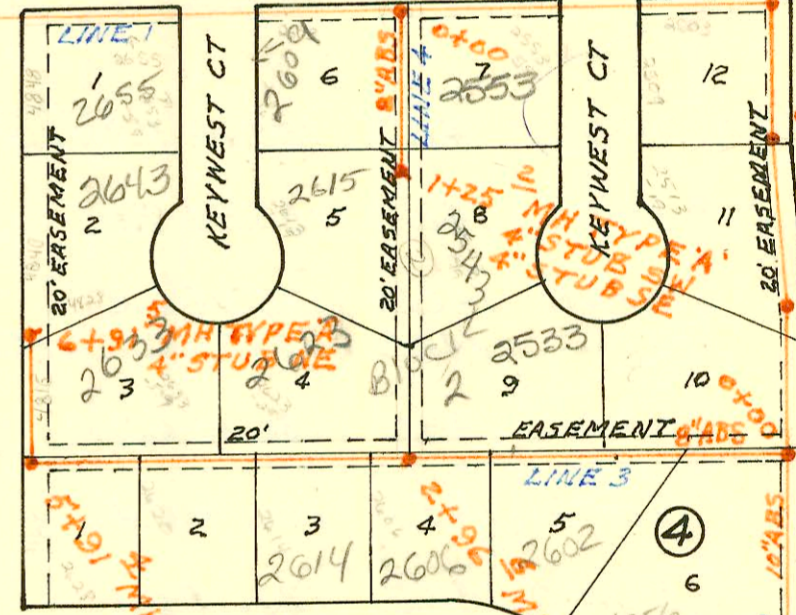

LATERAL 33 SANITARY SEWER NO 23
BUILT BY: UTILITY CONTR. INC.
PROJ. NO 468-76-245-80440-000-000-001
BOOKED 10-7-80 FROM AG 12

on map

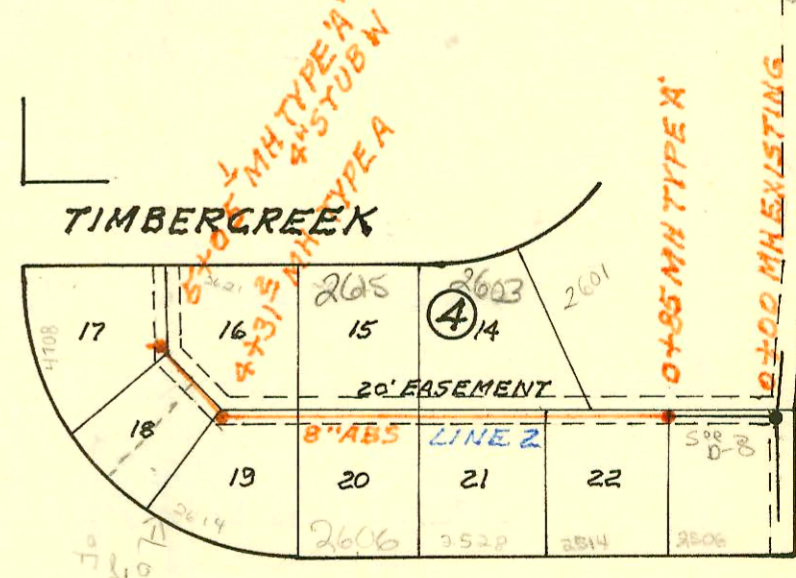

MILRO

MERIDIAN

CONSTRUCTION RECORD

SERVICE RECORD

STATION	ELEVATION		Depth	MANHOLE	4-INCH "Y" BRANCHES		No. of Permit		House Number		DATE OF PERMITS	
	Ground	Grade			North West	South East	North West	South East	North West	South East	North West	South East
LAT 33 55 N ^o 23 CONT'D												
LINE 7	0+00	142.1	135.61	6.5	0+00 = 3+78.9							
		142.3	135.97	6.3	0+89.2	4" STUB NE	4" STUB SE	19283	7236	2819 Request	2823 Request	10/09/82 12-21-82
LINE 8												
	0+00	141.6	134.85	6.8	0+00 = 1+87.2							
		141.7	135.09	6.6	0+59.3	4" STUB NE	4" STUB SE	19359	11701	2809 Request	2815 Request	10/14/82 8-7-84
LINE 9												
	0+00	141.5	130.37	11.1	0+00 = 18+52.2							
	0+75	142.2	130.67	11.5								
LINE 10												
	0+00	142.6	131.25	11.4	0+00 = 22+46.6							
	1+00	143.1	131.50	11.6								
	1+38	142.8	131.60	11.2		1+10.0 TR		21388		2941 Request		8-26-88
LATERAL 10 MAIN 6 SAN SEWER N ^o 23												
	0+00	199.4	182.85	16.6	0+00 EXISTING							
		201.7	183.05	18.7	0+98.8							
	1+00	201.7	186.76	14.9								
	2+00	200.2	187.62	12.6								
		199.3	187.93	11.4	2+36.5							
	3+00	197.9	188.47	9.4								
	4+00	195.7	189.32	6.4								
		197.4	190.17	7.2	5+00.5							
	6+00	197.7	191.02	6.7								
	7+00	198.2	191.87	6.3								
		199.1	192.31	6.8	7+51.7							
LATERAL 18 MAIN 10 WAR INDUSTRIES SEWER												
	0+00	147.3	139.10	8.2	0+00 EXISTING							
	1+00	150.2	139.50	10.7								
		149.7	139.62	10.1	1+31.0							
			139.74	10.0								
	2+00	149.6	140.29	9.3								
						1+97.0 TR		2907		3015 Geor. Wash. Bld		3-23-81
								201-62541		3031 Geor. Wash.		10760
	3+00	150.2	141.09	9.1								
		151.0	141.64	9.4	3+68.4							
						3+28.4 TR		1439		3051 S Geor. Wash. Bld		10-7-80
						3+54.4 TR		1441		3051 S Geor. Wash. Bld		10-7-80
	4+00	151.2	141.96	9.2								
	5+00	154.2	142.95	11.2								
						4+30.4 TR		1442		3051 S Geor. Wash. Bld		10-7-80
						5+21.2 TR		1443		3051 S Geor. Wash. Bld		10-7-80
	6+00	157.2	143.96	13.2								
		157.7	144.10	13.6	6+14.2							
LATERAL 18 MAIN 2 SOUTHWEST INTERCEPTOR												
LINE 1	0+00	82.95	65.47	17.5	0+00							
		82.75	65.57	17.2	0+28.8	4" STUB W		7468		5589 Mosley		2-14-83
	1+00	77.5	65.82	11.7				7469		5575 Mosley		2-14-83
						1+32.4 RISER W 5.8 Deep		9523787		5561 Mosley		12-8-85
						1+99.4 RISER W 8.2 Deep						
	2+00	80.0	66.17	13.8								
		82.0	66.39	15.6	2+62.7	4" STUB W		9716787		5555 Mosley		9-22-97
						2+45.78 RISER W 8.2 Deep		10883		5531 Mosley		3-21-89
	3+00	79.2	66.52	12.7				97235167		5551 Mosley		12-10-97
						3+20.4 RISER W 6.8 Deep		10763		5531 Mosley		5-21-84
						3+86.4 RISER W 6.5 Deep						

CONT'D NEXT PAGE

11410 3051 Geor. Wash. Bld 10-7-80 40' N. of MH and 115' E. Bldg #2. Sew. South (See Permit)