
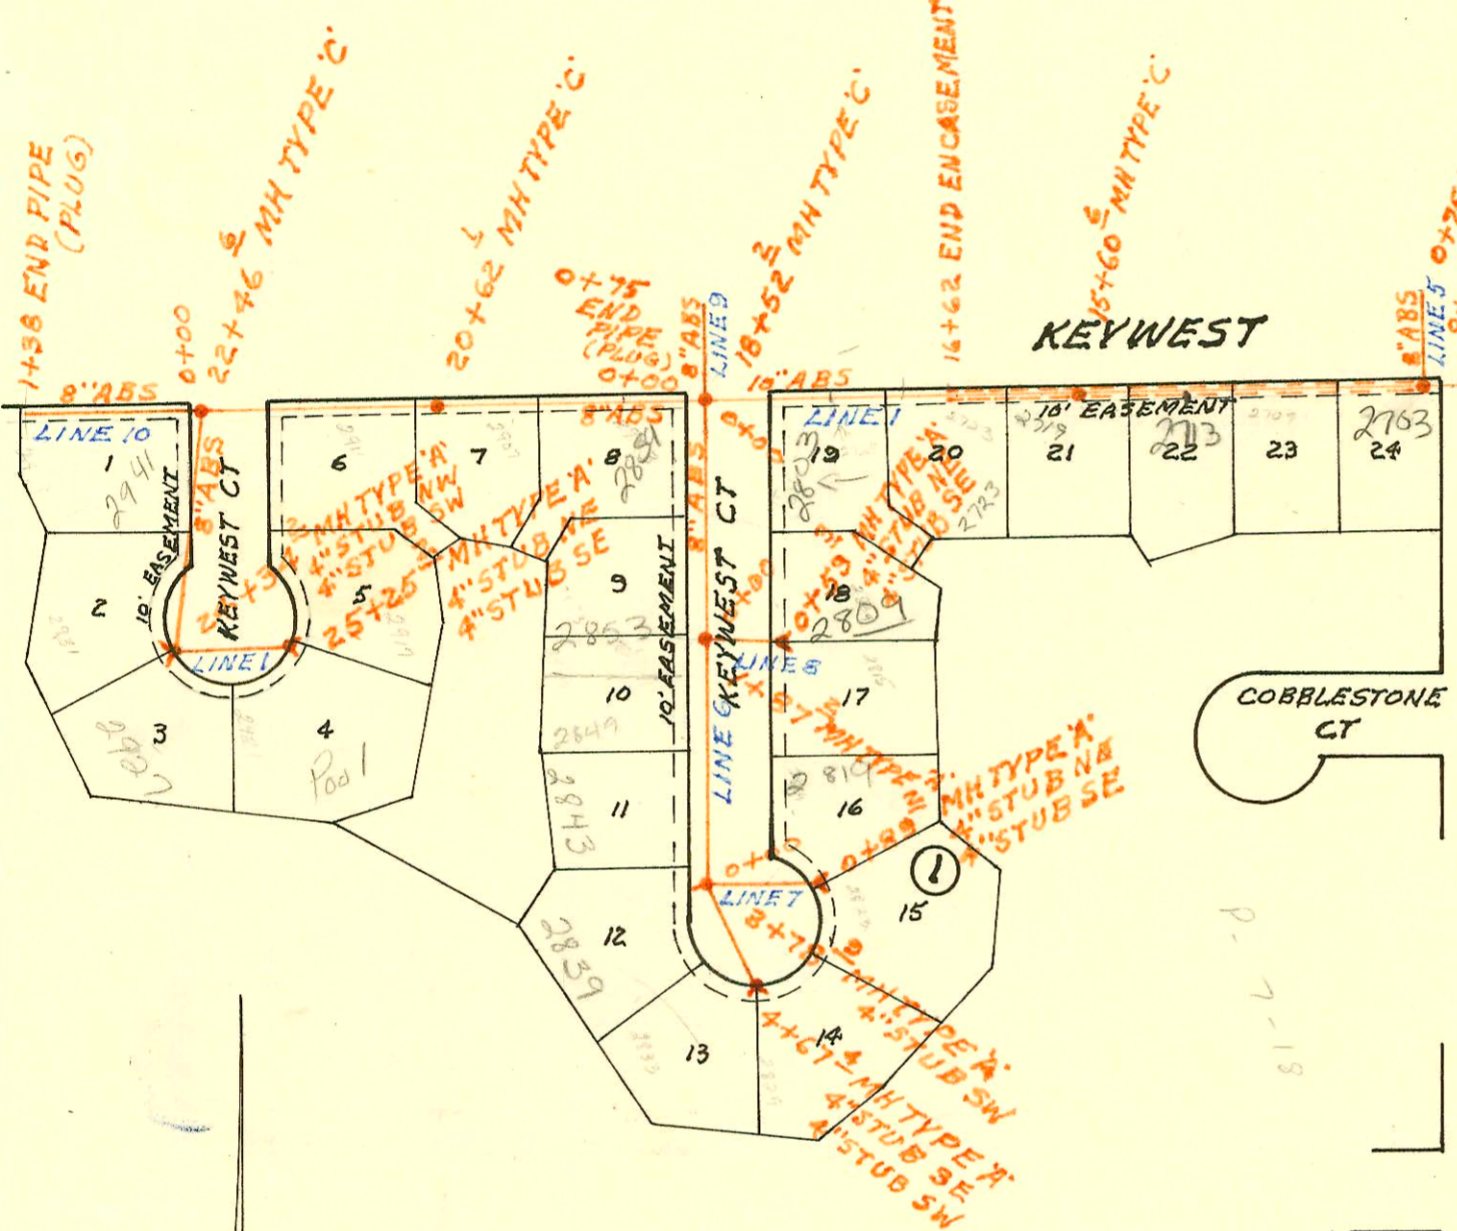


HARRY


SCALE 1" = 150'

LATERAL 10 MAIN 19 WAR INDUSTRIES SEWER
BUILT BY: TRIPLE C OF WICHITA INC.
PROJ. NO 468-76-245-80900-000-000-001
BOOKED 9-29-80 FROM SRL 9

on map

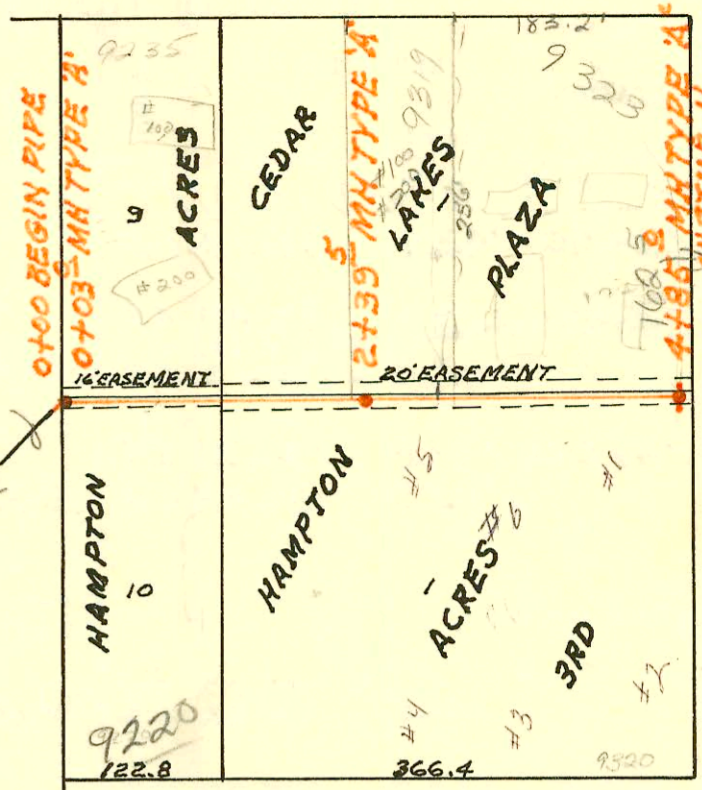


SCALE 1" = 150'

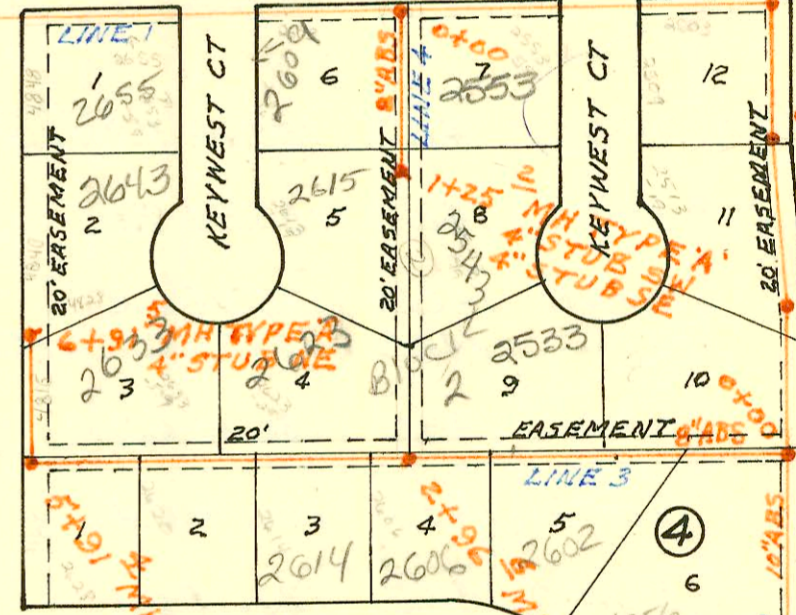

LATERAL 33 SANITARY SEWER NO 23
BUILT BY: UTILITY CONTR. INC.
PROJ. NO 468-76-245-80440-000-000-001
BOOKED 10-7-80 FROM AG 12

on map

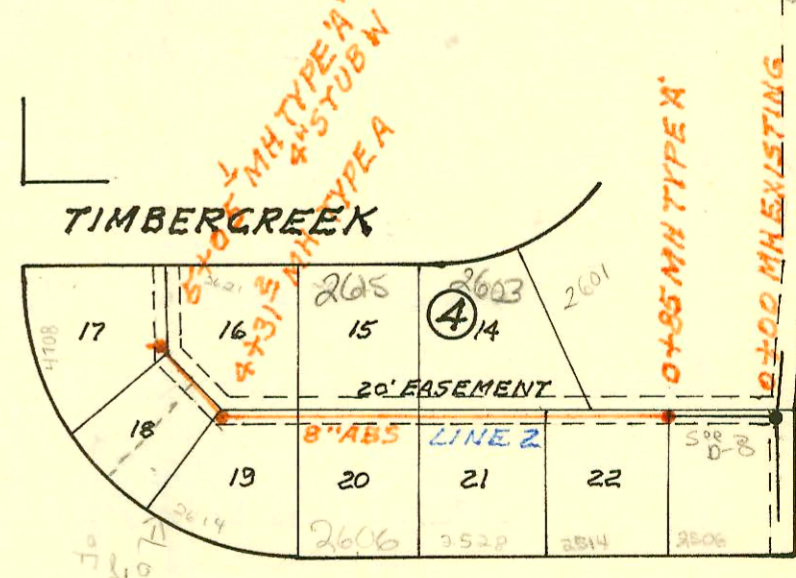

MERIDIAN

E292A

