


11

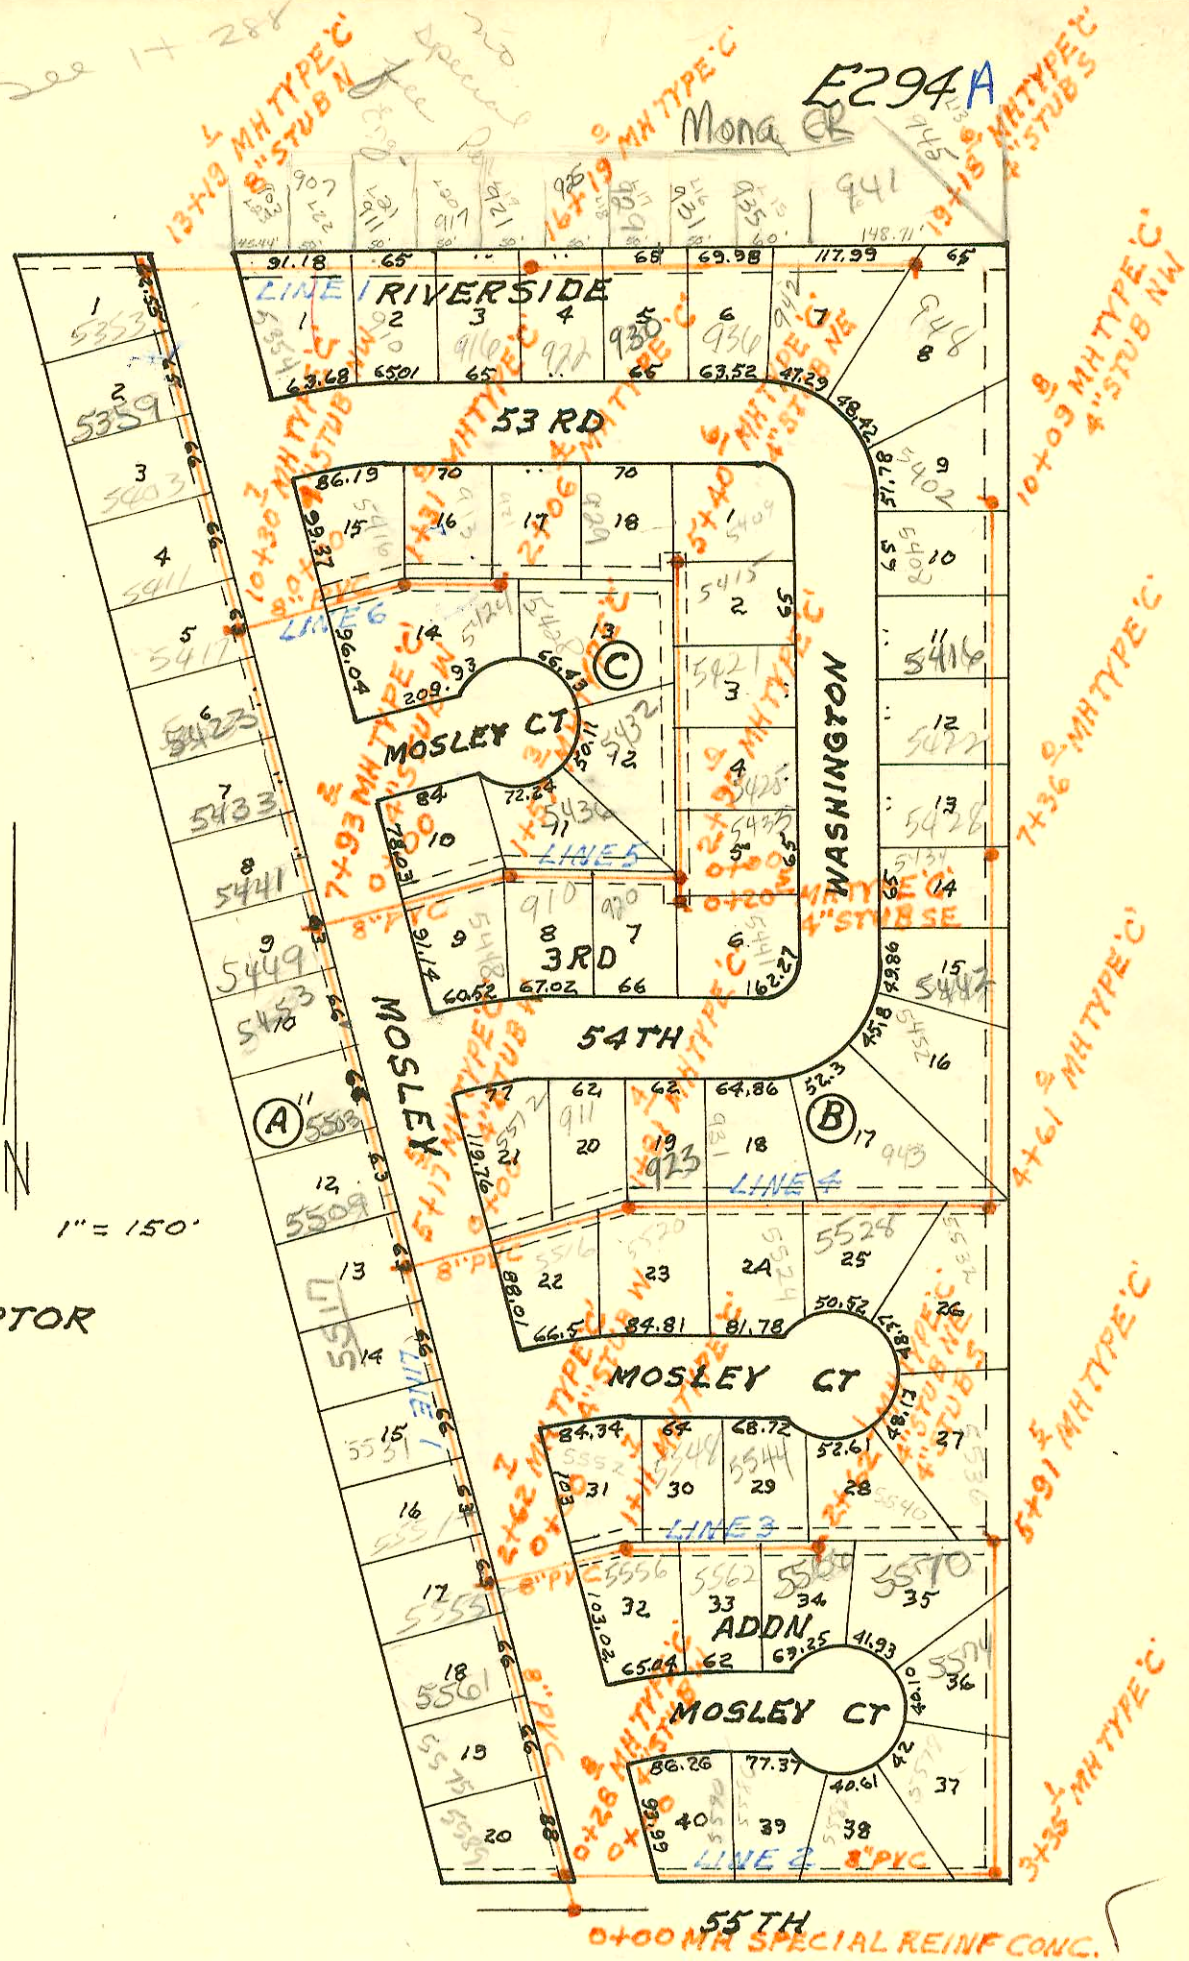

CONSTRUCTION RECORD

SERVICE RECORD

LAT 18 MAIN 2 SWI (CONT'D)												
LINE 1 CONT'D	4+00	79.0	66.87	12.1								
					4+57.4 ^{4"} RISER		9285		5517 Mosley	House	9-26-83	
	5+00	78.7	67.22	11.5								
		81.7	67.28	14.4	5+17.5 4" STUB W		9614527		5517 Mosley	Garage	8-28-96	
					5+79.4 RISER W 4.4 Deep		9516607		5509 Mosley		10-17-95	
	6+00	76.8	67.57	9.2								
					6+46.4 RISER W 3.5 Deep		9829467		5503 Mosley		12-10-88	
	7+00	76.9	67.92	9.0	7+12.4 RISER W 3.3 Deep		983727		5453 Mosley		5-5-98	
		81.7	68.25	13.5	7+93.2 4" STUB W		9520177		5449 Mosley		12-8-95	
	8+00	77.0	68.27	8.4								
					8+68.7 tap				5441 S Mosley		5-3-96	
	9+00	76.8	68.62	8.2	8+46.4 RISER W 2.8 Deep		9664487		5433 S Mosley		5-3-96	
					9+09.4 RISER W 2.5 Deep		9664507		5423 Mosley		5-15-98	
	10+00	77.0	68.97	8.0								
		81.8	69.07	12.7	10+30.7 4" STUB NW		976007		5417 Mosley		1-14-97	
					10+95.4 RISER W 2.3 Deep		9616167		5411 Mosley		9-23-96	
	11+00	77.2	69.32	7.9								
					11+59.4 RISER W 2.4 Deep		9698687		5403 S Mosley		6-25-96	
	12+00	77.6	69.67	7.9	12+24.4 RISER W 2.1 Deep		9520527		5359 Mosley		12-12-95	
					12+84.4 RISER W 1.7 Deep							
	13+00	76.8	70.02	6.8								
		82.0	70.09	11.9								
			70.16	11.8	13+19.1 8" STUB N							
	14+00	77.3	70.81	6.5								
					14+65.1 tap		12824		903 Mosley		12-17-84	
					14+63.1 tap		12404	4245	907 Mosley	5354 S Mosley	5-27-81	10-5-81
	15+00	79.5	71.61	7.9								
					14+98.0 tap		11773	6835	911 Mosley	910 E S Mosley	8-16-84	10-22-82
					15+63.0 tap		12516	94-100487	917 Mosley	916 E S Mosley	11-8-84	6-28-94
	16+00	80.2	72.41	7.8								
		80.5	72.56	7.9	16+19.0							
					15+90.0 tap		11789	97-22267	921 Mosley	920 E S Mosley	8-16-84	12-29-97
					16+37.5 tap		20241		925 Mosley	930 E S Mosley	3-7-88	
					17+19.5 tap		18876	97-91407	929 Mosley	930 E S Mosley	8-11-87	10-27-97
	17+00	81.2	73.21	8.0								
					17+33.6 tap		11790	93-94917	931 Mosley	930 E S Mosley	8-16-84	7-19-93
					17+88.15		11791		935 E Mosley	942 E S Mosley	8-16-84	
	18+00	81.8	74.01	7.8								
					4" SDR 35				941 Mosley	948 E S Mosley	1-25-96	4-26-83
					18+96.0		969937					
	19+00	82.2	74.81	7.4								
		82.2	74.96	7.2	19+18.6	4" STUB S	7470				2-14-83	
LINE 2	0+00	82.75	69.40	13.4	0+00=0+28.8 LINE 1							
	1+00	77.1	70.15	7.0								
					1+10.10 tap		2838		5590 S Mosley		3-12-81	
	2+00	76.7	70.90	5.8								
					1+60.10 tap		2837		5586 S Mosley		3-12-81	
					2+09.2 tap		2836		5582 S Mosley		3-12-81	
	3+00	78.7	71.65	7.1								
		78.8	72.01	6.8	3+35.1							
					3+81.15 tap		2835		5578 S Mosley		3-12-81	
	4+00	79.0	72.50	6.5								
	5+00	81.3	73.25	8.1								
		82.3	73.94	8.4	5+91.5 4" STUB NW		8391	97-28087	5536 S Mosley	5570 Mosley	6-15-83	7-28-97
LINE 3	0+00	82.0	70.00	12.0	0+00=2+62.7 LINE 1							
	1+00	79.5	71.50	8.0								
		79.5	71.68	7.8	1+11.7							
					4" Sch 40 PVC							
					1+89							
	2+00	79.7	73.00	6.7								
		80.2	73.93	6.3	2+62.1 4" STUB NE	4" STUB S	23589		5544 Mosley	5566 Mosley	7-9-98	12-12-86
LINE 4	0+00	81.7	69.85	11.9	0+00=5+17.5 LINE 1							
	1+00	78.4	70.35	8.1								
		79.1	70.76	8.3	1+81.4							
	2+00	79.2	70.85	8.4								
	3+00	80.3	71.35	9.0								

CONT'D NEXT PAGE

CONSTRUCTION RECORD

SERVICE RECORD

STATION	ELEVATION		Depth	MANHOLE	4-INCH "Y" BRANCHES		No. of Permit		House Number		DATE OF PERMITS	
	Ground	Grade			North West	South East	North West	South East	North West	South East	North West	South East
LAT 18 MAIN 2 SWI (CONT'D)												
LINE 4 CONT'D	4+00	81.2	71.16	10.0	4+03.4 tap	4+46.0	6490	9180	943 E 54th S	5532 S Mosley Ct	7-7-82	9-13-83
		78.7	72.16	8.5								
			72.26	6.4	4+61.0							
	5+00	79.8	72.45	7.4		5+53.0		9179	5442 Washington	5452 S Washington		9-13-83
	6+00	82.2	72.95	9.3			9619327				11-6-82	
	7+00	83.8	73.45	10.4	7+07.6 tap		10258		5434 S Washington		2-21-84	
		83.4	73.63	9.8	4" SDR 35 7+82		94-3650-7		5438 S Washington		3-18-94	
	8+00	83.7	73.95	9.8	8+36.0 tap		25681		5422 S Washington		7-9-90	
	9+00	83.2	74.45	8.8		9+67.5	98241057	4652	5416 Washington	5408 S Washington	12-10-98	11-13-81
	10+00	83.3	74.95	8.4								
		83.6	75.00	8.6	10+09.8 4" STUB NW		7471		5402 S Washington		2-14-83	
LINE 5	0+00	81.7	71.40	10.3	0+00=7+93.2 LINE 1							
	1+00	78.2	71.90	6.3		1+40.3		4654	5448 S Mosley		11-13-81	
		79.2	72.19	7.0	1+57.3		97-97-7		5436 Mosley Ct		12-26-96	
	2+00	79.6	72.40	7.2								
		80.7	72.85	7.9	2+90.0	2+55.5		10985	920 E 54th S		5-21-84	
			72.95	7.8								
	3+00	80.7	73.00	7.7		3+06.0 tap	9129		5433 S Washington	5425 S Washington	9-6-83	
					4" SDR 35		9615637	94-3651-7	5432 Mosley	5426 S Washington	9-17-96	3-1-94
	4+00	79.2	73.50	5.7	4" Sch 40 PVC	4+46.6	94186307		5428 S Mosley	5421 S Washington	11-13-81	11-9-94
					4+80.7		4653					
	5+00	80.7	74.00	6.7		5+01.8		6903	5415 S Washington	5409 S Washington	11-2-82	
		80.9	74.20	6.7	5+40.6	5+31.3	4244	7458	929 E 53rd S	5407 S Washington	10-5-81	2-14-83
LINE 5A	0+00	80.7	74.00	6.7	0+00=2+90.0 LINE 5							
		80.7	74.20	6.5	0+20.5	4" STUB SE	6836		5441 S Washington		10-22-82	
LINE 6	0+00	81.8	71.44	10.4	0+00=10+30.7 LINE 1							
	1+00	78.4	72.44	6.0		1+14.4		4246	5416 S Mosley		10-5-81	
		78.9	72.75	6.2	1+31.0		1+66.8	1+82.2	713 E 53rd S	5424 S Mosley	5-26-83	8-22-80
	2+00	80.0	73.44	6.6								
		80.0	73.50	6.5	2+06.4 4" STUB NE		11183		921 E 53rd S		6-13-84	
LATERAL N EAST SUBMAIN 'C' SAN SEWER N#1												
	0+00	107.2	100.55	6.7	0+00 EXISTING							
		107.1	101.50	5.6	0+75.3 6" STUB NE							
LATERAL 38 SANITARY SEWER N#23												
LINE 1	0+00	155.5	142.28	13.2	0+00 EXISTING	4" PVC 40 M/C 46.9 tap		9373417	4327 E Salem Ct		4-2-93	
	1+00	156.0	142.69	13.3								
		156.3	142.86	13.4	1+41.5				4321 Salem Ct		9-3-91	
			142.93	13.4			99-0060		4317 Salem Ct		12-19-95	
	2+00	156.5	143.16	13.3		4" SDR 35 2+24.5	95206197					
	3+00	157.4	143.57	13.8			91-38637	97-18777	4303 E Salem	431 Salem Ct	12-09-91	10-07-97
		159.6	143.91	15.7	3+82.0							
			149.00	10.6								
	4+00	158.7	149.08	9.6								
	5+00	158.5	149.53	9.0		5+15.7	6876		4302 Salem		11-1-82	
		158.4	149.77	8.6	5+52.7							
			149.87	8.5								
	6+00	158.2	150.08	8.1								
	7+00	157.5	150.53	7.0			96-110407		3111 N Applegate		7-11-96	
		157.2	150.68	6.6	7+26.5	7+49.6	6180		3119 N Applegate		7-19-82	
			150.75	6.5								

CONT'D NEXT PAGE