


LATERAL 98 MAIN 4 SANITARY SEWER #23
 BUILT BY: UTILITY CONTR. INC.
 PROJ. NO 468-76-245-80763-000-000-001
 BOOKED 11-15-80 FROM LES 1

on map

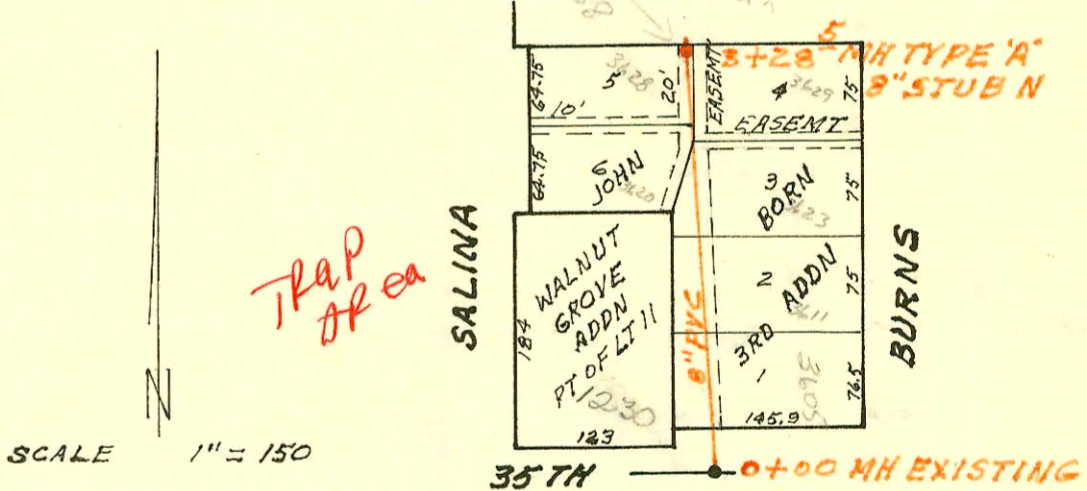

Trap Area

on map

CONSTRUCTION RECORD

SERVICE RECORD

STATION	ELEVATION		Depth	MANHOLE	4-INCH "Y" BRANCHES		No. of Permit		House Number		DATE OF PERMITS	
	Ground	Grade			North West	South East	North West	South East	North West	South East	North West	South East
LATERAL 104 DRY CREEK MAIN 2 SAN SEWER N ^o 12												
0+00	178.2	167.55	10.7	EXISTING								
1+00	177.7 179.8	167.95 168.21 170.21	9.8 11.6 9.6	1+64.2	4" MH Stub		7653		555 500 Woodlawn			3-11-83
2+00	181.2	170.97	10.2		4" PVC 40 1471+2 TOP 1/2		9369497		6100 (Bldg) E Central			4-2-93
3+00	184.4	173.08	11.3									
4+00	188.0 189.8	175.19 175.86 177.06	12.8 13.9 12.7	4+31.7	4+65.7		13952		6100 E Central			6-5-85
5+00	189.8	177.74	12.1		no record see stub							
6+00	190.0	178.73	11.3		6+07.7		9968	11870	555744 Woodlawn	535 N Woodlawn		1-9-84
7+00	189.3 189.3	179.72 179.83 180.60	9.6 9.5 8.7	7+11.5								
8+00	190.0	182.01	8.0									
9+00	193.0 193.3	183.61 184.00 184.11	9.4 9.3 9.2	9+24.7	8+91.7			6261		535 N Woodlawn		7-29-82
10+00	195.2	184.41	10.8		10+02.1		1457		555 N Woodlawn			10-8-80
11+00	194.0	184.81	9.2									
12+00	195.0 196.5	185.22 185.42	9.8 11.1	12+50.7	12+06.9 4" STUB SE		4935 1110		555 N Woodlawn	535 N Woodlawn		10-15-81 8-28-80
LATERAL 98 MAIN 4 SANITARY SEWER N ^o 23												
0+00	131.3	124.04	7.3	EXISTING								
1+00	131.2	124.34	6.9		1+64.9		1069		1230 W 35th N			8-25-80
2+00	131.5	124.64	6.9		2+34.5	2+98.1	14264	16802	3629 Salina	3629 BURTONS		7-16-85
3+00	131.3 131.4	124.94 125.03	6.4 6.4	3+28.5	8" STUB N							8-7-86
LATERAL 89 SOUTHWEST INTERCEPTOR												
LINE 1 0+00	123.8	114.58	9.2	EXISTING	0+49.0			15339		2542 Glacier		1-2-86
1+00	123.5	114.98	8.5		1+33.2			4796		2548 Glacier		1-4-81
2+00	123.5 123.7	115.38 115.25 115.55	8.1 8.3 8.2	2+17.8	4" SDR 35 2+59.2 top		9138587			2602 Glacier		11-25-91
3+00	124.3 124.9	115.88 116.03	8.4 8.9	3+12.2								
4+00	125.6	116.38	9.2		4+38.2		7487			2622 Glacier		2-17-83
5+00	127.8 128.8	116.78 116.97	11.0 11.8	5+48.0	5+25.0 4" SDR 35 MH Top		13447 4835 4835			2626 Glacier		6-14-85 12-4-81
6+00	130.3 130.9	117.18 117.47 117.52	13.1 13.4 13.4	6+71.7	6+65.7		21611			2630 Glacier		12-4-81
7+00	131.9	117.63	14.3		7+05.7		14780			2638 Glacier		10-2-85
8+00	132.7	118.03	14.7		4" RISER 7+53 E 10' Deep 4" RISER 8+23 E 10' Deep 4" RISER 8+93 E 10' Deep		7291 15709			2648 Glacier		1-3-83 2-26-86
9+00	134.8 134.7	118.43 118.78 118.88	16.4 15.9 15.8	9+87.7	9+43.9		5695			2652 Glacier		4-22-82
10+00	134.4	118.93	15.5		10+23.3		2688			2704 Glacier		3-3-81

CONT'D NEXT PAGE