


SEWER RECORD

CONSTRUCTION RECORD

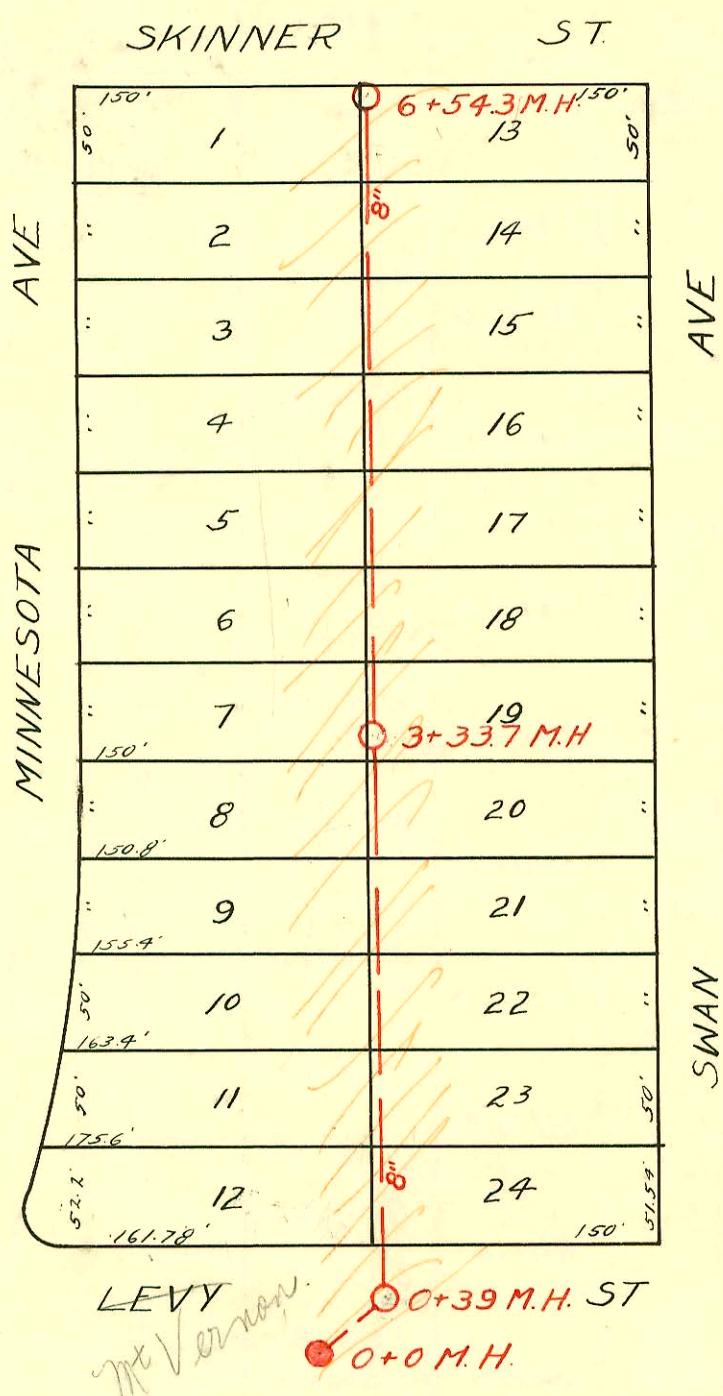

Note:  
 4" Pipe  
 Must be  
 Trapped With  
 a 6" Trap

LAT 28, S.S. #20  
 W.B. CARTER 1947  
 CHANGES BY STATE HWY DEPT  
 BOOKED 8-6-77 AS BUILT PLAN

CONSTRUCTION RECORD						SERVICE RECORD						
STATION	ELEVATION		Depth	MANHOLE	4-INCH "Y" BRANCHES		No. of Permit		House Number		DATE OF PERMITS	
	Ground	Grade			North West	South East	North West	South East	North West	South East	North West	South East
0+0	97.1	92.11	6.51	0+0 0+39								
1+0	97.8	93.21	4.79		0+97.4	0+94.4	C3382 #166	C31631 #243	Sealoff 1958 Mann	Sealoff 1957 Swan	7-25-72	4-17-72 6-17-47
					1+92.8	1+39.8	S.O. #165 C35485 #164	C36472 #242 C31631 #241	1952 Mann	1951 Swan	12-10-72	12-27-72 6-17-47
2+0	98.2	93.31	5.25		1+92.6	1+89.6						
					2+44.3	2+41.3	S.O. #163 C41953 #162	C35844 #240 C31631 #239	1942 Mann	1941 Swan	11-30-73	11-6-72 6-17-47
3+0	99.7	93.41	6.34		2+95.5	2+92.5						
				3+33.7								
					3+44.0	3+41.0	C40690 #161	C32303 #238	1932 Mann	1931 Swan	8-16-73	5-17-72 6-17-47
					3+95.8	3+92.8	S.O. #160 C41952 #159	C30841 #237	1928 Mann	1927 Swan	8-16-73	2-23-49 6-17-47
4+0	99.9	93.51	6.71									
					4+47.0	4+44.0	S.O. #158 C41951 #157	C42972 #236 C31631 #235	1922 Mann	1921 Swan	10-30-73	6-16-72 6-17-47
					4+95.4	4+92.4						
5+0	99.5	93.61	6.19									
					5+46.9	5+43.9	S.O. #156 C41947 #155	C31628 #234 C33861 #233	1912 Mann	1911 Swan	10-30-73	4-17-72 6-17-47
					5+96.0	5+93.0						
6+0	99.3	93.71	5.77									
				6+54.3	6+44.4	6+41.4	S.O. #155 C41942 #154	C39015 #232	1902 Mann	1901 Swan	10-30-73	5-15-73 6-17-47

C 35204 - 1916 E Mt. Kernon - Sealoff - 10-4-72 - at Denning (0+97.4 - conn. with 1958 S. Minnesota)