


CONSTRUCTION RECORD SERVICE RECORD

DATE OF RECORD: 1947 JUN 21
BY: W.B. CARTER
S.S. # 21

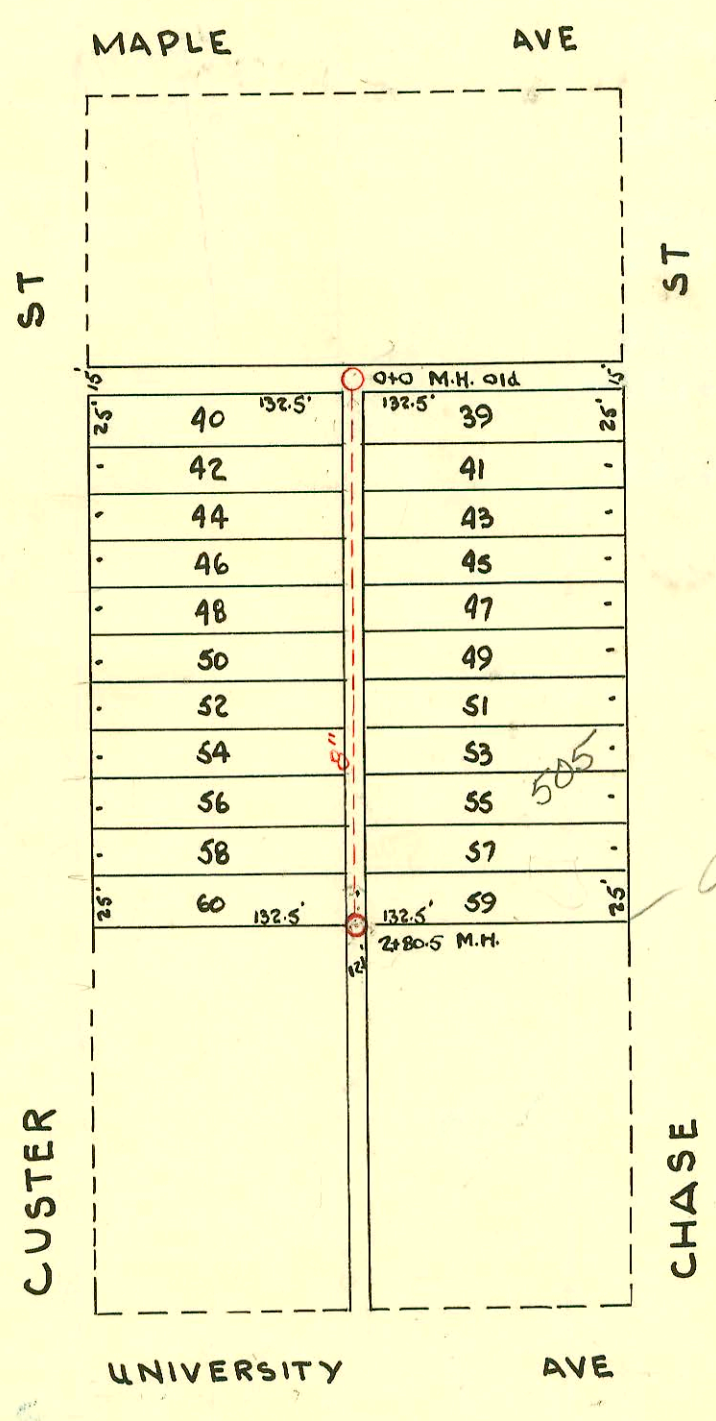

City Limits
371-43

LAT. 22 DIST. A S.S. # 21
W.B. CARTER JUN 1947

CONSTRUCTION RECORD						SERVICE RECORD						
STATION	ELEVATION		Depth	MANHOLE	4-INCH "Y" BRANCHES		No. of Permit		House Number		DATE OF PERMITS	
	Ground	Grade			North West	South East	North West	South East	North West	South East	North West	South East
0+0	114.0	109.09	4.98	0+0 (old)	0+16.3 +40.5 +65.0 +91.5	0+13.3 +31.5 +62.0 +88.5	#1109		422-24-24 J. Custer		6-24-52	
							#1710		432-34 S. Custer		6-24-52	
							#222		433-2 C. Custer			3-29-50
1+0	113.0	109.19	3.72		1+16.2 +52.7 +68.0 +82.2	1+13.2 +49.7 +65.0 +86.2	#3143	#3150	488-5 Custer	437 C. Custer	1-10-55	2-26-50
							#478	#3073	502-5 Custer	501 C. Custer	7-22-47	1-17-50
							#3629		506 S. Custer		1-11-51	
2+0	112.2	109.29	2.92		#11-24-40-00 2+13.3 +40.6 2+64.8 ✓	2+10.3 +37.6 +61.8			2000-02550 #3072	505-R C. Custer		11-21-00 7-17-50
							#286087 #3091	#176	sep. 10 518-5 C. Custer	511 C. Custer	11-5-93	3/22/50
2+80.5	111.7	109.37	2.17	2+80.5								

93-286087 11-5-93 512 S. Custer - Tied into for garage into existing house sewer - garage sewer is 4" ABS