


SERVICE RECORD

CONSTRUCTION RECORD

16TH. ST.

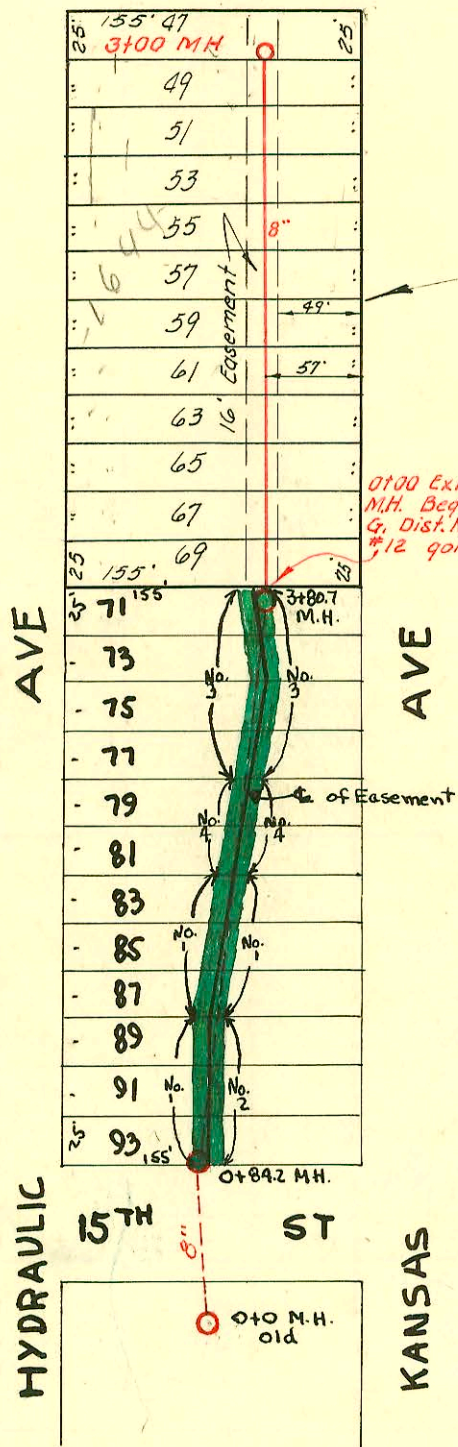

LAT. G, DIST. R, S.S. #12  
 W. B. CARTER, OCT. 20, 1953  
 BK. JT. 66, PROJ. NO. C22-95  
 4" 4909

LAT. E DIST R SS 20<sup>12</sup>  
 W.B. CARTER JUN 1947

THE EASEMENTS SHOWN ABOVE ARE :  
 NO. 1 FROM - JENNIE GORHUM FEB. 1947  
 NO. 2 FROM - BYRONE. & VERNILAM. HORNER FEB 1947  
 NO. 3 FROM - C.M. & NETTIE MEGEE FEB 1947  
 NO. 4 FROM - W.L. MORRIS FEB 1947

