


SERVICE RECORD

CONSTRUCTION RECORD

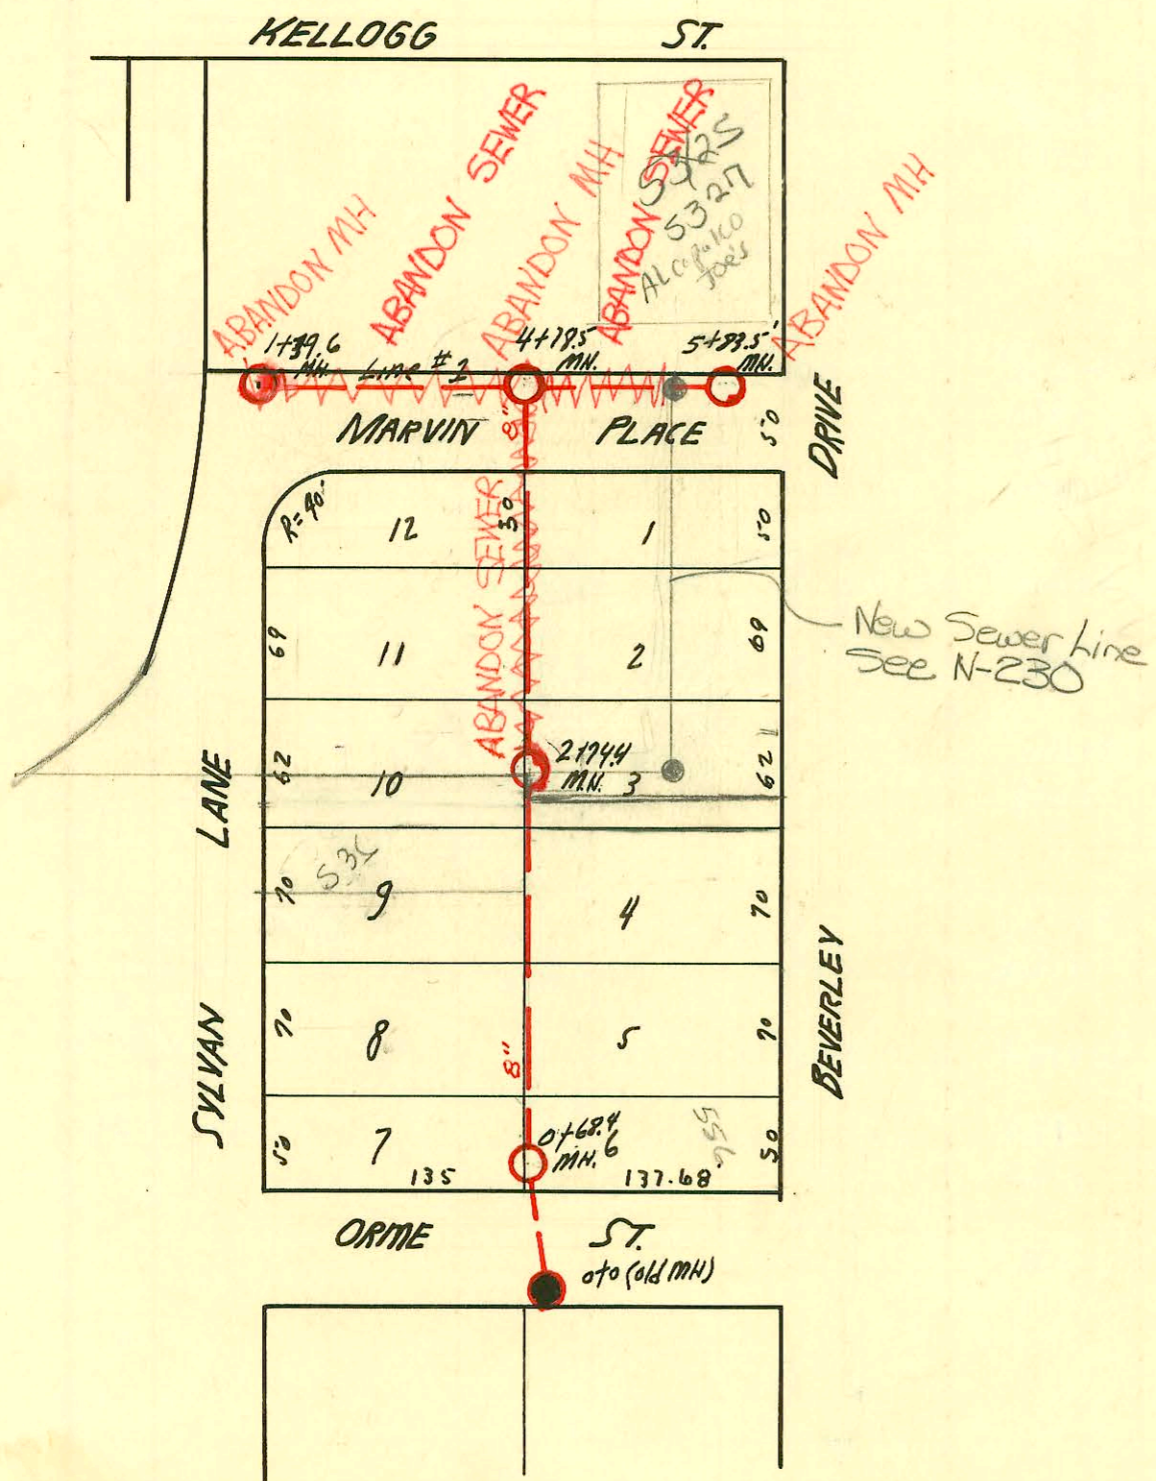

LAT. 23, DRY CREEK SUB. SS # 12
 W.B. Carter July - 1947

CONSTRUCTION RECORD

SERVICE RECORD

STATION	ELEVATION		Depth	MANHOLE	4-INCH "Y" BRANCHES		No. of Permit		House Number		DATE OF PERMITS	
	Ground	Grade			West	East	North West	South East	North West	South East	North West	South East
0+0	157.0	144.60	13.00	0+0 (old MH)								
0+68.4	157.0	144.67	12.05	0+68.4	0+85.4		1989		556 Sylvan		12-3-80	
1+0	156.5	144.70	12.25				C 60635		544 Sylvan	5320 E. Orma	4-6-77	
					1+08.3	1+11.3	#1725	#491	540 R. Sylvan	549-551 Bimley	9-22-47	7-23-47
					1+59.2	1+62.2	#1937	#492	540 R. Sylvan	549-551 Bimley	10-7-47	7-23-47
2+0	153.8	144.50	9.13				2708	0+70.3	536 E. Sylvan	543-545 Bimley	2-6-91	5-9-80
					2+42.0	2+45.0	#1938	#493	532 R. Sylvan	549-551 Bimley	10-7-47	7-23-47
					2+69.0		#2501		532 R. Sylvan		11-17-47	
2+74.4	152.4	144.87	7.90	2+74.4								
						2+77.0		#494	532 R. Sylvan	535-537 Bimley		7-23-47
3+0	152.7	144.90	7.94		3+75.0	3+78.0	#3125	#495	532 R. Sylvan	535-537 Bimley	1-23-50	7-23-47
4+0	153.2	145.0	5.66	8								
4+78.4	153.1	145.08	8.33	4+78.4								
5+0	154.0	145.10	8.97									
					North	South						
					5+07.0							
					5+55.6		#230		5325 E. Sylvan		6-18-48	
5+83.5	152.6	145.19	8.67	5+83.5								
0+0	153.1	145.28	8.15	0+0 (line 2)								
					North	South						
					0+98.5							
					0+90.9							
1+0	150.3	145.38	5.41									
1+39.6	149.5	145.42	4.36	1+39.6								

Line 1

Line 2

1725 - tap - 556 Sylvan Lane - 9-22-49 - O. Hanning Pelly Co.
 # 2501 - tap - 83-26 Sylvan Lane - 11-17-49 - O. Hanning Pelly Co. (3122-4)
 C 60636 - tap 544 Sylvan - 4-6-77 - O. Hanning - tap (1+18.3)