


SERVICE RECORD

CONSTRUCTION RECORD

PROPERTY OWNER, ADDRESS, CITY, STATE, ZIP, PROJECT NO., DATE, DRAWN BY, CHECKED BY, SCALE, SHEET NO. OF SHEETS

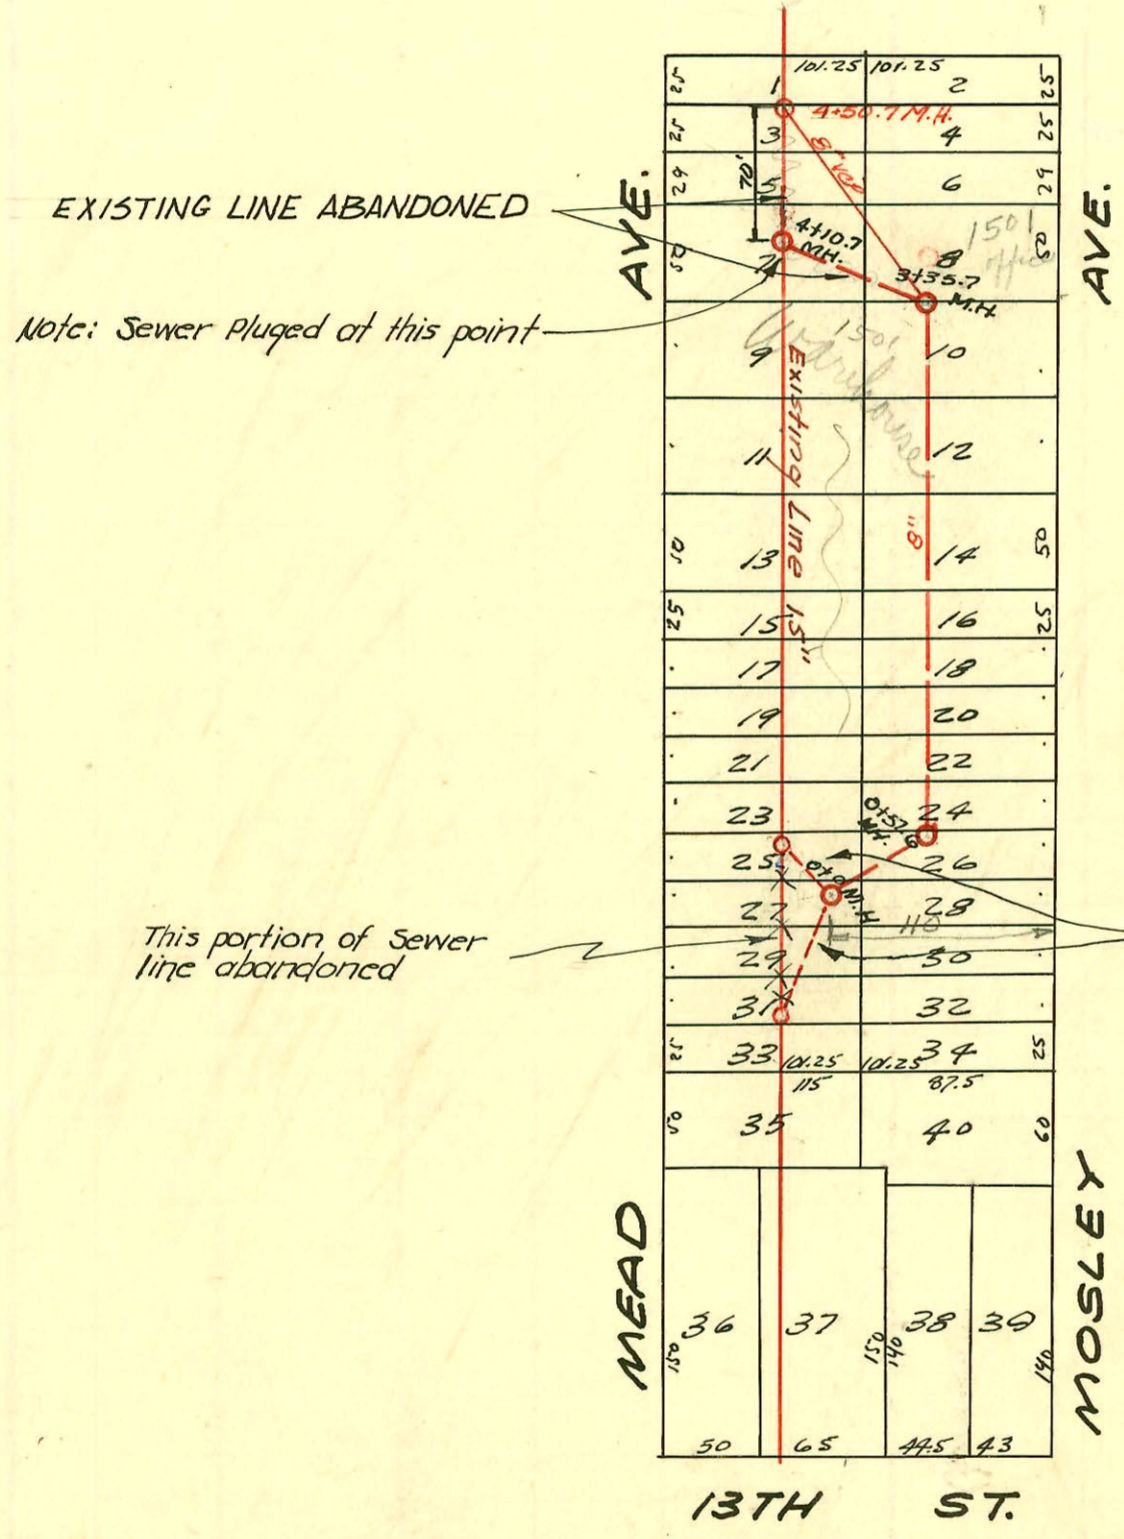

RELOCATION OF SEWER FOR CARGILL PLANT  
BUILT BY UTILITY CONSTRUCTION  
7-29-74 G-1  
PROJ. NO. DBKW704029

This portion of Sewer line abandoned

These Private lines were built prior to Private line of Dec. 1947, NOTE: No records of these lines.

PRIVATE LINE BUILT TO BY-PASS EXISTING 15" LINE

W.B. CARTER DEC. 1947  
PROJ. NO.

Private line built to bypass existing 15"

CONSTRUCTION RECORD						SERVICE RECORD						
STATION	ELEVATION		Depth	MANHOLE	4-INCH "Y" BRANCHES		No. of Permit		House Number		DATE OF PERMITS	
	Ground	Grade			North West	South East	North West	South East	North West	South East	North West	South East
0+0	7.8	0.00	8.33	0+0 (OLD M.H.)		n.h. tap		046983		1501 N. Masley		10-9-74
0+57.6	7.4	0.04	7.83	0+57.6 M.H.								
1+0	7.6	0.08	8.14									
2+0	7.6	0.16	8.02									
3+0	7.6	0.24	8.18									
3+35.7	7.7	0.26	7.78	3+35.7 M.H.	7.7	tap (S. W)	#11443 C6920		1501 N. Masley		7-12-84 2-16-68	warehouse restroom
4+0	7.3	0.32	7.53									
4+10.7	7.2	0.33	7.31	4+10.7 M.H. STA. 169,50.1 ON Existing Line								
NEW LINE												
0+00	118.5	110.68	7.78	3+35.7 EXISTING M.H. ON OLD LINE								
1+00	118.8	110.91	7.89									
	118.8	110.95	7.85	1+15								

# 2405 - tap - 2500 E. 18th (Boley School) - 4-5-49 - Pipette Poly Co. - (\$10.00 Special fee paid 4-5-49)  
 # 4225 - tap on 15" sewer - 1425 N. Masley - 3-27-51 - R. La Joy.  
 # 1787 tap - 1501 N. Masley - 7-3-52 - get the record  
 C 55395 - tap - 1501 N. Masley 5-12-76 - Fredericks (M.H. tap in 0+00)