


SERVICE RECORD

CONSTRUCTION RECORD

N

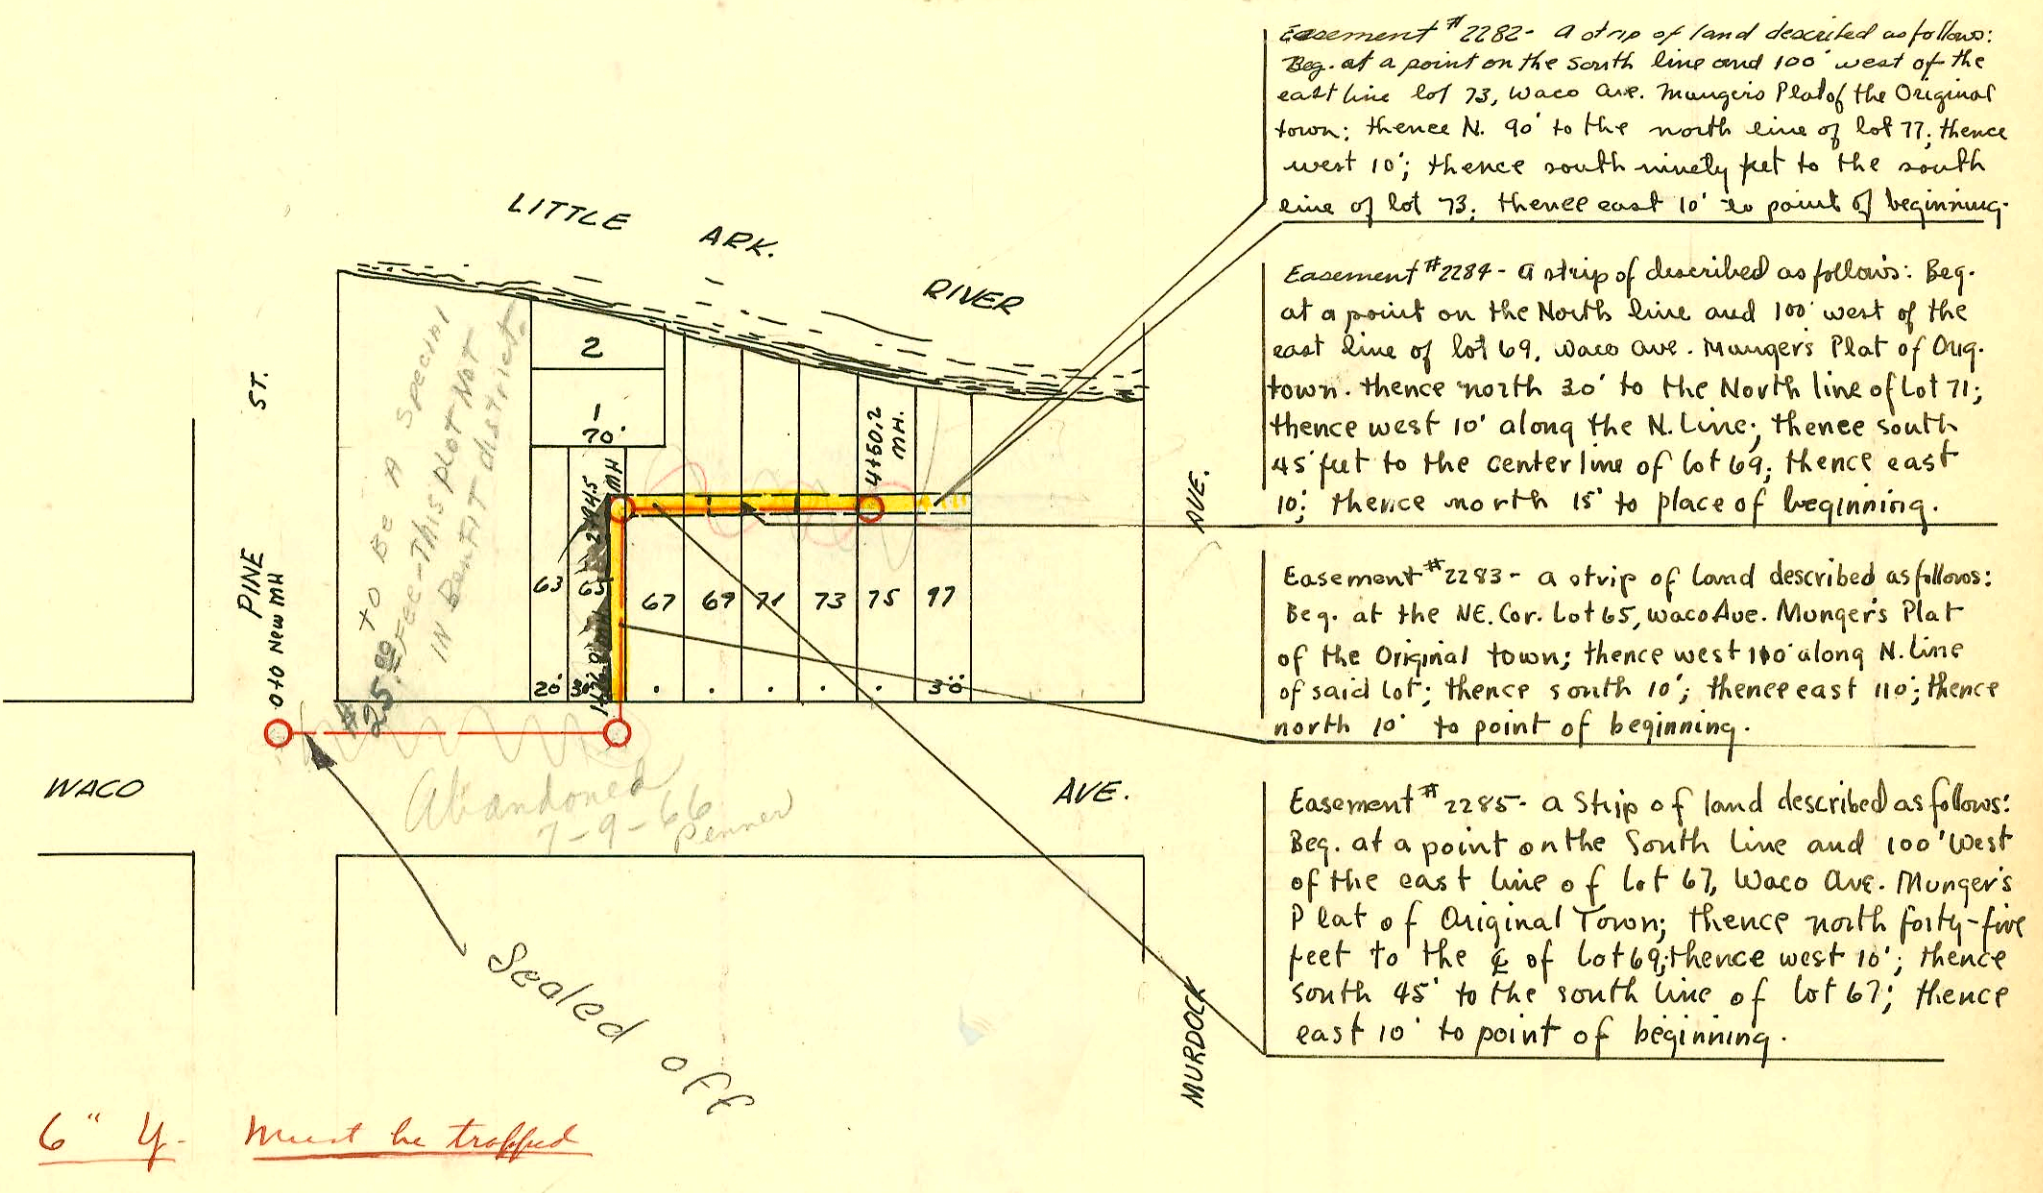

W.B. Carter 1948
Proj No. C 27-17 Lat 10, SS.#1

