



HARRY ST.

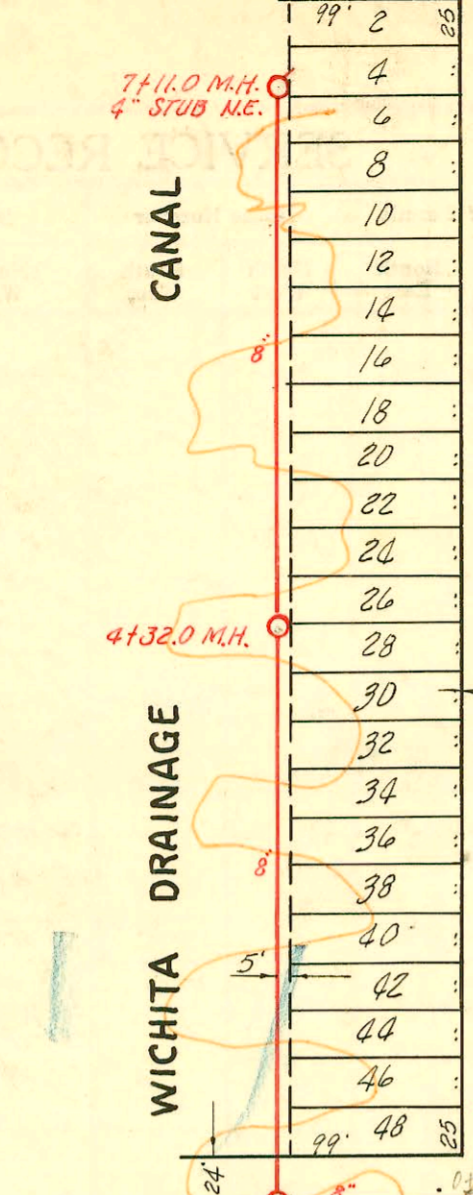

LAT. 20, DIST. AS, S. S. 12  
 UTILITY CONT. INC., DEC. 8, 1953  
 BK. JT. 58, PROJ. NO. C23-43

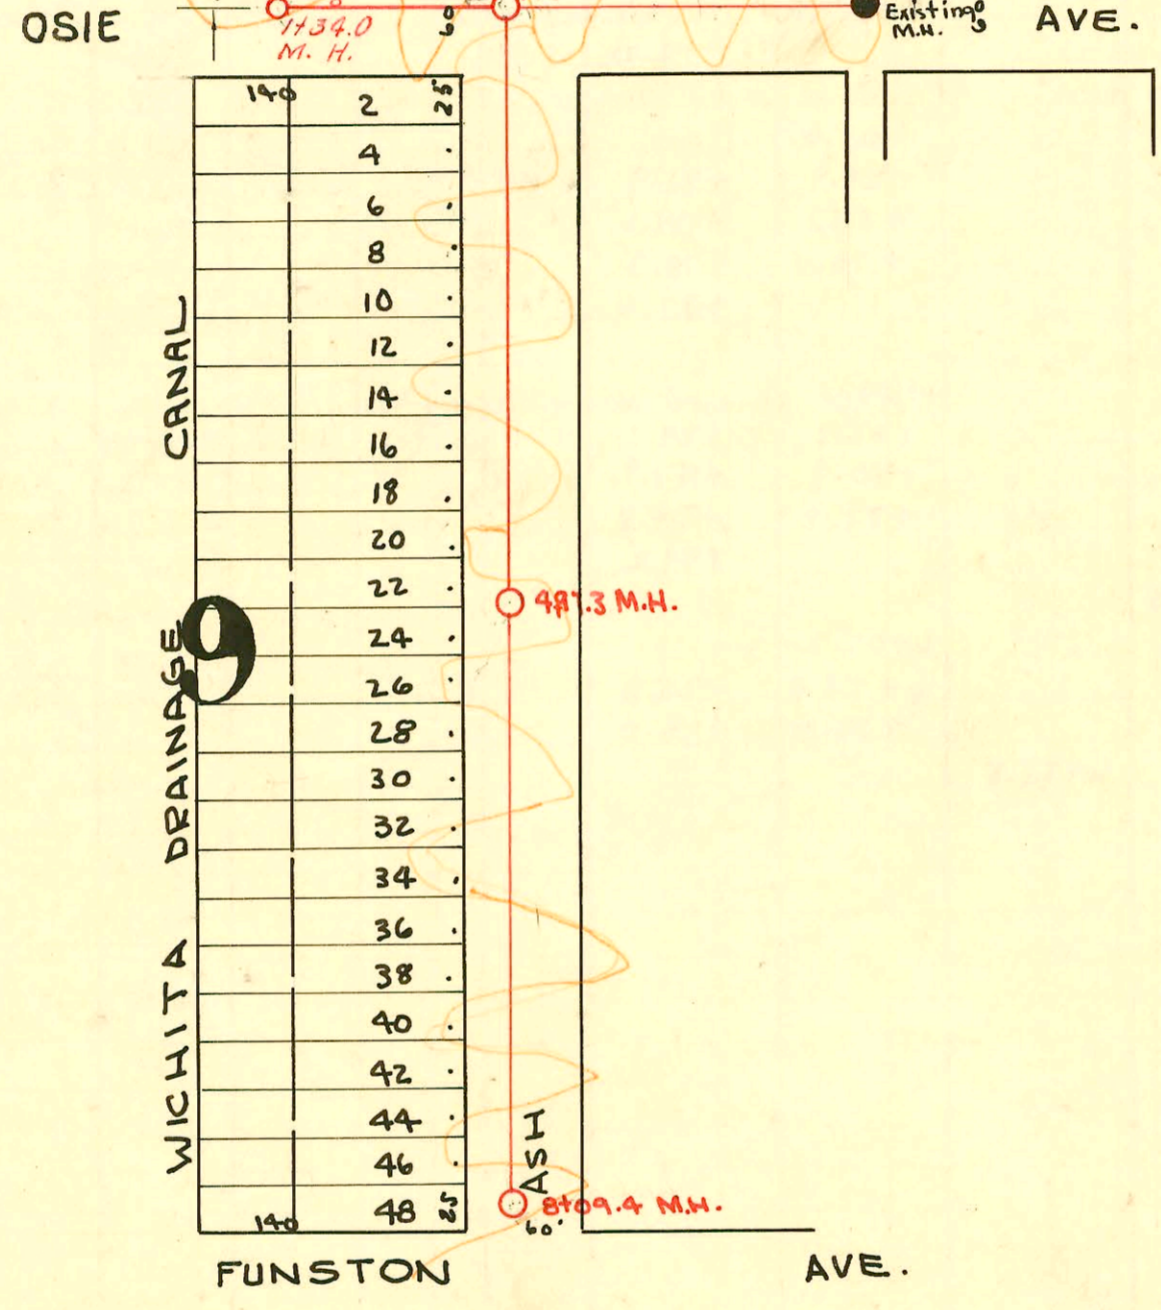

W.B. CARTER - Contractor 1948  
 LAT. 4 DIST. AS. MAIN 12  
 CHANGES BY STATE HWY DEPT  
 BOOKED 8-6-77 AS BUILT PLAN

