
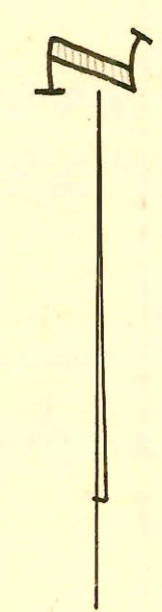


CONSTRUCTION RECORD

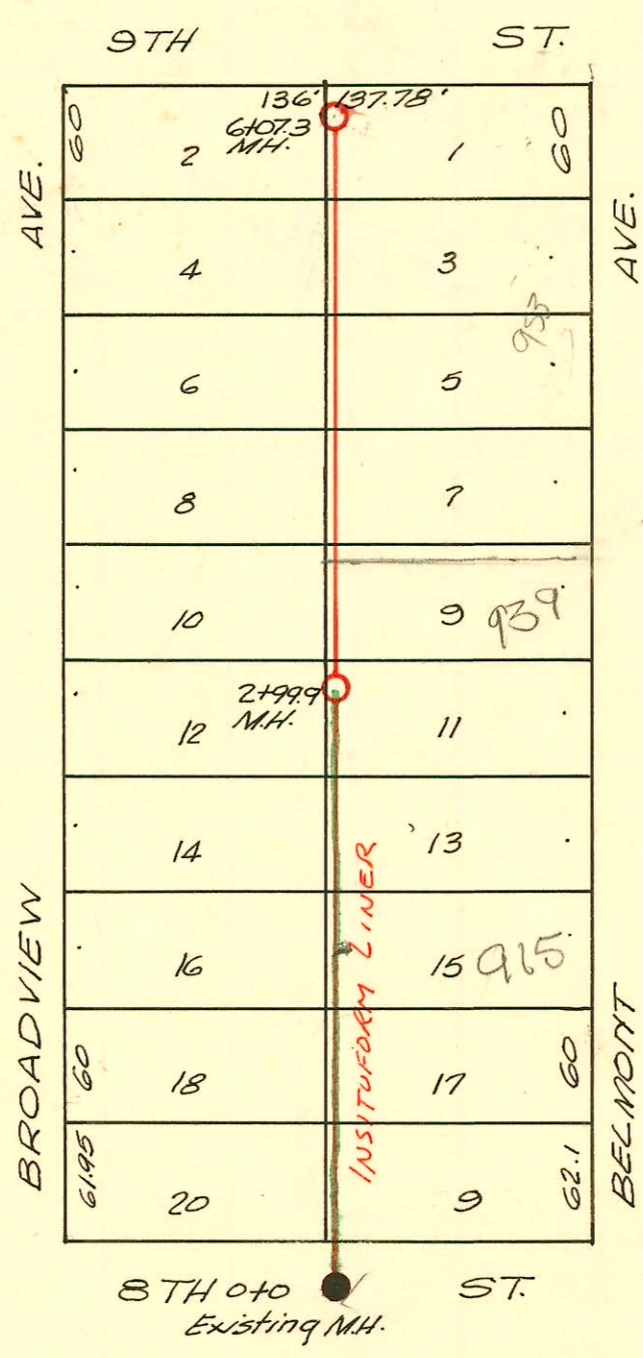

SCALE: 1" = 100'

1991 SAN. SEW RECONSTRUCTION
PROGRAM PHASE II
Built By INSITUFORM PLAINS

W.B. Carter Const. Co. Proj. No. C 27-30
Lateral 29 Dist. A, Main 12.
1948

RECONNECTIONS

STATION	ADDRESS	DIRECTION
2+91	933 N. Belmont	East
2+31.9	929 N. Belmont	East
1+73.6	923 N. Belmont	East
1+45.7	915 N. Belmont ^R	East
0+97.3	907 N. Belmont	East
0+56.5	901 N. Belmont	East

2003-02764

- Roto Rooter - 4" sch 40 x 20 + apx 10' of pipe - 10/24/03

CONSTRUCTION RECORD						SERVICE RECORD						
STATION	ELEVATION		Depth	MANHOLE	4-INCH "Y" BRANCHES		No. of Permit		House Number		DATE OF PERMITS	
	Ground	Grade			West	East	North West	South East	North West	South East	North West	South East
0+0	189.0	178.83	11.14	0+0	+49.9	+46.9			901 N. Belmont			4-12-49
1+0	188.7	178.93	10.44		+09.7	+06.7						
					+70.9	+67.9			923 N. Belmont			4-12-49
2+0	186.6	179.03	7.75		+31.2	+28.2			929 N. Belmont			3-17-49
					+91.9	+88.9			933 N. Belmont			3-17-49
2+99.9	187.0	179.13	8.45	2+99.9								
3+0	187.0				+49.9	3 +46.9		92-4249-7	939 N. Belmont			9-20-48
								# 2249				3-17-49
4+0	186.8	179.23	8.22		+10.3	+07.3						
					+70.8	+67.8						
5+0	186.0	179.33	7.22		+31.1	+28.1			757 N. Belmont			3-17-49
					+88.8	+85.8			961 N. Belmont			3-17-49
6+0	186.3	179.43	7.52									
6+07.3	186.3	179.45	7.46	6+07.3								

2246 - Top - 953 N. Belmont - 3-17-49 - Rupp Pully Co.
 # 2247 - Top - 949 N. Belmont - 3-17-49 - Rupp Pully Co.
 # 2248 - Top - 943 N. Belmont - 3-17-49 - Rupp Pully Co.
 # 2466 - Top - 907 N. Belmont - 4-12-49 - Rupp Pully
 # 2468 - Top - 915 N. Belmont - 4-12-49 - Rupp Pully - see next pg