


SERVICE RECORD

CONSTRUCTION RECORD

FOR PLAN SEE PAGE 68  
" DETAIL OF MHS & V'S (OVER)

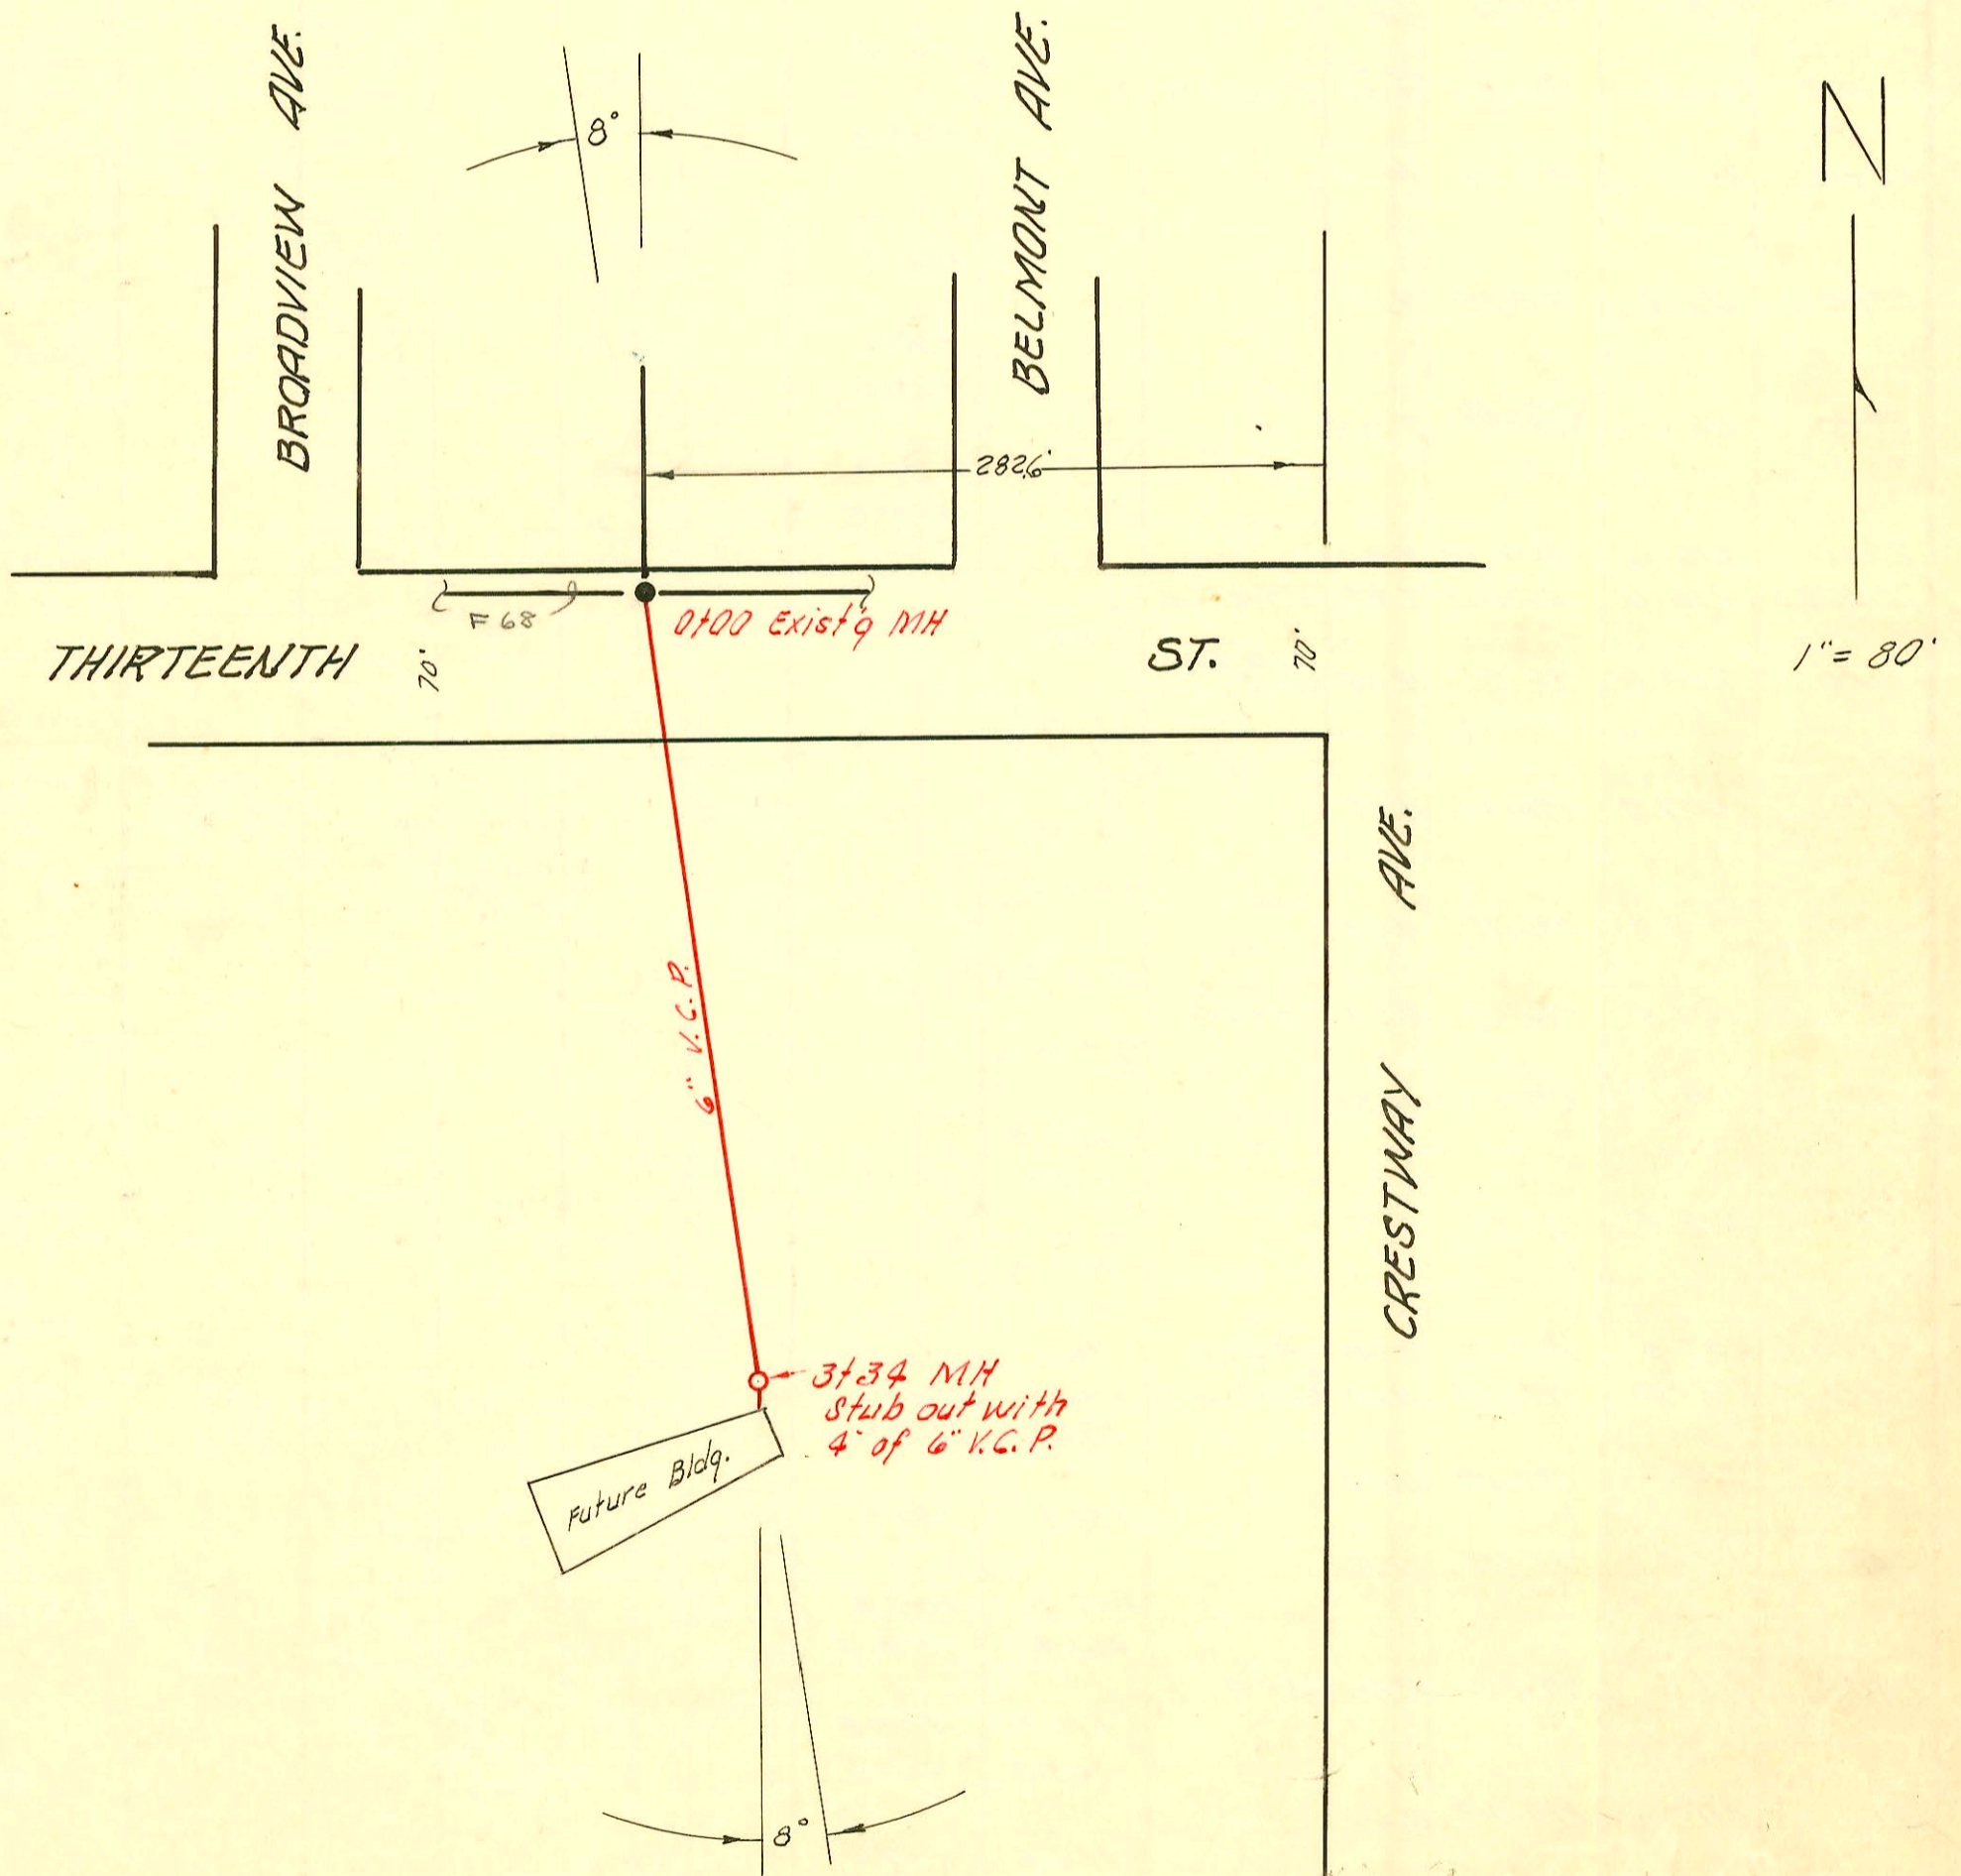

### MACDONALD PARK

PRIVATE 6" SAN. SEWER

JUNE 15, 1956

