

(Handwritten)
#5499, 3400 Grand - 4" stub connection in Register - Turner - 10-29-57 new M.H.


(Hospital)
#8404 - 6" tap MH #641.2 - Pine Ridge - 10-20-58 6" tap MH 8+46.6

2000-00439-2116100-3214 Zimmerly - KS Ditching
4"40 PVC, 1 twin 40, 2V22, 1V45, tied to claytile
72' N of MH 5746-230

W.B. CARTER 1948
ALL SAINTS PARISH S.S.

Plot of 10-64 F-73A

SEE Bk. D. Pg. 1

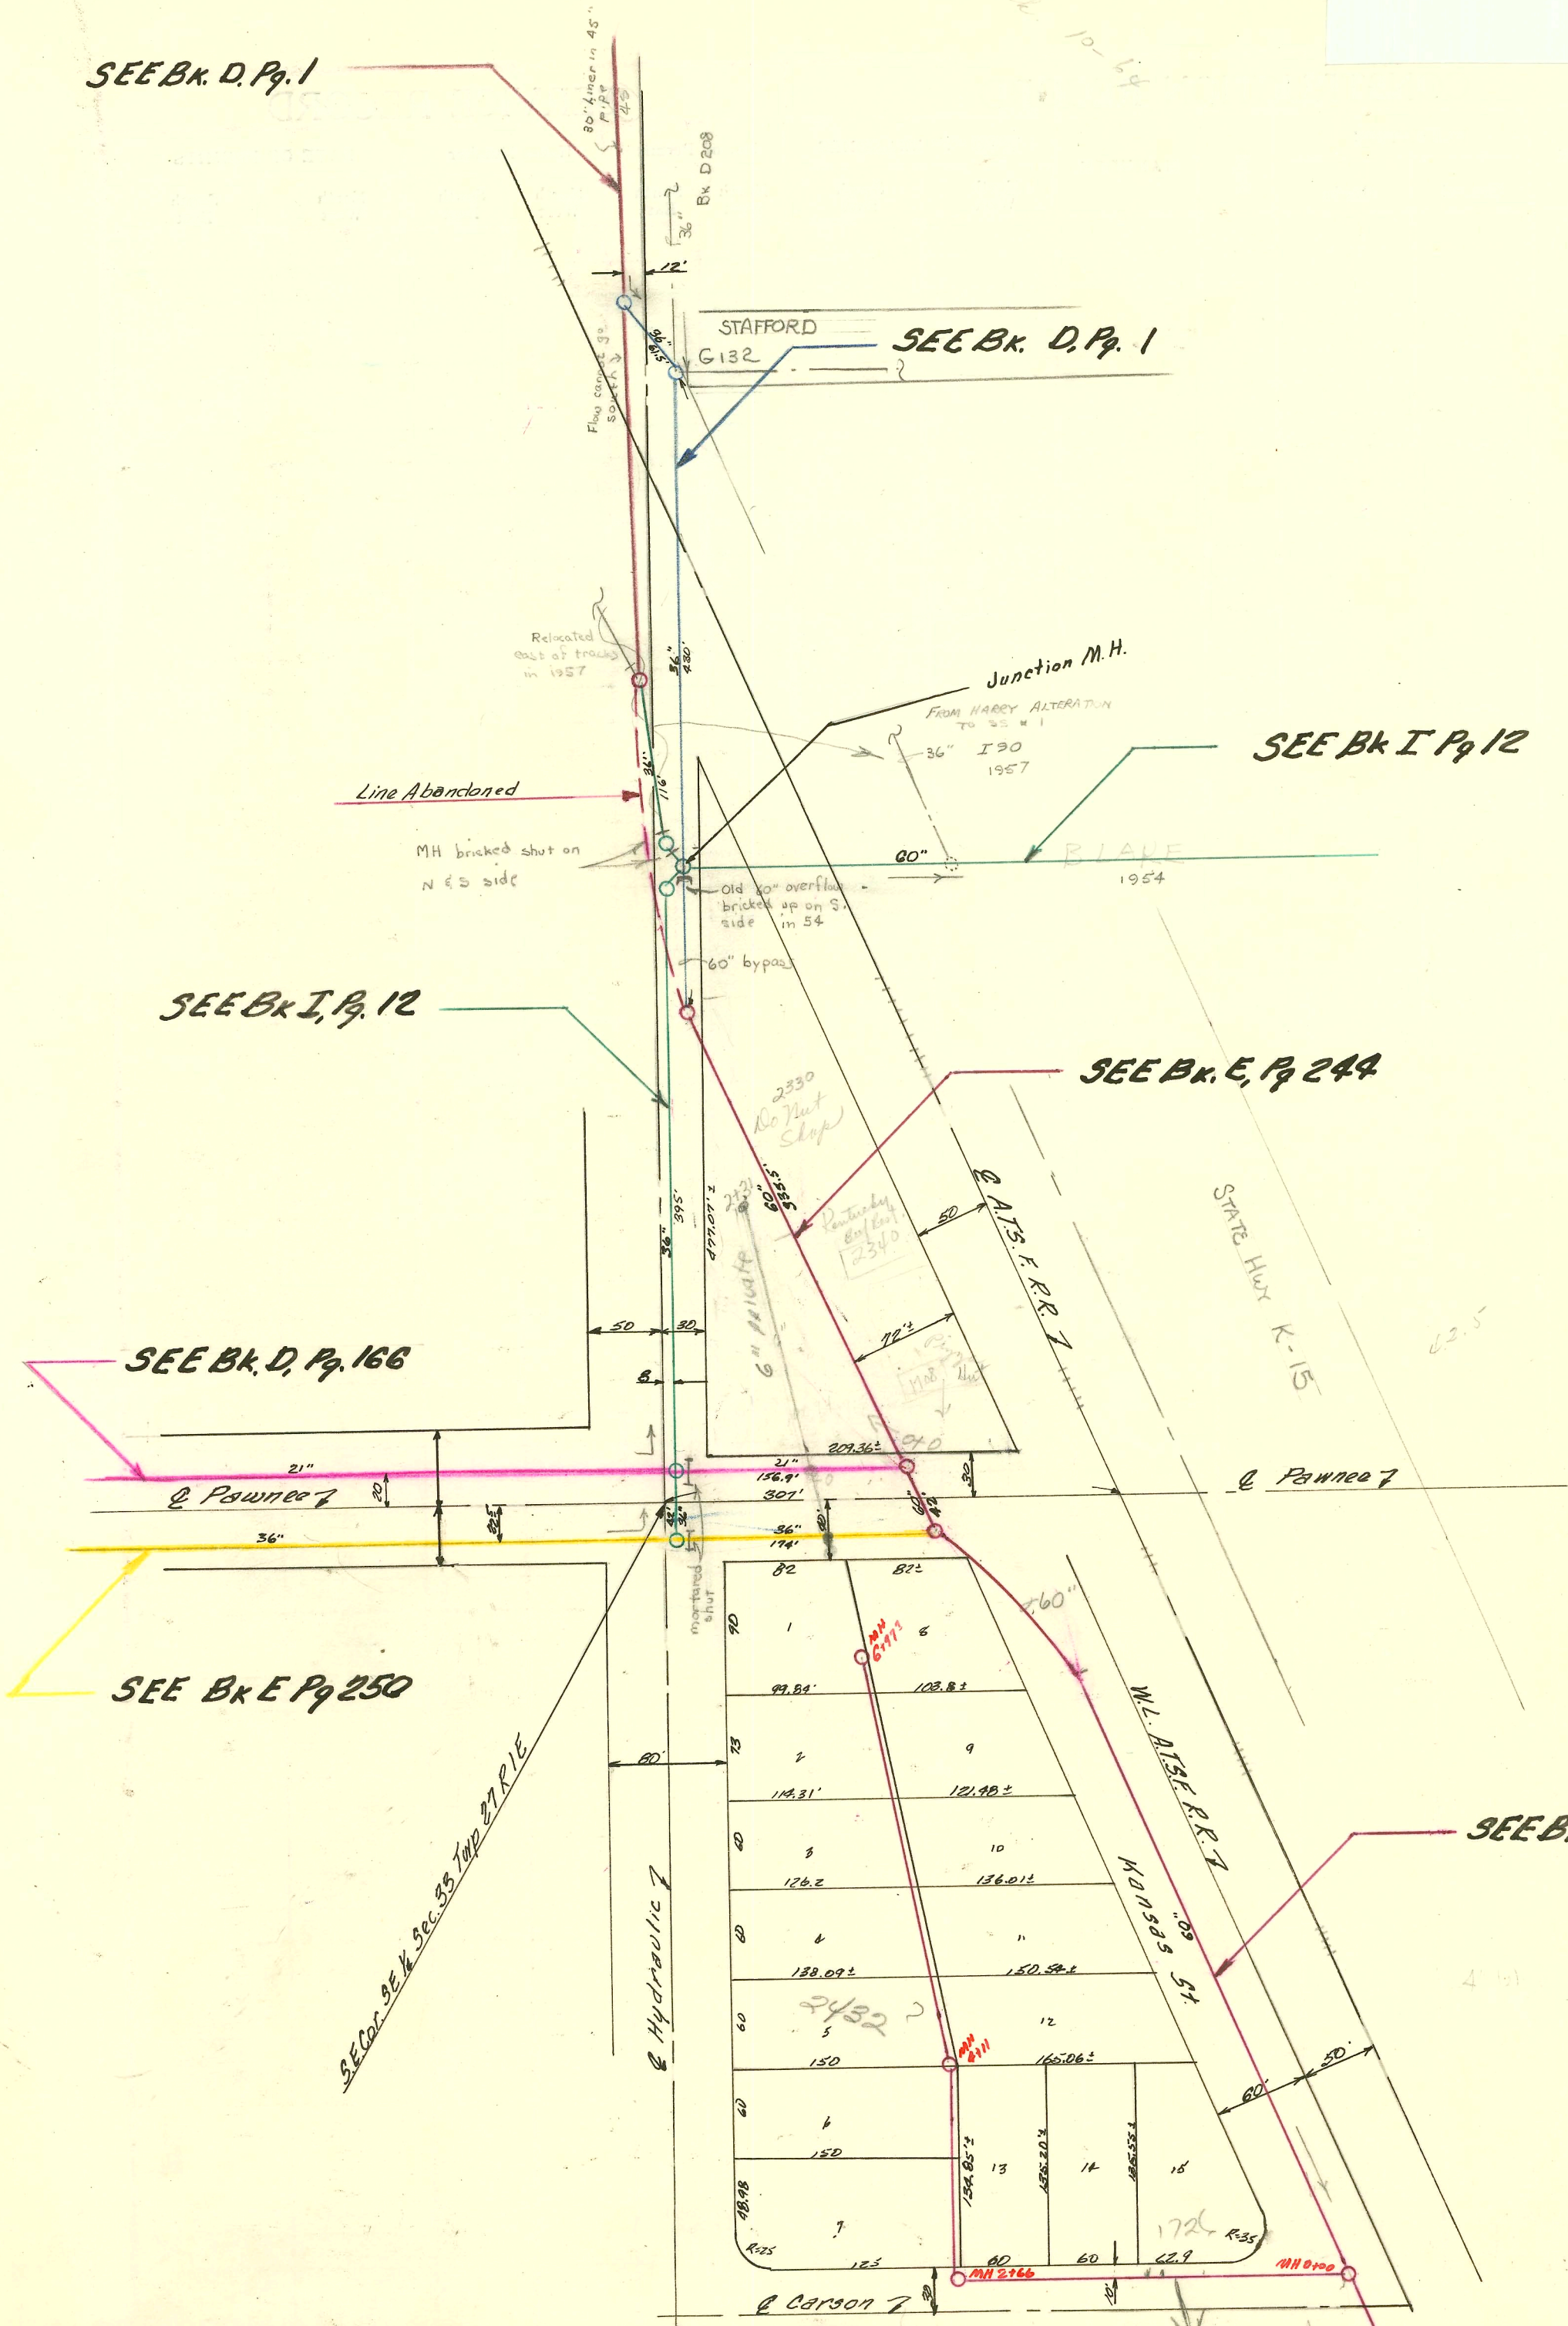

SEE Bk. D. Pg. 1

SEE Bk I Pg 12

SEE Bk I, Pg. 12

SEE Bk. E, Pg 244

SEE Bk. D, Pg. 166

SEE Bk E Pg 250

SEE Bk. E, Pg 244

Layout of San Sewers in the vicinity of Hydraulic & Santa Fe R.R. Drawn April, 1964

TRAP AREA

TURN THE PAGE

SCALE 1" = 100'

CONSTRUCTION RECORD						SERVICE RECORD							
STATION	ELEVATION		Depth	MANHOLE	4-INCH "Y" BRANCHES		No. of Permit		House Number		DATE OF PERMITS		
	Ground	Grade			North West <i>RIGHT</i>	South East <i>LEFT</i>	North West	South East	North West	South East	North West	South East	
0+00				0+00	West	East							
1+00						1+01.5							
2+00													
2+45.2				2+45.2									
3+00													
4+00													
5+00													
6+00													
6+41.2				6+41.2									
7+00													
						7+02							
						+92.2							
8+00													
8+46.6				8+46.6									
9+00													
10+00													
11+00													
11+99				11+99									
12+00													
						12+99							
13+00													
13+84.6				13+84.6									
14+00													
						14+28	14+57.6	#905	#906	all Saint School	all Saint School	Burton House 9-13-48	9-13-48
15+00							15+12.8	#909		all Saint School			9-13-48
							+65.0	#910		all Saint School			9-13-48
15+84.6			9.5	15+84.6	M.H. Tap			639688		all Saint School			6-25-73
16+00							16+31.3	#911		all Saint School			9-13-48
							+34						
							+86.3	#912		all Saint School			9-13-48
17+00							17+21	#913		all Saint School			9-13-48
17+35.3				17+35.3 O.H.									

St. Josephs Hospital Private Sewer.

Line #1

0+00

0+00 Exist M.H.

2+65 M.H.

4+92 M.H. End Line #1

Line #2

0+00

0+00 = 2+65 M.H. Line #1

0+39.0

63992

11315 (Opp. Clifton Drive)

11-15-77

2+26 M.H. End Line #2

- #1250 - Tap - all Saints School - 10-19-48 - Repston P.L.G. Co.
- #476 - Tap - 1446 S. Halloran - 4-13-50 - Curran P.L.G. Co.
- #2094 - Tap - All Saints School - 8-24-50 - Repston P.L.G. Co. (Connected into O.H. 17+35.3).
- #03485 - 3313 E. Grand - #C2485 - Seal off - 12/31/67 - East Bldg - All Saints School - Al Henning
- #4348 - Tap - St. Josephs Hospital - 4-12-51 - Repston - Turner Co.
- #4349 - Storm Water Sewer Tap + Permit - St. Josephs Hospital - 4-12-51 - Repston - Turner Co.
- #107 - 1102 S. ... Tap - 2-16-54 - ... P.L.G. Co.