


SERVICE RECORD

CONSTRUCTION RECORD

2000-00764 - 3/27/00 - 1942 N Hydraulic - AE Henning - Fernco 2' from main - 1-way co - 1V45, 2H45, 2 Fernco.

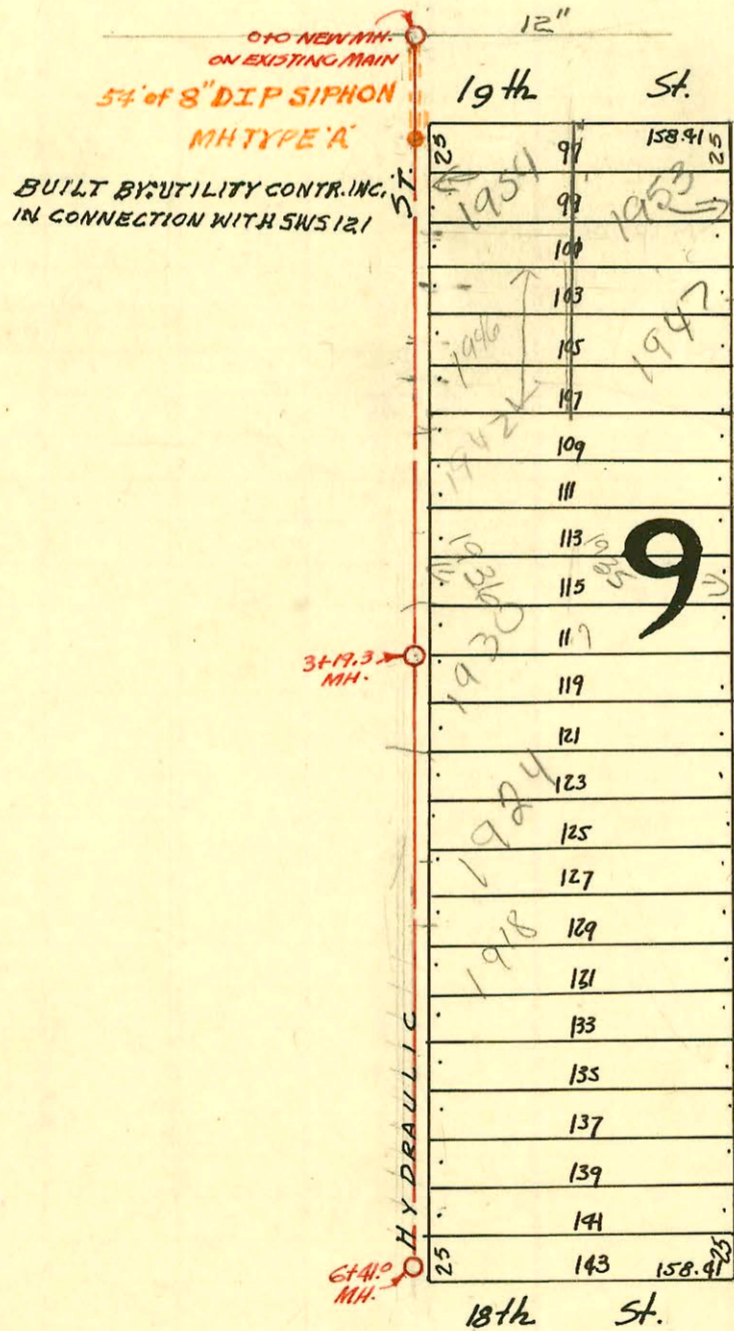

Station Calver said below  
 broke line @ 1947 tried it into wye  
 in 1953 because he didn't want to  
 fix it. Things were so heated at side  
 Homeowner of 1953 called 911 - Calver  
 told Calver it was his responsibility to  
 fix it + absorb cost - Calver would  
 1953 homeowner to pay cost

Rec'd copy of letter  
 Dtd 11-13-52 re signed  
 by Willie A. Brazill for  
 FLUORA Brazill  
 GRANTING FRANK Buckley  
 permission to have sewer  
 line for 1947 N Kansas  
 repaired where it  
 crosses Lot 602 1946 N  
 Hydraulic  
 &c

1=100

LAT. 10 DIST. 7 MAIN 12

W. B. CARTER CONST. CO.

Date 12-9-48

#B760 Seal off - 1943 N. Hydraulic - headgepath. 1-29-64  
 #B761 Seal off - 1945 N. Hydraulic " " 1-29-64 - priv. line conn.

CONSTRUCTION RECORD						SERVICE RECORD						
STATION	ELEVATION		Depth	MANHOLE	4-INCH "Y" BRANCHES		No. of Permit		House Number		DATE OF PERMITS	
	Ground	Grade			North West	South East	North West	South East	North West	South East	North West	South East
0+0	120.3	115.05	5.80	New MH. 0+0 0+54								
1+0	120.9	115.15	6.41									
2+0	121.0	115.25	5.89									
3+0	120.7	115.35	5.40									
3+19.3	121.7	115.37	6.50	3+19.3								
4+0	121.5	115.45	6.29									
5+0	121.5	115.55	6.33									
6+0	121.9	115.65	6.34									
6+41.0	121.6	115.69	6.31	6+41.0								

2003-01401- 5/23/03- 1953 Kansas - Glover - City crushed wye, Glover poured concrete for 30' City, made new tap 69.3' S of MH 0+54 (1+23.3) 14" Sch 40, 1142, 1145, 1122 NOTE: Glover hit line for 1946 Kansas and repaired it per City Crew

2002-03215 11/26/02 1947 N Kansas - Wichita Reg. City Wye repair 75.6' S of MH 0+54 (1+29.6) 14" Sch 40 2" W.I.N. CO, 21122, 2122

# 822 - Tap in Hydraulic Avenue Sewer - 1943 N. Hydraulic - 5'-2.50 - H.H. Crickmore. (\$20.00 special fee paid 5-2-50)  
 # 7116 - (use Sewer Crew for 1943 Hydraulic) 7116 bonded 12-29-55  
 (1945 N. Hydraulic temporarily committed to 1943)  
 # 1947 - Tap (1953 N Kansas) 9-10-54 - Sand & Refer to repair 2003-01401  
 96-820-7 1946 N Hydraulic R 1-24-96 - repl 5' section of line 4" SDR 35