


SERVICE RECORD

CONSTRUCTION RECORD

DATE	DESCRIPTION	BY	REMARKS

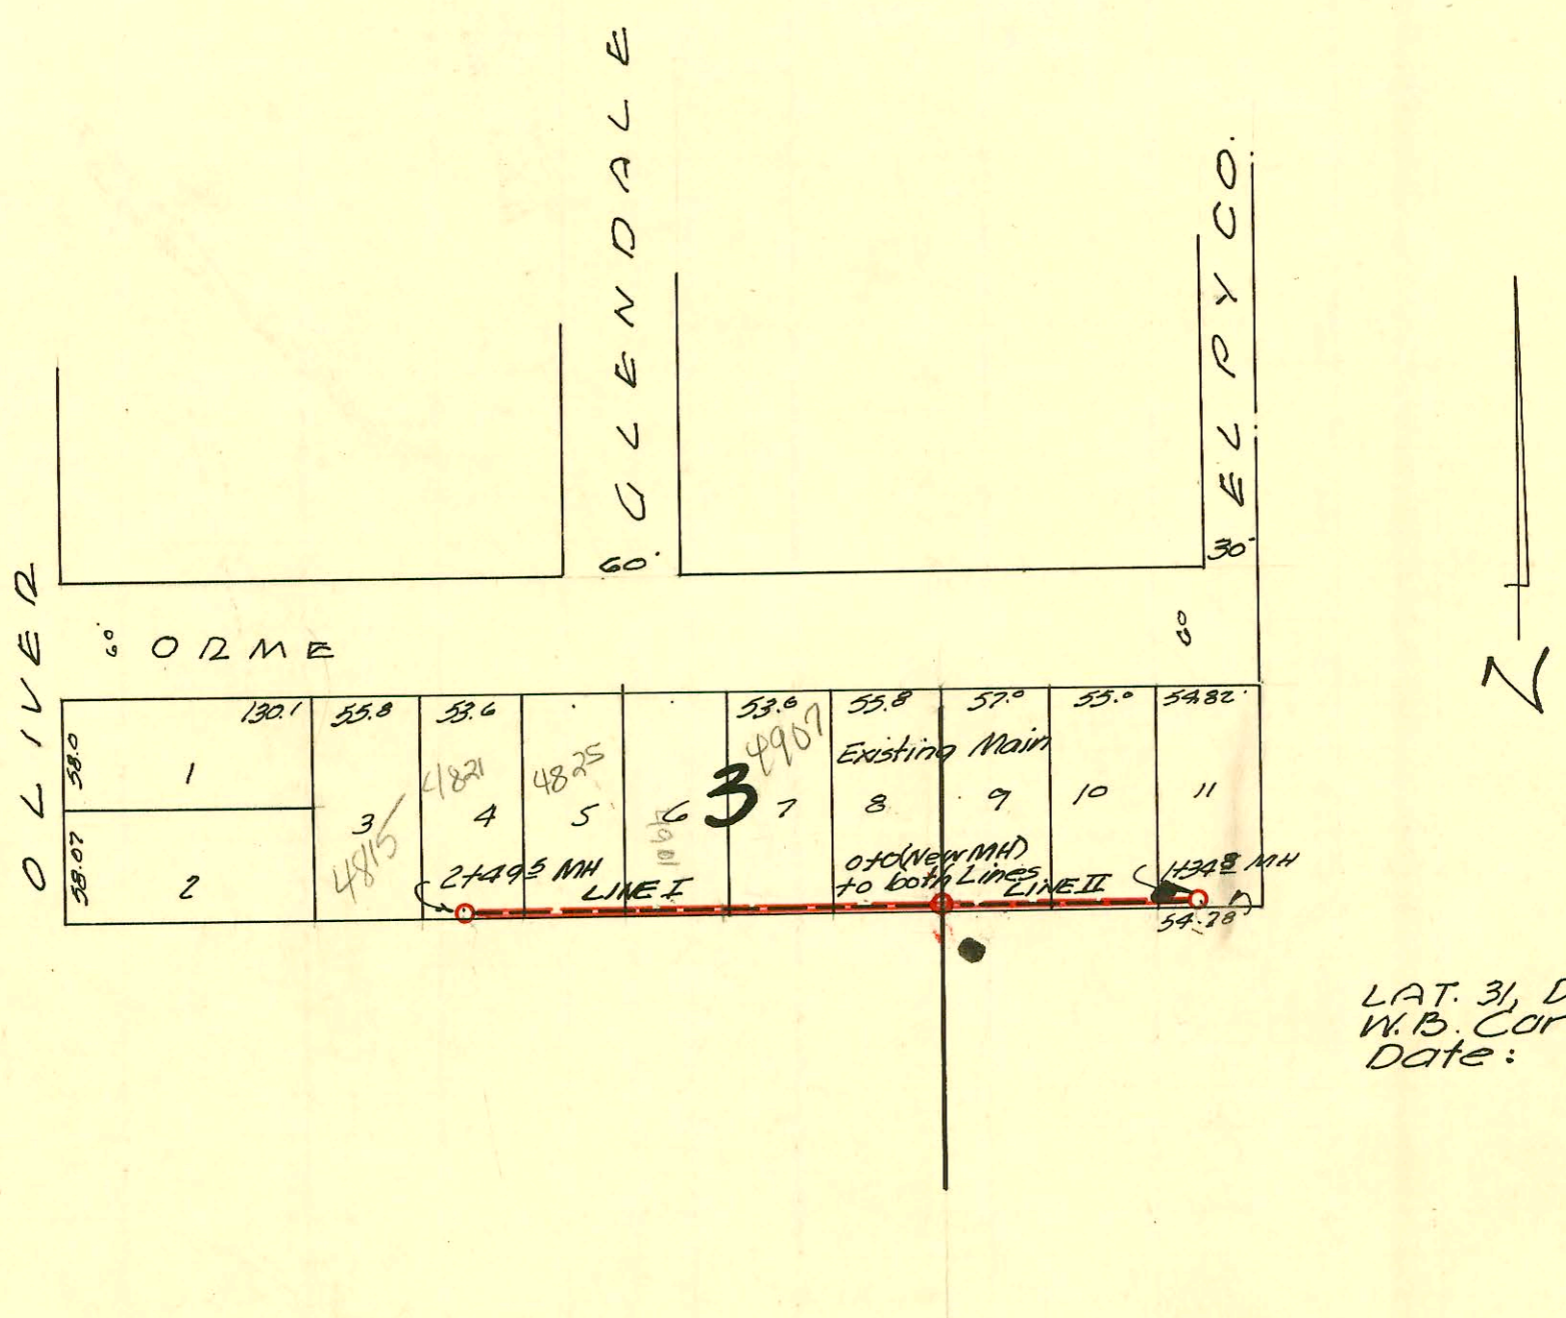

LAT. 31, D.C.S. MAIN 12
 W.B. Carter Const. Co.
 Date: 1949

B. M. 156.43 "G" in Globe W. end Rd. So. Side Gilbert.

CONSTRUCTION RECORD

SERVICE RECORD

STATION	ELEVATION		Depth	MANHOLE	4-INCH "Y" BRANCHES		No. of Permit		House Number		DATE OF PERMITS	
	Ground	Grade			North West	South East	North West	South East	North West	South East	North West	South East
Line I 0+0	156.8	147.37	9.82	0+0	0+22.8 0+59.0		#1850 2003-02458 #2106		4911 E. Orme 4917 E R Orme	see Below	3-5-49 9-23-49 3-5-49	
1+0	157.8	147.47	10.89		1+13.6 1+66.1(?)		#2102 #2102		4901 E R Orme 4815 E R Orme		2-13-92 3-11-49 8-14-49 3-5-49	
2+0	157.9	147.57	10.71		2+19.6		#1543 #2103		4821 E R Orme		1-7-86 3-5-49	
2+49.5	158.0	147.62	10.70	2+49.5								
LINE II 0+0	156.8	147.37	9.82	0+0 (Line I) 0+0	0+38.2		#1547 #1851		4917 E R E. Orme		1-2-86 3-5-49	
1+0	154.8	145.67	9.60		1+04.6 (+13.5 ft) 1+25.2		#1855 #2107 #2268 #119		4925 E R Orme 4931 E R Orme		12-18-44 3-5-49 5-24-49 4-27-49	
1+34.8	154.2	145.71	8.84	1+34.8								

2003-02458 9/23/03 Reddi Rootr- Pipeburst replacement 4"SDR35, City Wye repair 59' W of MH 0+00(0+59) 4"Precco- 4"PVC-ITWINCO, 1V45, 2H45, 1W45