


SERVICE RECORD

CONSTRUCTION RECORD

DATE OF SERVICE		METER NUMBER		NO. OF FEET		METER SIZE		METER TYPE		METER LOCATION	
Year	Month	Old	New	From	To	Size	Type	Location	Notes	Notes	Notes

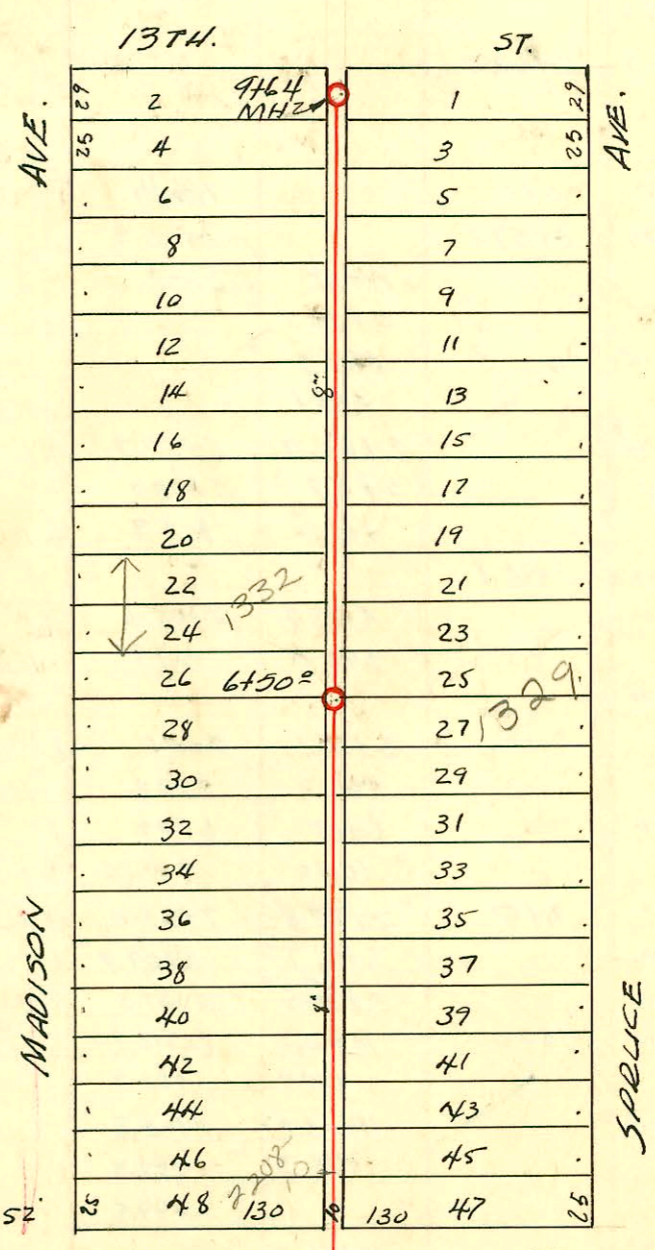

W.B. Carter Const. Co.
 1949
 Lot. G, Dist. E, Main 12
 Proj. No. C28-28

Ash

010 (old meter)

12TH.

3+32 MH2

60 ST.

↑ 2201

2221

CONSTRUCTION RECORD						SERVICE RECORD						
STATION	ELEVATION		Depth	MANHOLE	4-INCH "Y" BRANCHES		No. of Permit		House Number		DATE OF PERMITS	
	Ground	Grade			North West	South East	North West	South East	North West	South East	North West	South East
0+0	116.5	110.52	6.90	0+0 (old)								
1+0	116.4	110.62	6.33									
2+0	116.8	110.72	6.82									
3+0	116.9	110.82	6.46									
3+32	117.3	110.85 ^m	6.86	3+32	3+77.7	3+74.7						
4+0	116.7	111.13	6.54		4+02.3	4+23.2						
					+26.5	+50.5						
					+53.5	+77.5						
					+80.5	+98.2						
5+0	117.2	111.23	6.45		5+01.7	5+25.8						
					+28.8	+50.0						
					+53.0	+74.6						
					+77.6	+99.2						
6+0	116.6	111.33	6.28		6+02.2	6+23.5						
					+26.5	+53.2						
6+50	116.9	111.38		6+50	+56.2	+74.6						
					+77.6	+99.0						
7+0	117.1	111.43	6.16		7+02.0	7+26.2						
					+29.8	+50.0						
					+53.0	+74.0						
					+77.0							
8+0	117.3	111.53	6.26		8+04	8+01.0						
					+28	+25.0						
					+52.0	+49.5						
					+76.0	+73.0						
9+0	117.8	111.63	6.72		8+90.0	9+01						
					+30.2	+27.2						
					+52.2	+49.3						
9+64	118.0	111.67	6.88	9+64								

#1201 NE 2221 E. 12th C. L. Rutledge 9-10-80

2043 - 2215 E. 13th 12-8-50 Al Henning

#3143 - 2nd - 1332 N. Madison - 11-8-52 - Joe Mc Donald
1024 Top 2201 E. 12th 6-7-56 Al Henning