


SERVICE RECORD

CONSTRUCTION RECORD

DATE OF RECORD	NO. OF RECORDS	DATE OF RECORD	NO. OF RECORDS

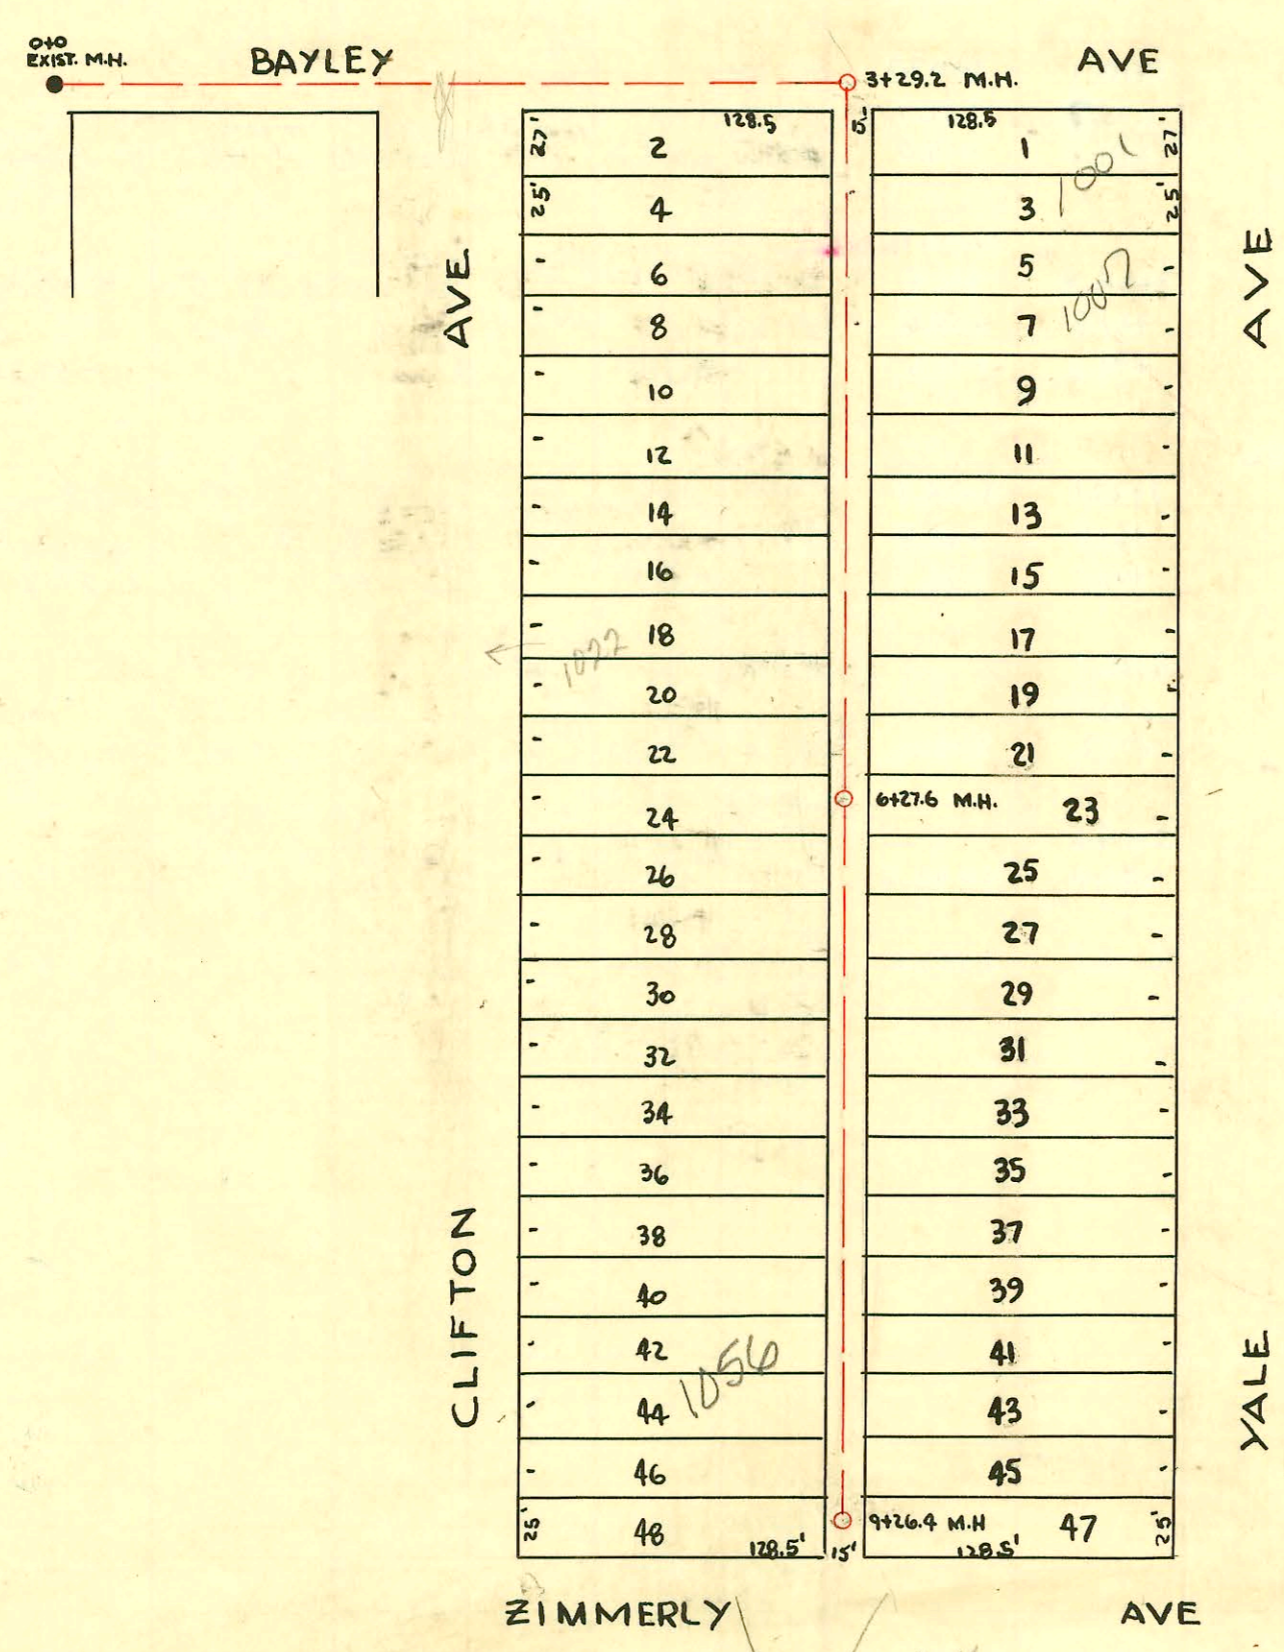

1" = 80

Lat numbers should be reversed

LAT. 15 DIST 6 SS 12  
 W.B. CARTER CONST. CO. APRIL 1949  
 PROJ. NO. C-28-36

CONSTRUCTION RECORD						SERVICE RECORD						
STATION	ELEVATION		Depth	MANHOLE	4-INCH "Y" BRANCHES		No. of Permit		House Number		DATE OF PERMITS	
	Ground	Grade			North West	South East	North West	South East	North West	South East	North West	South East
0+0		129.14	8.74									
1+0	138.4	129.64	9.13									
2+0	141.5	130.14	10.56									
3+0	141.6	130.64	11.21									
3+29.2	141.2	130.77 out 130.00 in	11.72 (O) 9.63 (I)	3+29.2								
					3+67.0			13222 #807	1000 S. Clifton		3-15-85 7-8-49	
						3+81.0		#195	1001 S. Yale			5-9-49
4+0	142.4	133.70	9.30		4+21.6	4+24.6		#33967 #970 #26590 #7713	1010 S. Clifton	1007 S. R 103 S. B 1017 S. Yale	9-30-91 2-14-50	10-22-49 5-11-50 11-21-50 8-3-49
					+66.4	4+69.4						
					+91.0	4+94.0		82-8896-7				
5+0	144.0	134.70	9.72		5+12.3	5+15.3						
					+41.5	+44.5						
					+69.8	+72.8		#6158 #1090	1022 S. Clifton	1023 S. Yale	8-29-55	2-1-84 7-14-49
6+0	147.9	135.70	12.61									
6+27.6		135.99	13.36	6+27.6	6+54.4	6+57.4		#196	1030 S. Clifton			
					+88.4	+91.4		#1156 #3224	1035 S. Yale		5-9-49 8-9-47	2-6-50
7+0	151.0	136.70	14.59		7+15.6	7+18.6						
					+39.9	7+42.9		92-910-7 #210	1041 S. Clifton	1041 S. Yale		1-22-92 2-6-50
					+68.0	+71.0						
					+92.2	+95.2		#3226		1047 S. Yale	2-25-54	2-6-50
8+0	149.9	137.70	12.73		8+20.5	8+23.5		#1409	1054 S. Clifton		8-27-49	
					+72.0	+75.0		#4871 #677	1055 S. Yale	1054 S. Yale	6-5-51	6-27-49
9+0	149.8	138.70	12.35		9+00.5	9+03.5		#4872 #4770	1058 S. Clifton	1055 S. Yale	6-5-51	5-29-51
9+26.4	150.2	138.97	11.78	9+26.4								

1999-00991-10/22/99-1007 S Yale - Bucks Backhoe-4"sch40 City Repair Tap-Donut 98'S of MH 3+29.2(4+27.2) ITRWICO, 1022

#1639 - Tap-1032 S. Clifton - Rupp Plumbg - 7-14-49  
 #2124 - Tap - 1027 S. Yale - 10-20-49 - Rupp Plumbg Co 10-20-49  
 #1115 - Tap - 1016 S. Clifton - 8-3-49 - Rupp Plumbg Co  
 #6973 - Tap - 1053 S. Yale - 1-8-52 - Coleman Plumbg Co  
 #6606 - Tap - 1030 S. Clifton - 10-1-53 Rupp Plumbg Co  
 #6159-1016 S Clifton - Used old conn. - Kennedy Plumbg 8-27-50