


SERVICE RECORD

CONSTRUCTION RECORD

DATE		DESCRIPTION		BY		CHECKED	
MO.	DAY	NO.	BY	NO.	BY	NO.	BY

13<sup>th</sup> ST.

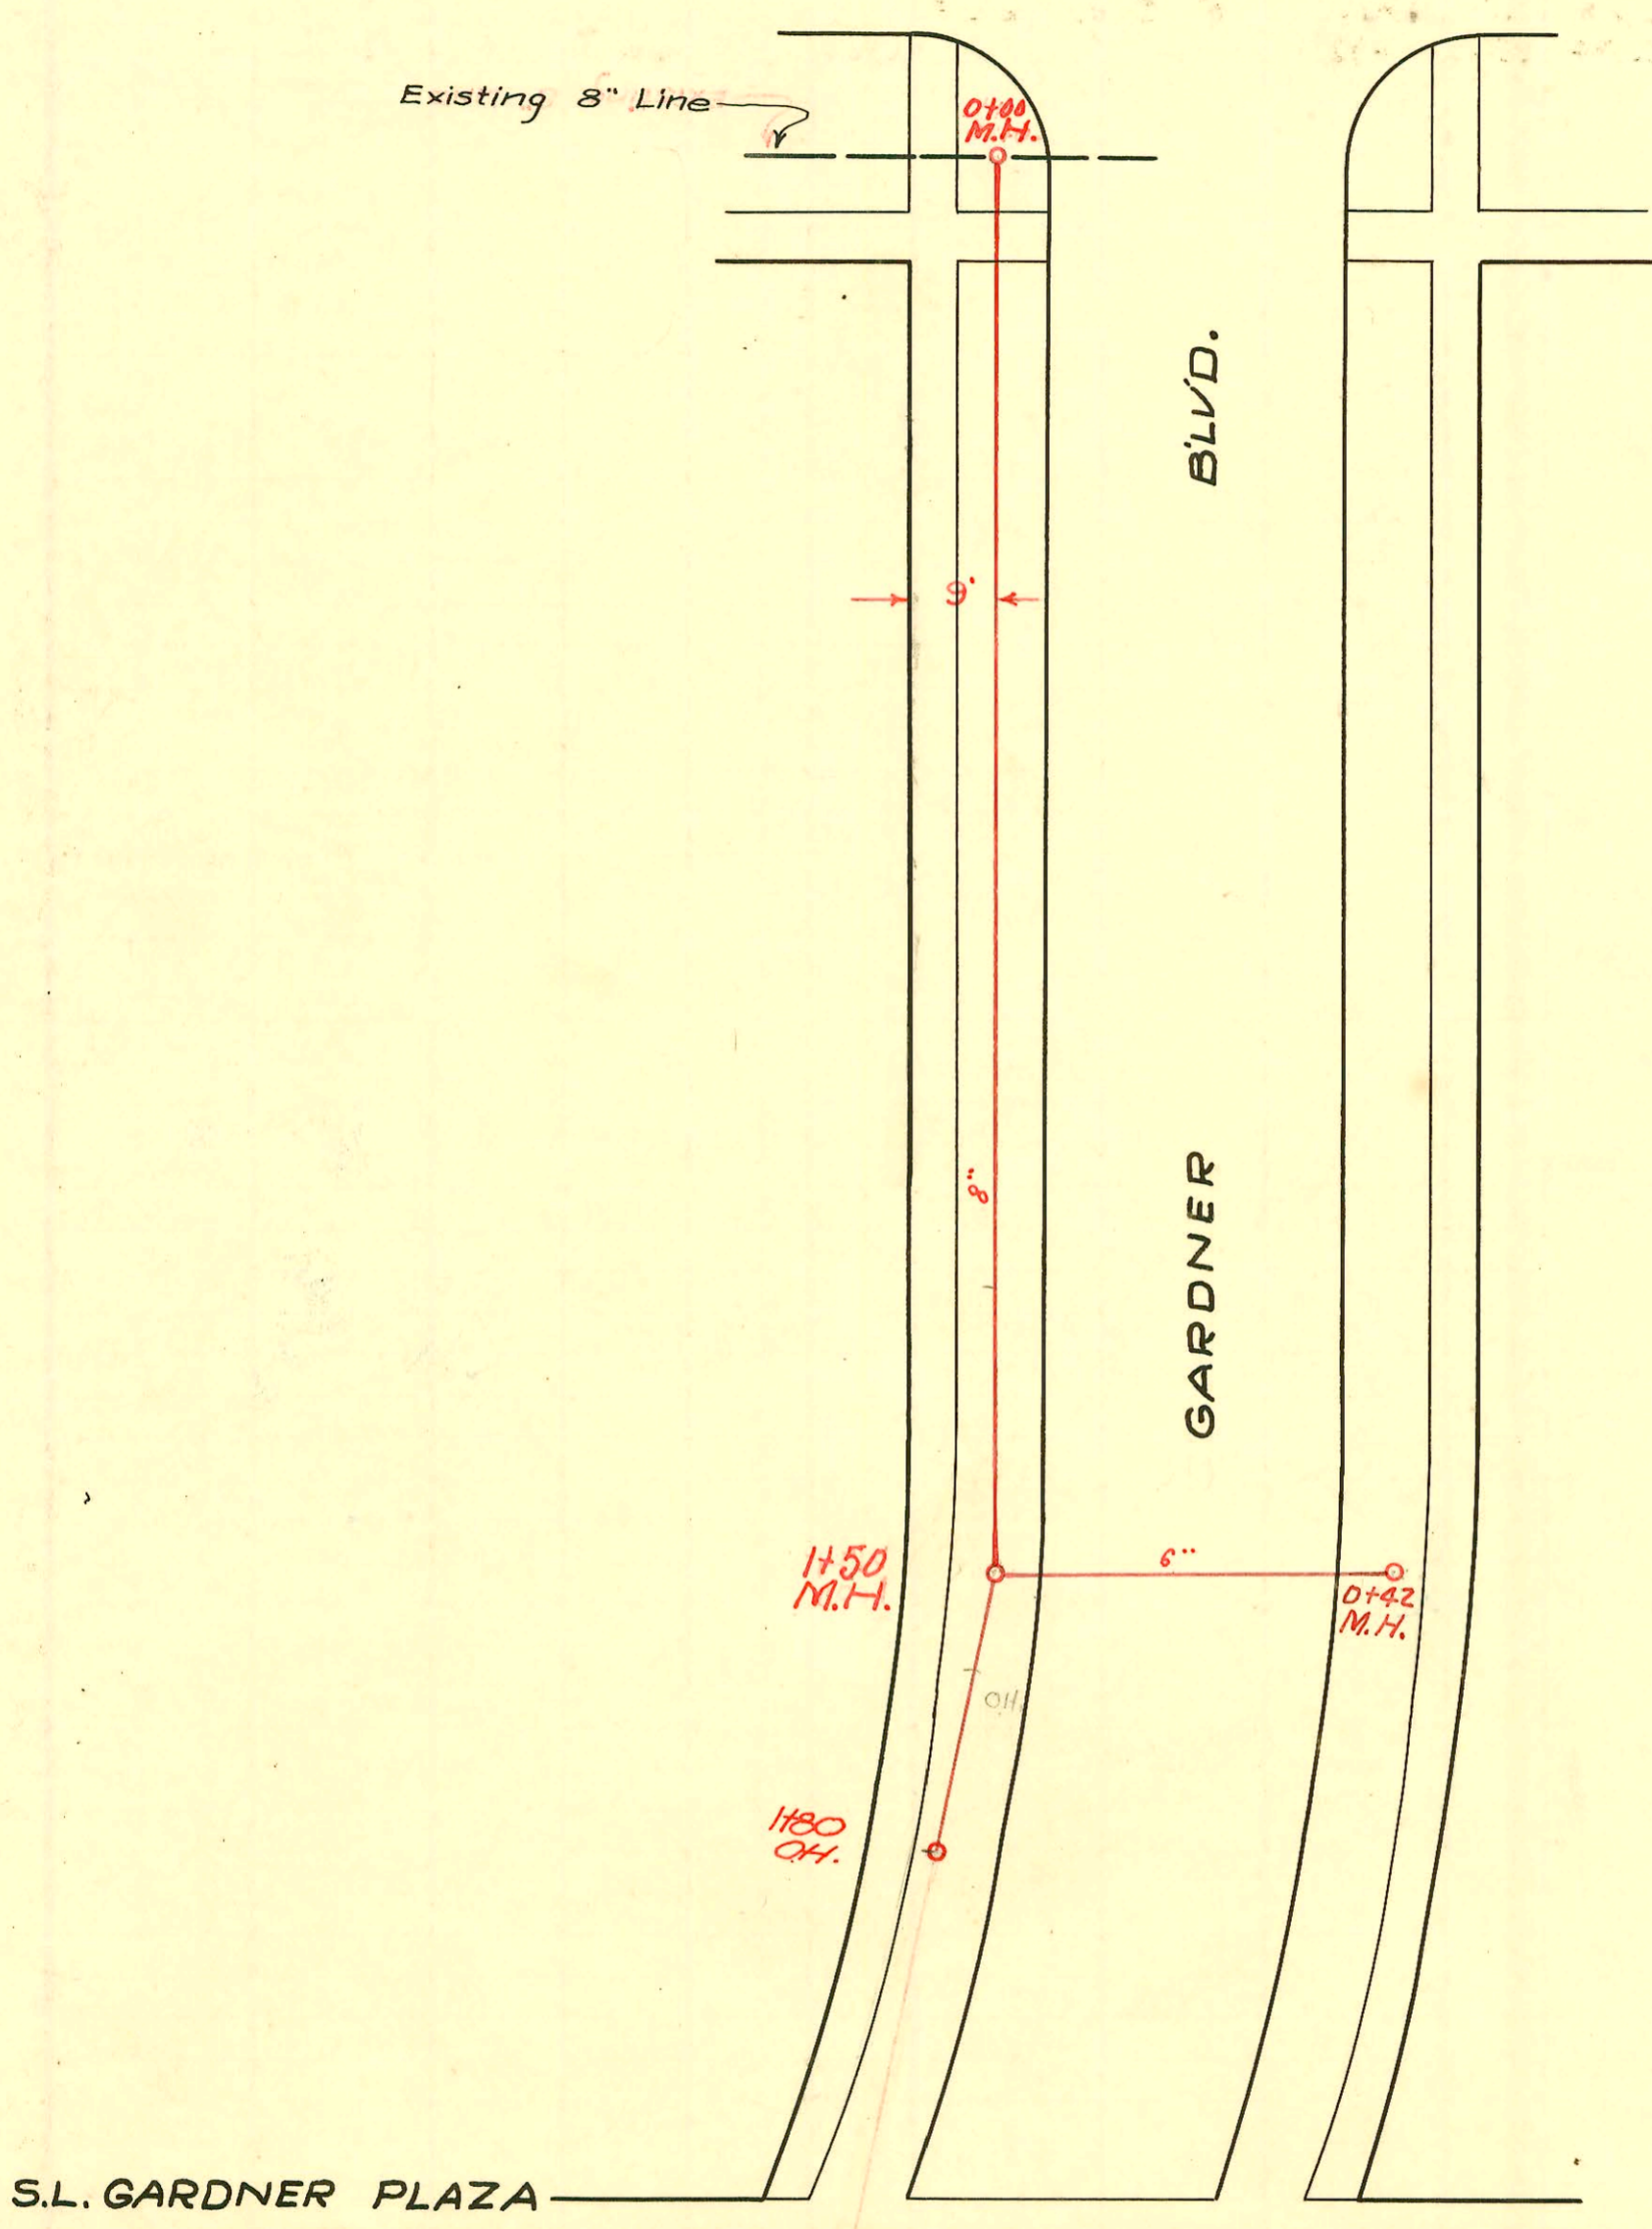

S.L. GARDNER PLAZA

GARDNER PLAZA SANITARY SEWER  
 W. B. CARTER OCT. 1949  
 PRIVATE JOB

CONSTRUCTION RECORD						SERVICE RECORD						
STATION	ELEVATION		Depth	MANHOLE	4-INCH "Y" BRANCHES		No. of Permit		House Number		DATE OF PERMITS	
	Ground	Grade			North West	South East	North West	South East	North West	South East	North West	South East
0+0	179.2	172.35	7.05	0+0								
1+0	178.3	172.45	6.09		1+05		#2259		1341-43-45-47		10-28-49	
					+38.6		#3005		1341-43-45-47		1-9-50	
1+50	179.1	172.50	6.85	1+50	1+68		#3006		1341-43-45-47		1-9-50	
					+74.5							
1+80	178.6	172.56	6.31	1+80								
0+0	179.4	172.70	6.94	0+0 = 1+50	6" Stub East		9 1/2 M.H. #2260		1340-42-44-46		10-28-49	
0+40 1/2	181.2	172.84	5.78	0+40								

Begin  
6" Stub E.

#2895 - Inf - 1325 Gardner Drive - 10-28-50 - Frederick P. Co.  
 #2366 - Private Line - 1320 Gardner - 9-13-50 - Frederick P. Co.  
 #2367 - Private Line - 1310 Gardner - 9-13-50 - Frederick P. Co.  
 #2972 - Private Line - 1300 Gardner 11-3-50 - Frederick P. Co.  
 Connected to Stub on M.H.