


SERVICE RECORD

CONSTRUCTION RECORD

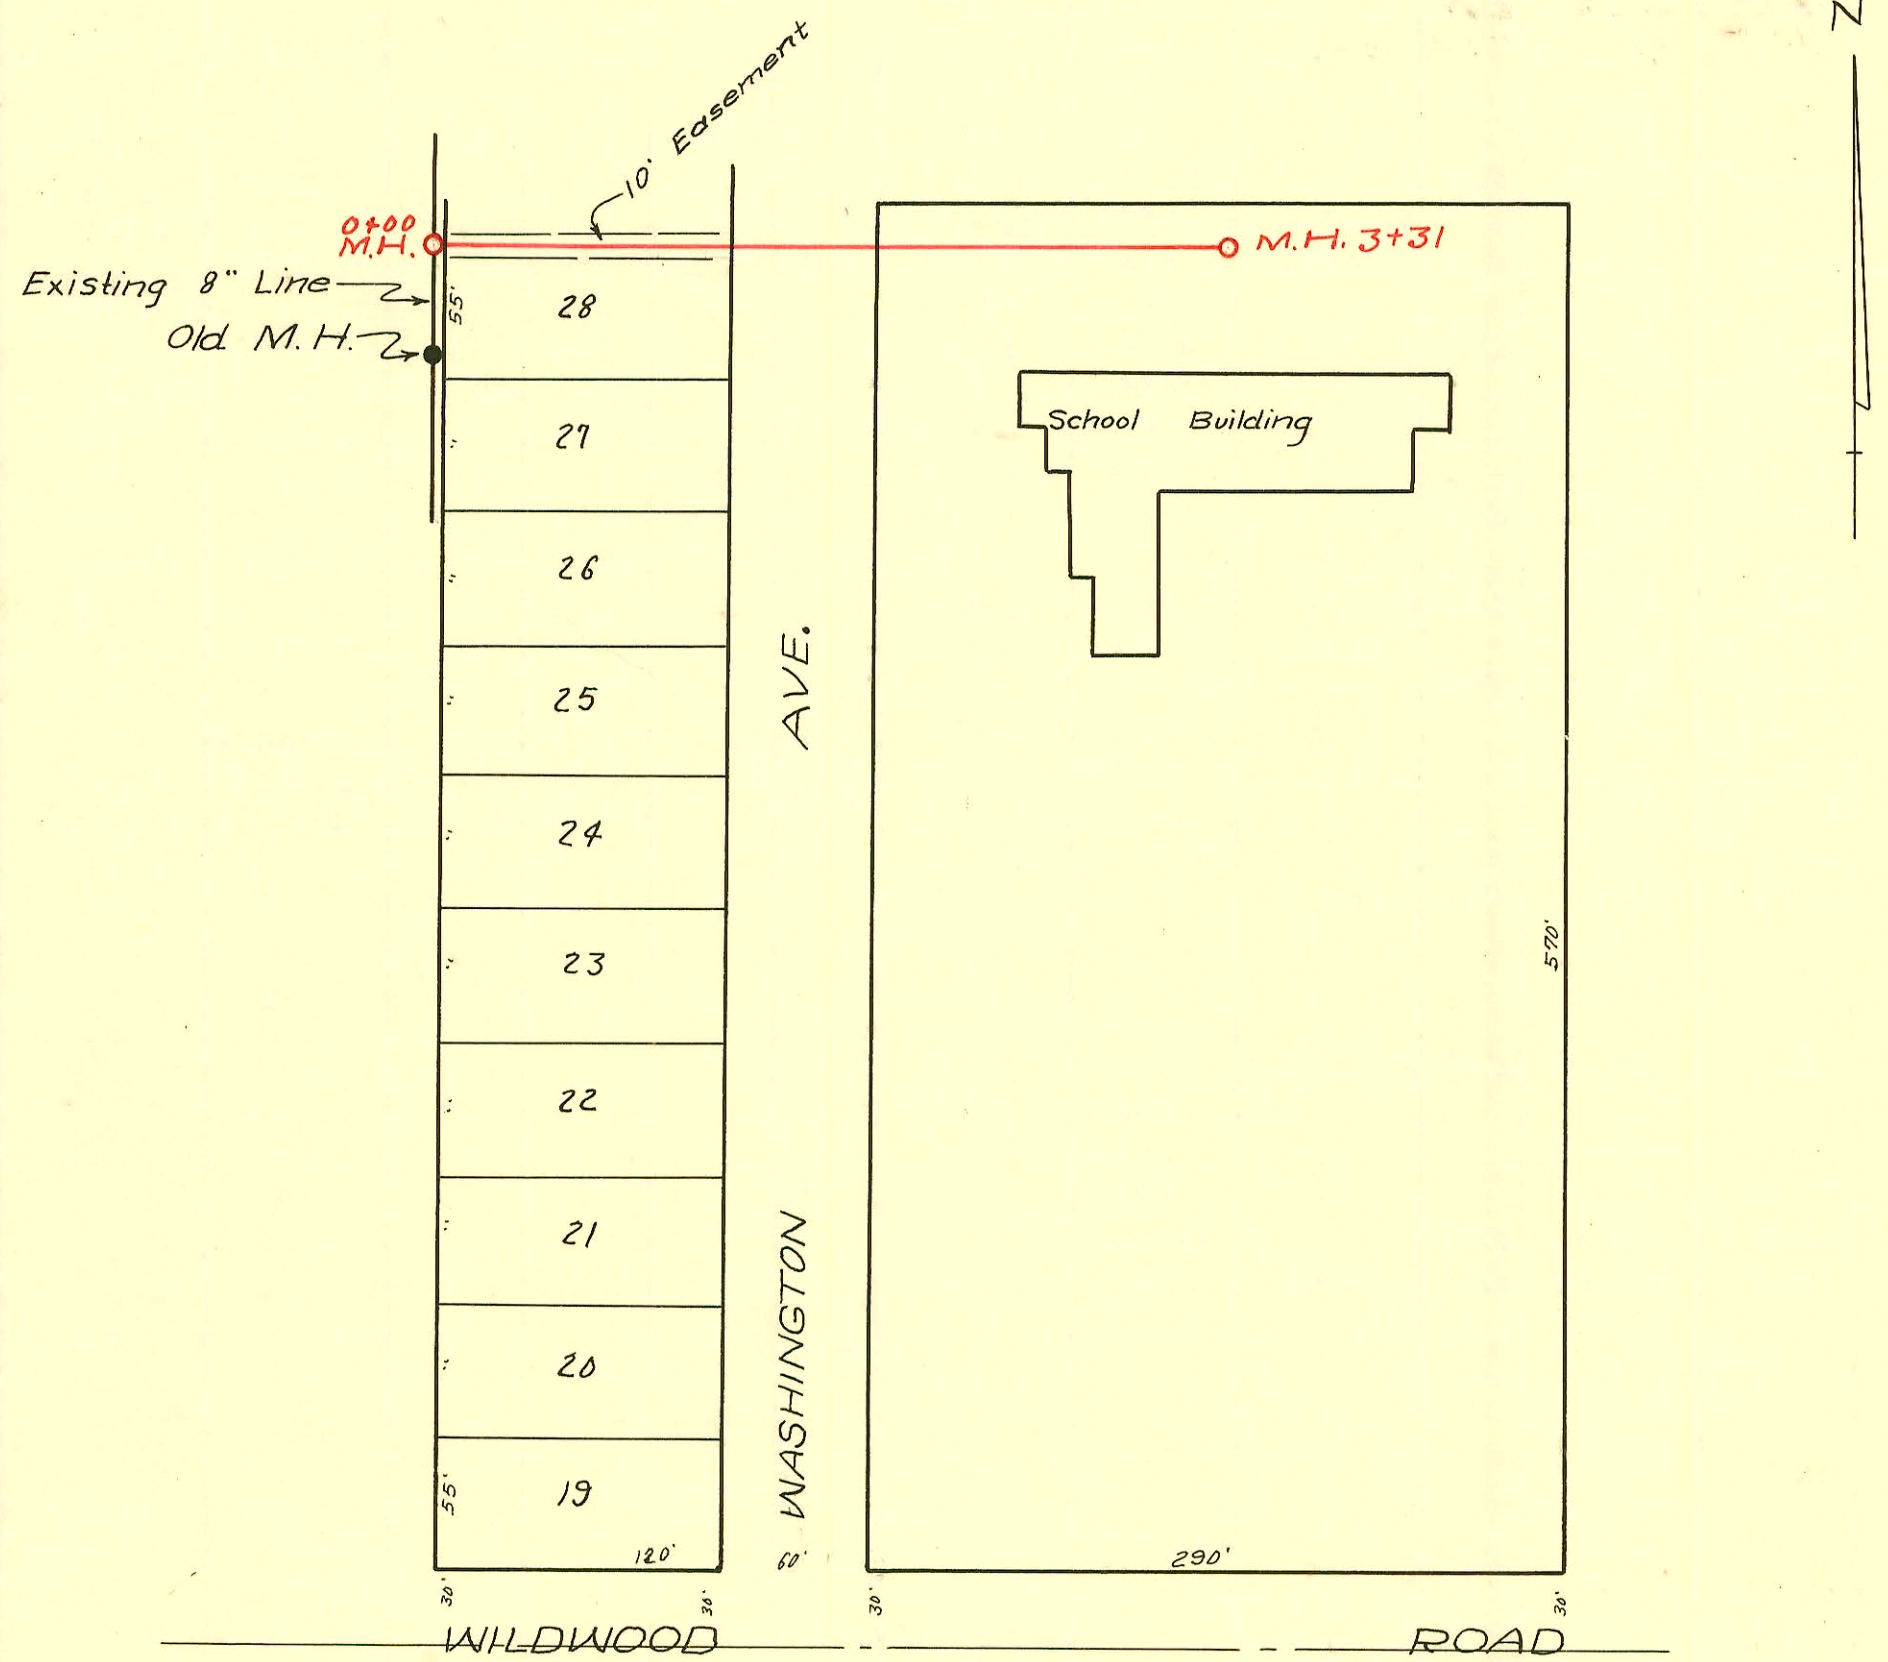

SOUTH WASHINGTON ELEMENTARY SCHOOL
 SANITARY SEWER
 W. B. CARTER OCT., 1949
 PRIVATE JOB

