

SERVICE RECORD


CONSTRUCTION RECORD

HARRY ST.


ST.

ST.

AVE.

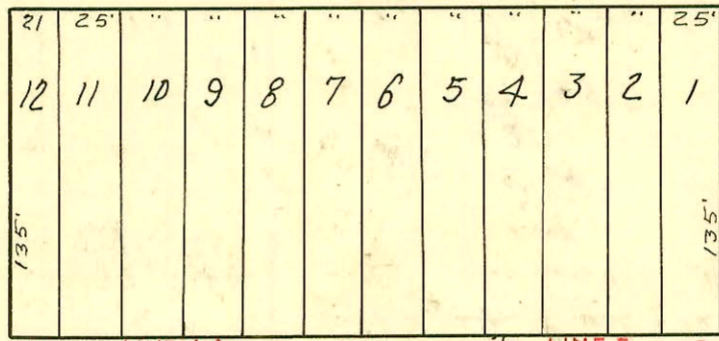

1+30.3 M.H. LINE I-A LINE I 6+19.5 M.H.

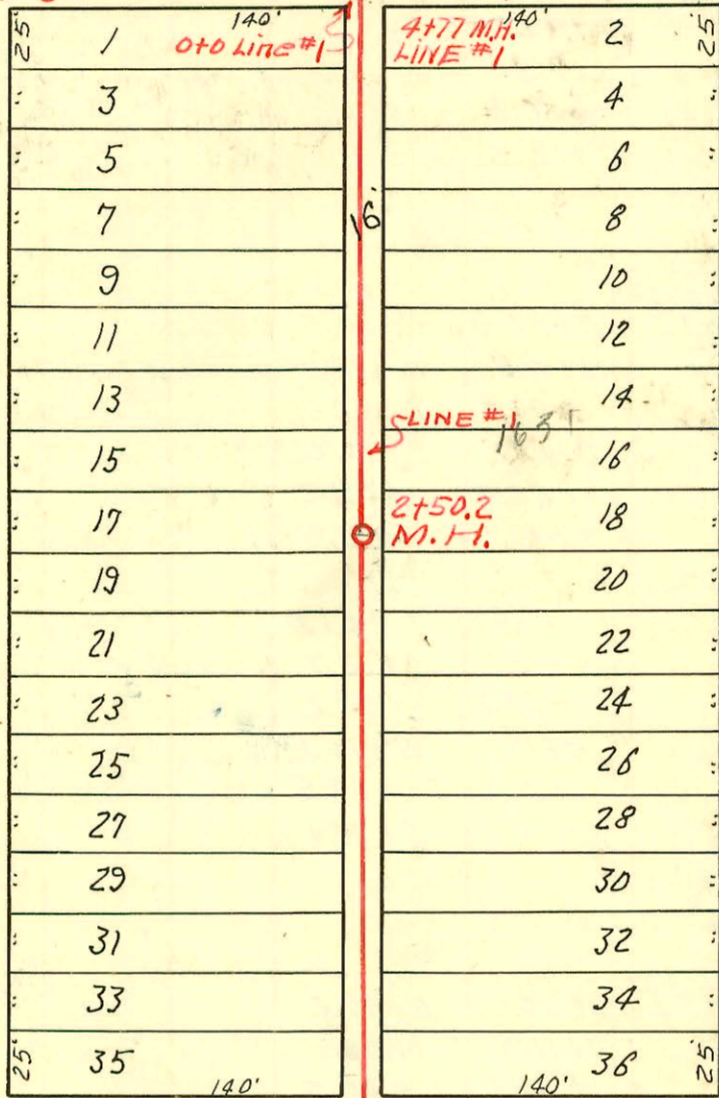

GREEN

ESTELLE

OSIE

ST.

N

Lat. 3, Submain W, S.S. #12
 W. B. CARTER NOV. 1949
 PROJECT NO. 29-26

