
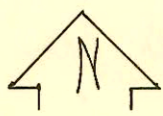


REVISION RECORD

CONSTRUCTION RECORD

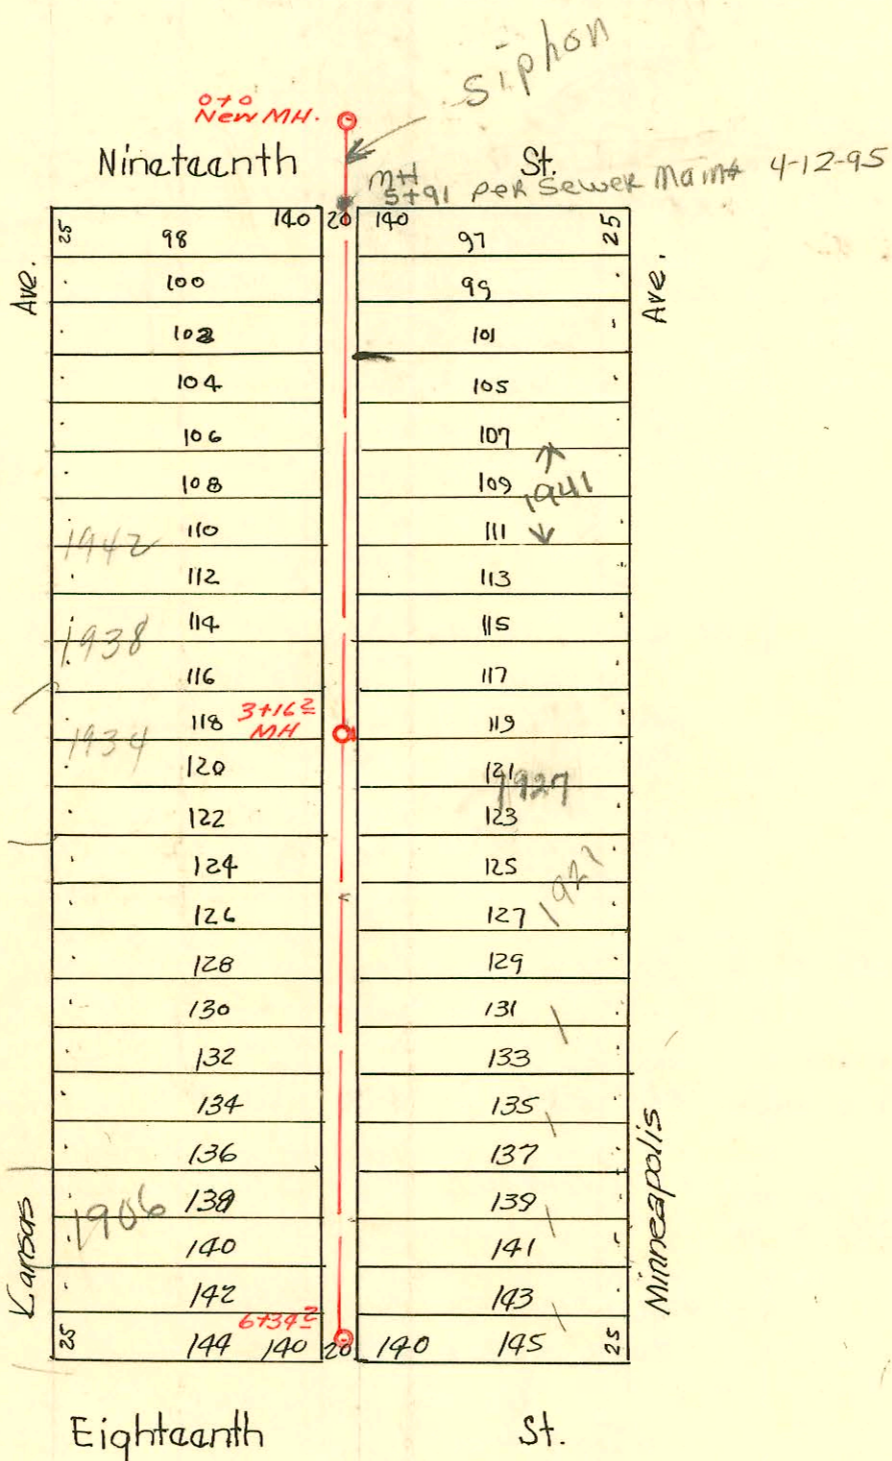

Scale: 1"=100'

W.B. Carter Const. Co.
Lat. 17, Dist. T, SS#12
1950

CONSTRUCTION RECORD						SERVICE RECORD						
STATION	ELEVATION		Depth	MANHOLE	4-INCH "Y" BRANCHES		No. of Permit		House Number		DATE OF PERMITS	
	Ground	Grade			North West	South East	North West	South East	North West	South East	North West	South East
0+0	122.7	115.22	8.21	New MH. 0+0	0+51.1 +79.0	0+76.0	#209	#3216	1954 N. Kansas	1953 N. Minneapolis	2-26-52	2-19-81 2-6-50
1+0	122.5	115.32	8.25		1+01.2 +29.4 +54.0 +75.0	1+26.4 +72.0	#208	#3217	1950 N. Kansas	1949 N. Minneapolis	2-26-52	2-6-50
2+0	122.5	115.42	8.26		2+01.5 +25.5 +51.5 +78.5	+22.5 +75.5	#207	#3218	1946 N. Kansas	1945 N. Minneapolis	2-26-52	2-6-50
3+0	122.9	115.52	8.36		3+07	3+04	#7350	#3220	2000-02479 1942 N. Kansas	1941 N. R. See Below Minneapolis	1-31-52	11-14-00 2-6-50
3+16.2	122.5	115.54	7.61	3+16.2	+29.5 +56 +78	+26.5 +53 +75	#949	#1036	1934 N. Kansas	1933 N. Minneapolis	5-14-54	5-16-50
4+0	122.3	115.62	7.98		4+04 +30 +55.5 +79.1	4+01 +27 +52.5 +76.1		#369 #854	1927 N. Minneapolis	1921 N. R. Minneapolis	7-17-52 4-7-50	5-3-50
5+0	122.0	115.72	6.97		5+05 +30 +54.0 +79.2	5+02 +27 +51.5 +76.2	#7348	#853	1919 N. Kansas	1911 N. Minneapolis	1-31-52	5-3-50
6+0	121.7	115.82	7.04		6+05 +22.5	6+02 +19.5	#7032	#852	1912 N. Kansas	1907 N. Minneapolis	11-12-51	11-6-85 5-3-50
6+34.2	121.8	115.86	6.70	6+34.2			#7031	#851	1906 N. Kansas	1907 N. Minneapolis	11-12-51	5-3-50
							#7030		1904 N. Kansas		11-12-51	

R-2000-02479-11/14/00-1941 N Minneapolis-Horris Dit-4"sch 40-Predco 93' N MH 3+16.2 (2+23.2)
1 TWIN CO, 1045

Copy Permit #5436-1942 N. Kansas - 6-2-53 - Article Ray