
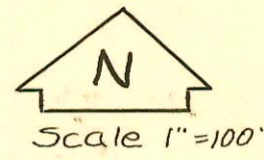


RECORD

RECORD

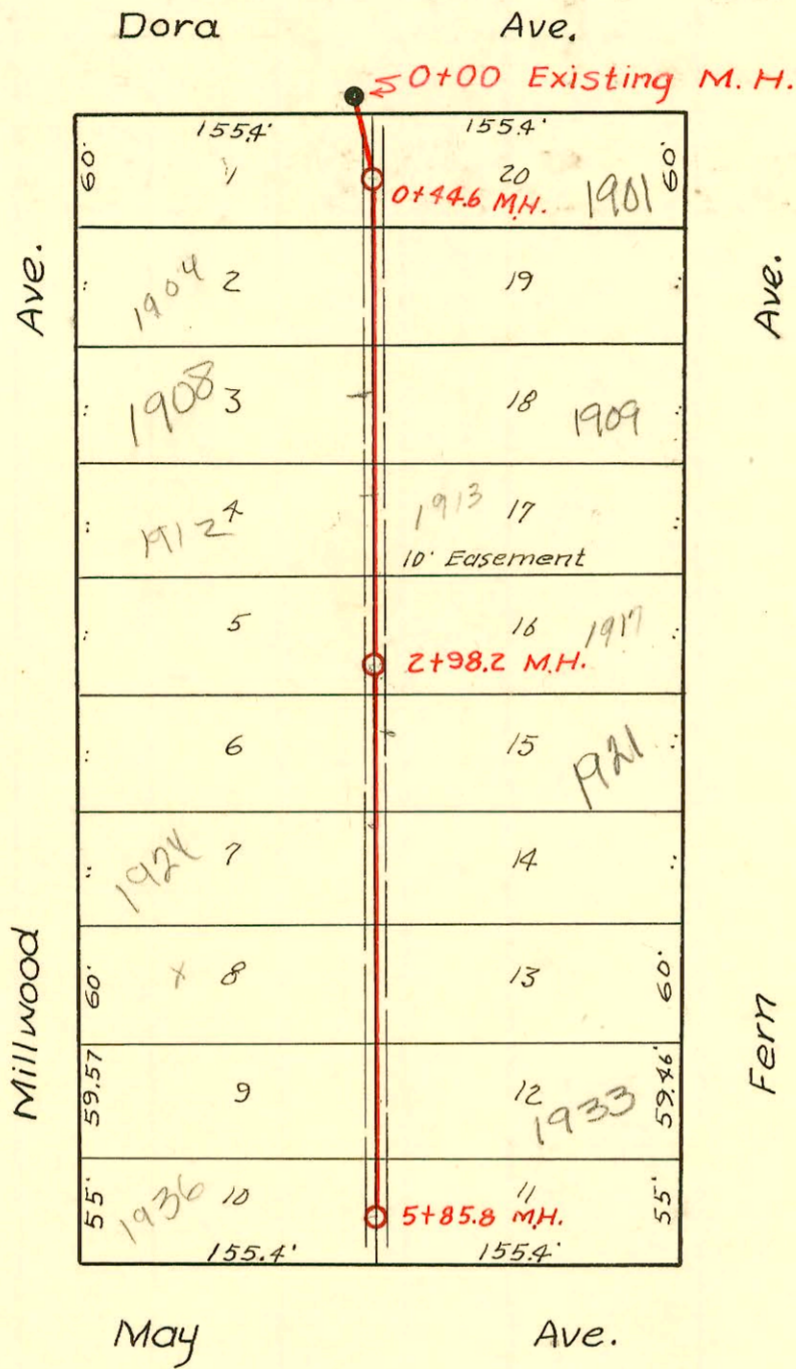

Lat. I, Dist. E, S.S. #21
 City of Wichita, Kansas
 L.K. White City Engineer
 W. B. Carter 1949
 PROJECT NO. C 29-64

CONSTRUCTION RECORD						SERVICE RECORD						
STATION	ELEVATION		Depth	MANHOLE	4-INCH "Y" BRANCHES		No. of Permit		House Number		DATE OF PERMITS	
	Ground	Grade			North West	South East	North West	South East	North West	South East	North West	South East
0+00	104.7	98.21	7.61	Existing M.H. 0+00								
0+44.6	104.4	98.26	7.58	0+44.6	0+35.2 +82.6	0+70.9	#874 #875	#884	1627 B 1904 S.R. Millwood S. Fern	1901 S. Fern	5-6-50 10-28-96 5-6-50	5-6-50
1+00	104.4	98.31	7.06		1+54.0	1+51.0	#876	#1163	1908 S. Millwood	1909 S. Fern	5-6-50	5-27-50
2+00	103.8	98.41	6.36		2+13.5 +66.8	2+10.5 +63.8	#877 #878	#1164 #1165	1912 S. 1916 S. Millwood	1913 S. Fern	5-6-50 5-6-50	5-27-50 10-12-82 5-27-50
2+98.2 3+00	103.9	98.51	6.64	2+98.2	3+32.9 +79.8	3+29.9 +76.8	#879 #880	#1166 #1167	1920 S. 1924 S.R. Millwood	1921 S. S. Fern	5-6-50 6-18-96 5-6-50	11-29-05 5-27-50 5-27-50
4+00	103.3	98.61	5.81		4+41.9	4+38.9	#881	#1169	1928 S. Millwood	1929 S. S. Fern	5-6-50	5-27-50
5+00	103.2	98.71	5.54		5+07.2 5+62.5	5+04.2 +59.5	#882 #883	#1169 #1170	1932 S. 1936 S. Millwood	1933 S. S. Fern	5-6-50 5-6-50	5-27-50 4-28-80 5-27-50
5+85.8	102.9	98.80	5.33	5+85.8								

#7011-Tap-19192. Fern-Joe Mc Donald-5/22/58