
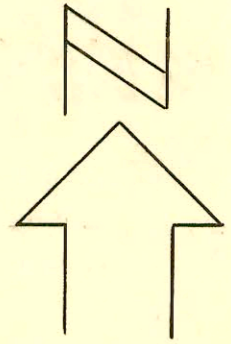


SERVICE RECORD

CONSTRUCTION RECORD

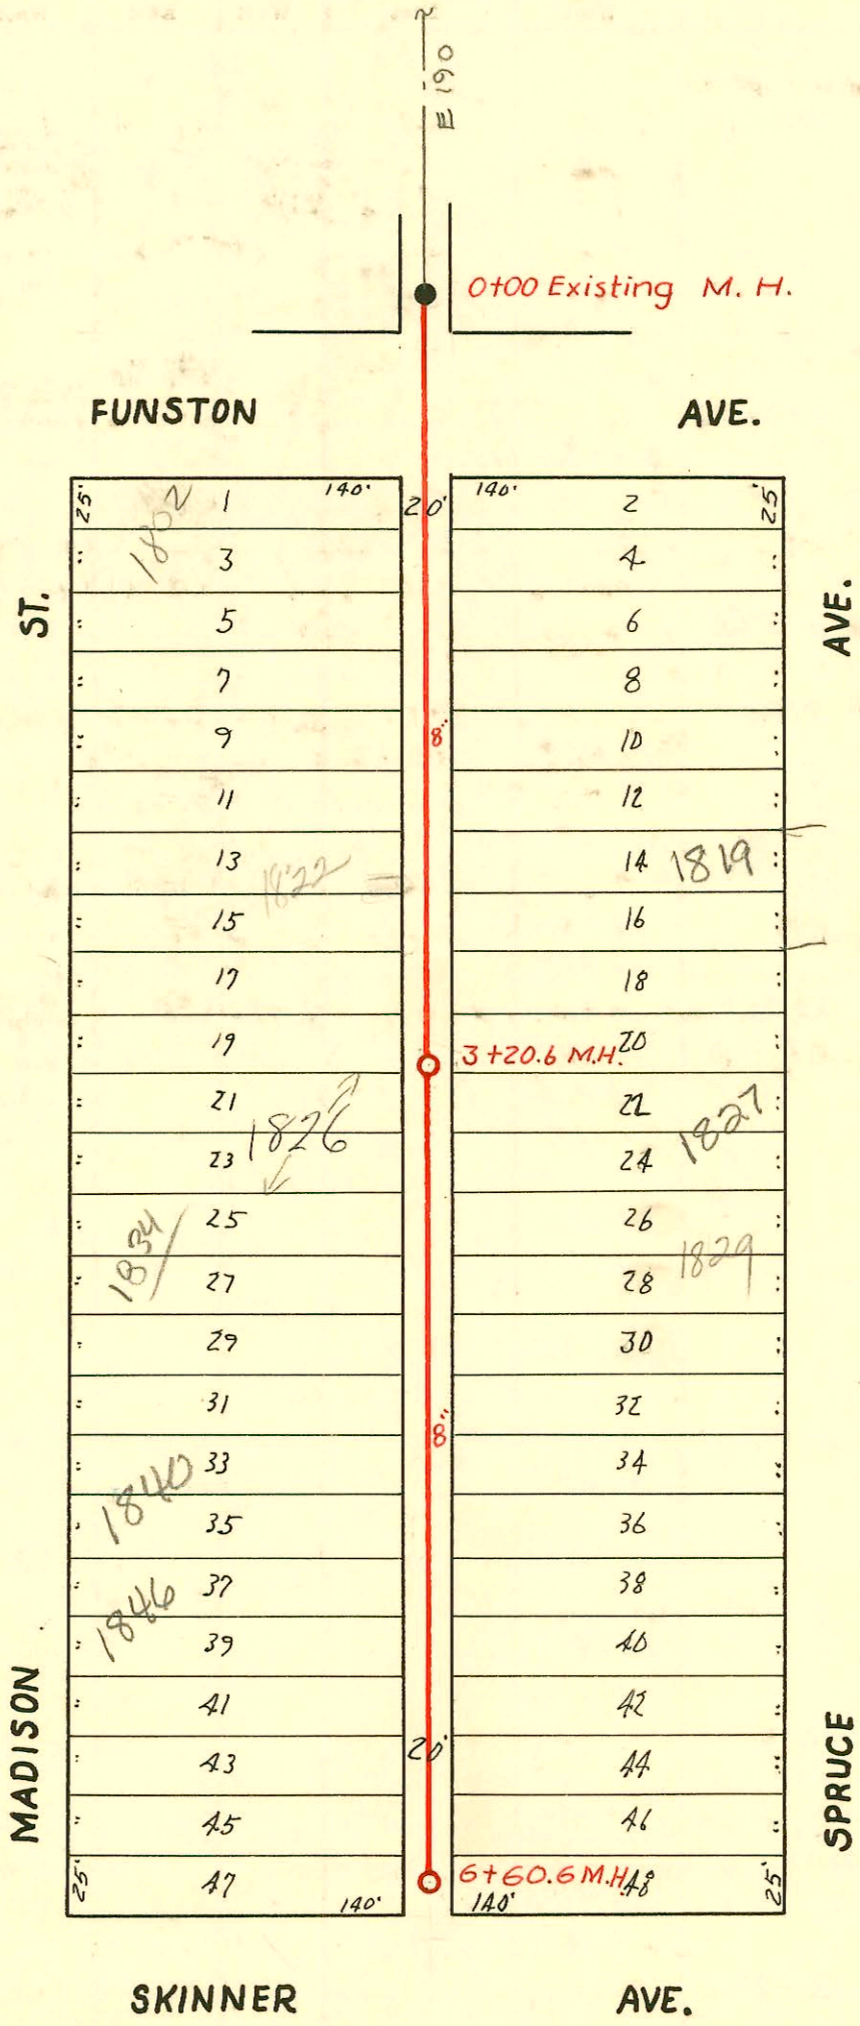

Scale 1"=80'

LAT. 10, DIST. AS, S.S. # 12
 CITY OF WICHITA, KANSAS
 L. K. WHITE CITY ENGINEER
 W. B. CARTER 1950
 PROJECT NO. C 29-50

Book # 1A

CONSTRUCTION RECORD						SERVICE RECORD							
STATION	ELEVATION		Depth	MANHOLE	4-INCH "Y" BRANCHES		No. of Permit		House Number		DATE OF PERMITS		
	Ground	Grade			North West	South East	North West	South East	North West	South East	North West	South East	
0+0	99.1	93.95	5.44	0+0 Exist. M.H.									
1+0	99.1	94.05	5.30		1+05.6	1+02.6	#11011	#724	14025	1808 S	3-3-57	4-28-50	
					+42.1	+39.1	#2475	#735	1805 S	1815 S	1-26-51	4-26-50	
					+92.4	+89.4	#225	#363	Madison	Spruce	3-28-50	3-31-50	
2+0	99.2	94.15	5.33		2+33								
						2+47.7	#3444		1819	Spruce		2-23-50	
					2+86.6		#3449		1822 S	Madison		2-24-50	
3+0	99.6	94.25	5.61			3+12.5	#3418		1801 S	Spruce		2-21-50	
3+20.6	99.6	94.27	5.61	3+20.6	3+46.2	3+43.2	#0075	#2005	1826 S	1827 S	#2344	1-16-51	
					+91.6	+88.6	#6113	#347	1834 S	Madison		7-12-50	
							#3573					1-5-51	
4+0	99.2	94.35	5.14		4+39.8	4+36.8	2003	2348	1840 S	1837 S	7-14-53	7-12-50	
					+77.5	+74.5	#5553		Madison			7-26-55	
					+99.7	+96.7		#411		1843 S	Spruce		3-23-51
5+0	99.2	94.45	4.95		5+50	5+47	2003	#3433	1846 S	1845 S	7-14-53	2-23-50	
					+99.9	+96.9	#3846	#3844	Madison	Spruce		2-12-51	
												2-12-51	
6+00	99.0	94.55	4.66		6+48.4	6+45.4	#3377	#1458	1850 S	1857 S	12-4-52	6-28-50	
6+60.6	99.4	94.61	5.03	6+60.6									

SWR 2000-00067 1-11-2000 1826 N Madison - 4" 54440 Donut in Wye 35.16 S of 44 3+20.6 (3+46.2)
 17WIN CO, 1V46, 2H45

9673811-7 R 8-22-96
 #2293 Tap - 221E. Granite - Berlin Twp, Co - 2-28-53
 10816 Tap 1829 S Spruce Headgatch 7-8-59/3194.6