


SERVICE RECORD

CONSTRUCTION RECORD

4" y - must be trapped with 6" trap

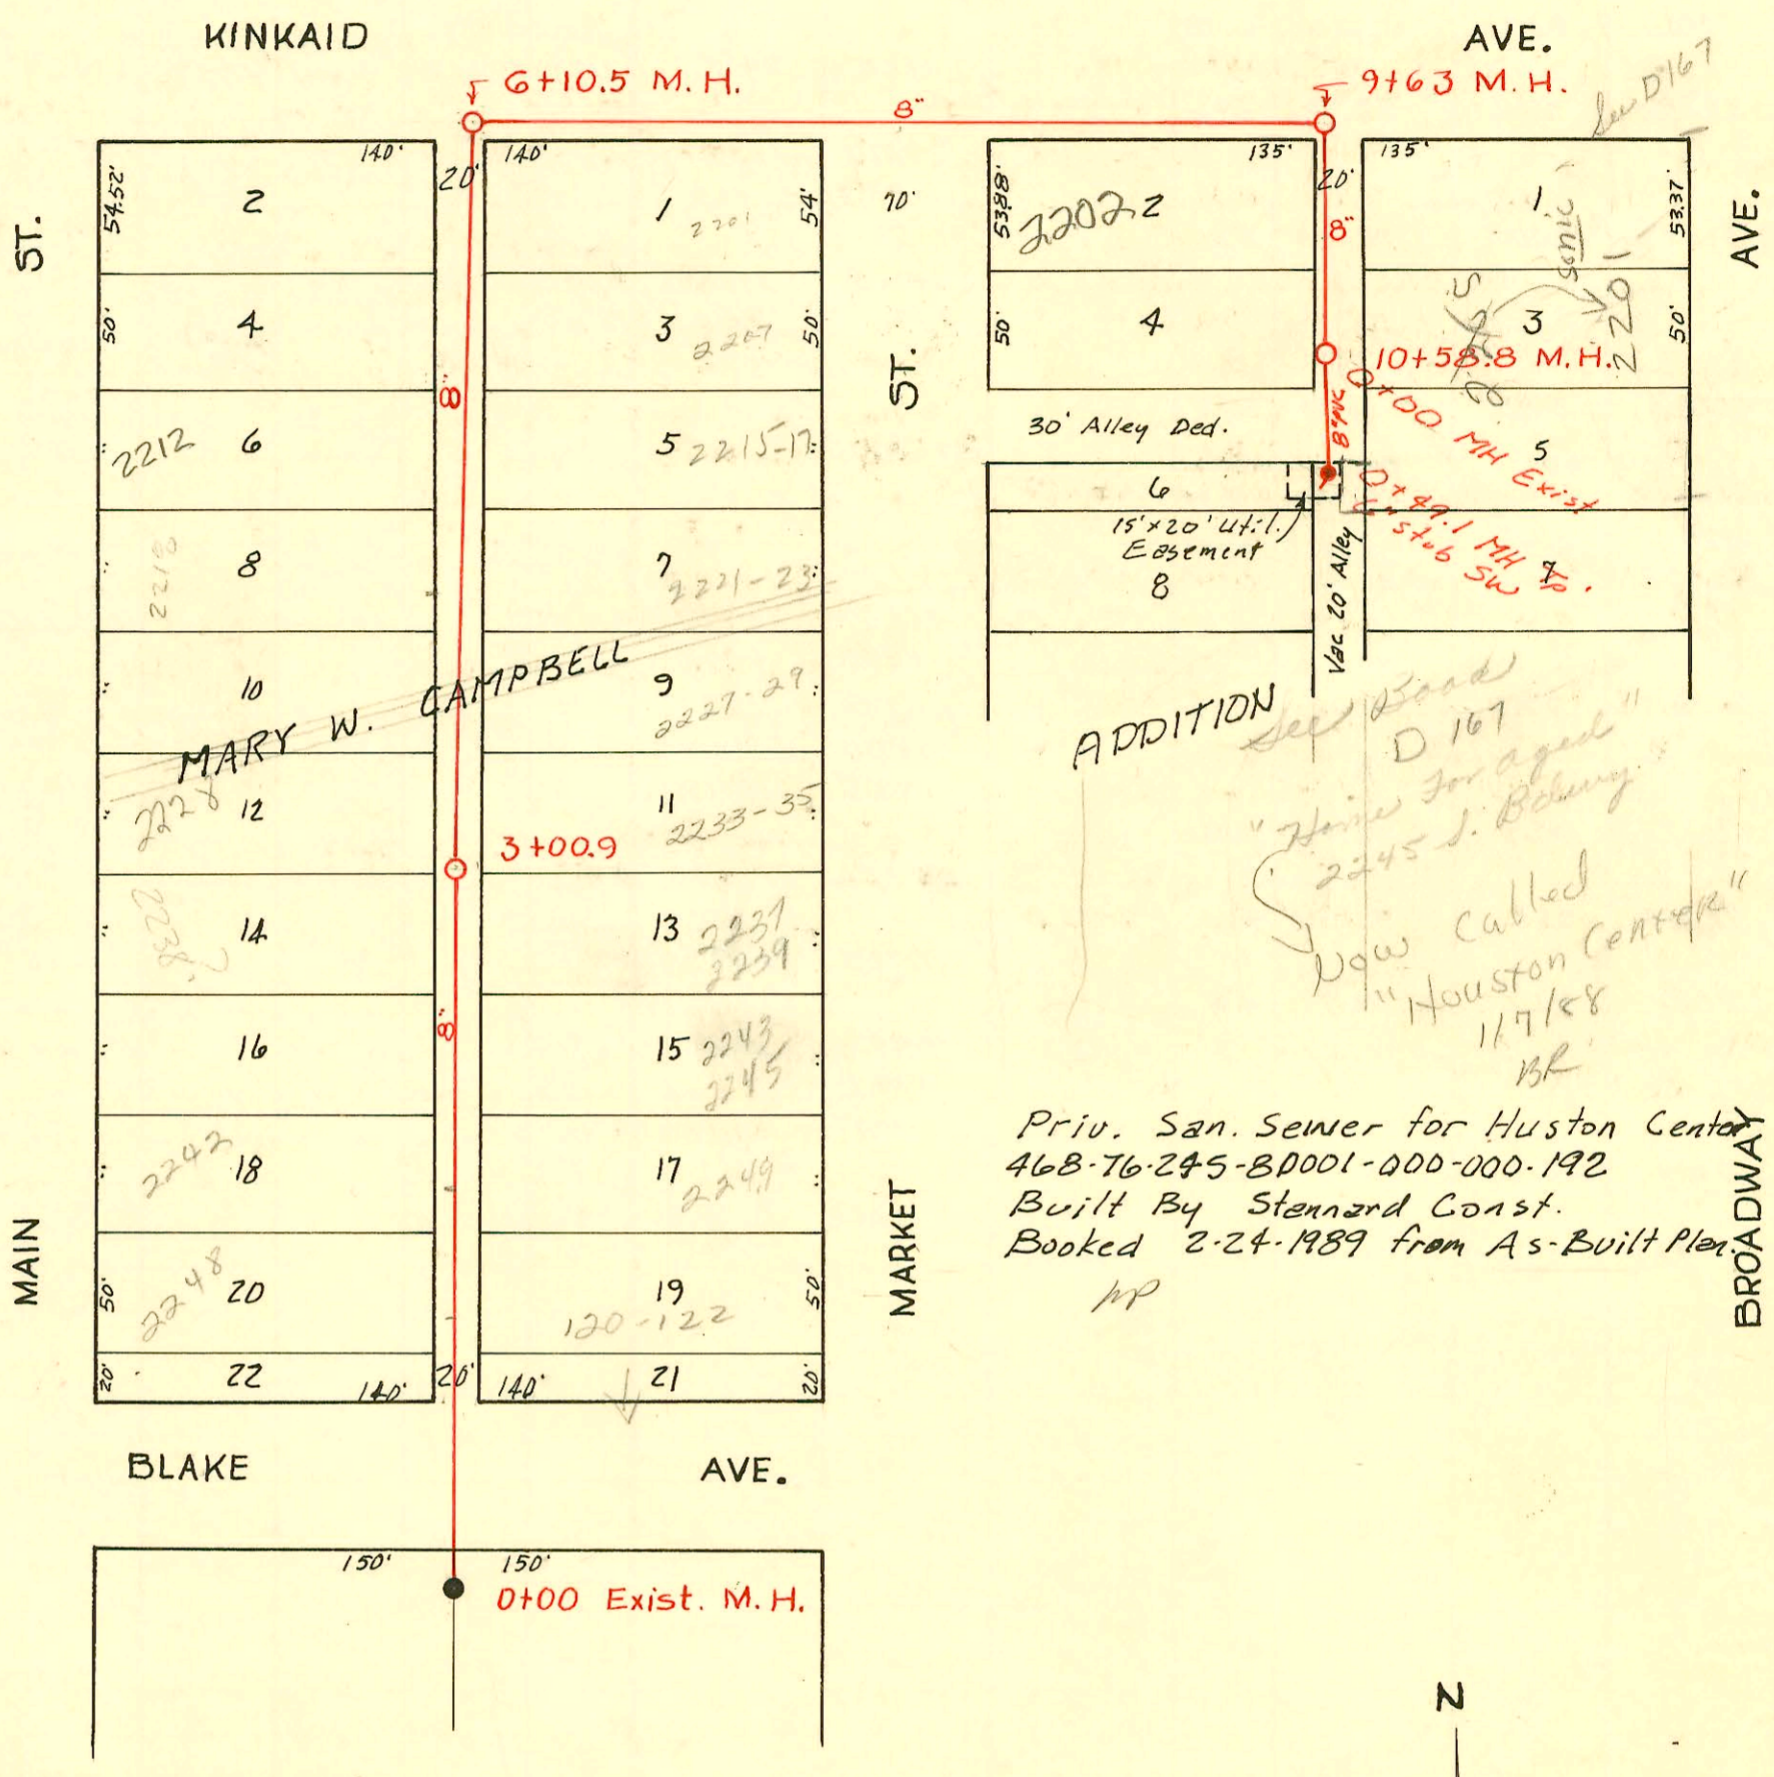

Priv. San. Sewer for Huston Center  
 468-76-245-BD001-000-000-192  
 Built By Stennard Const.  
 Booked 2-24-1989 from As-Built Plan  
 HP

4" y - must be trapped with 6" trap

Scale 1"=80'

Lat. 12, Dist. B, S.S. # 20  
 City of Wichita, Kansas  
 L. K. White City Engineer  
 W. B. Carter 1950  
 Project No. C-29-59

Book # M 6

