


CONSTRUCTION RECORD

N


Scale 1"=100'

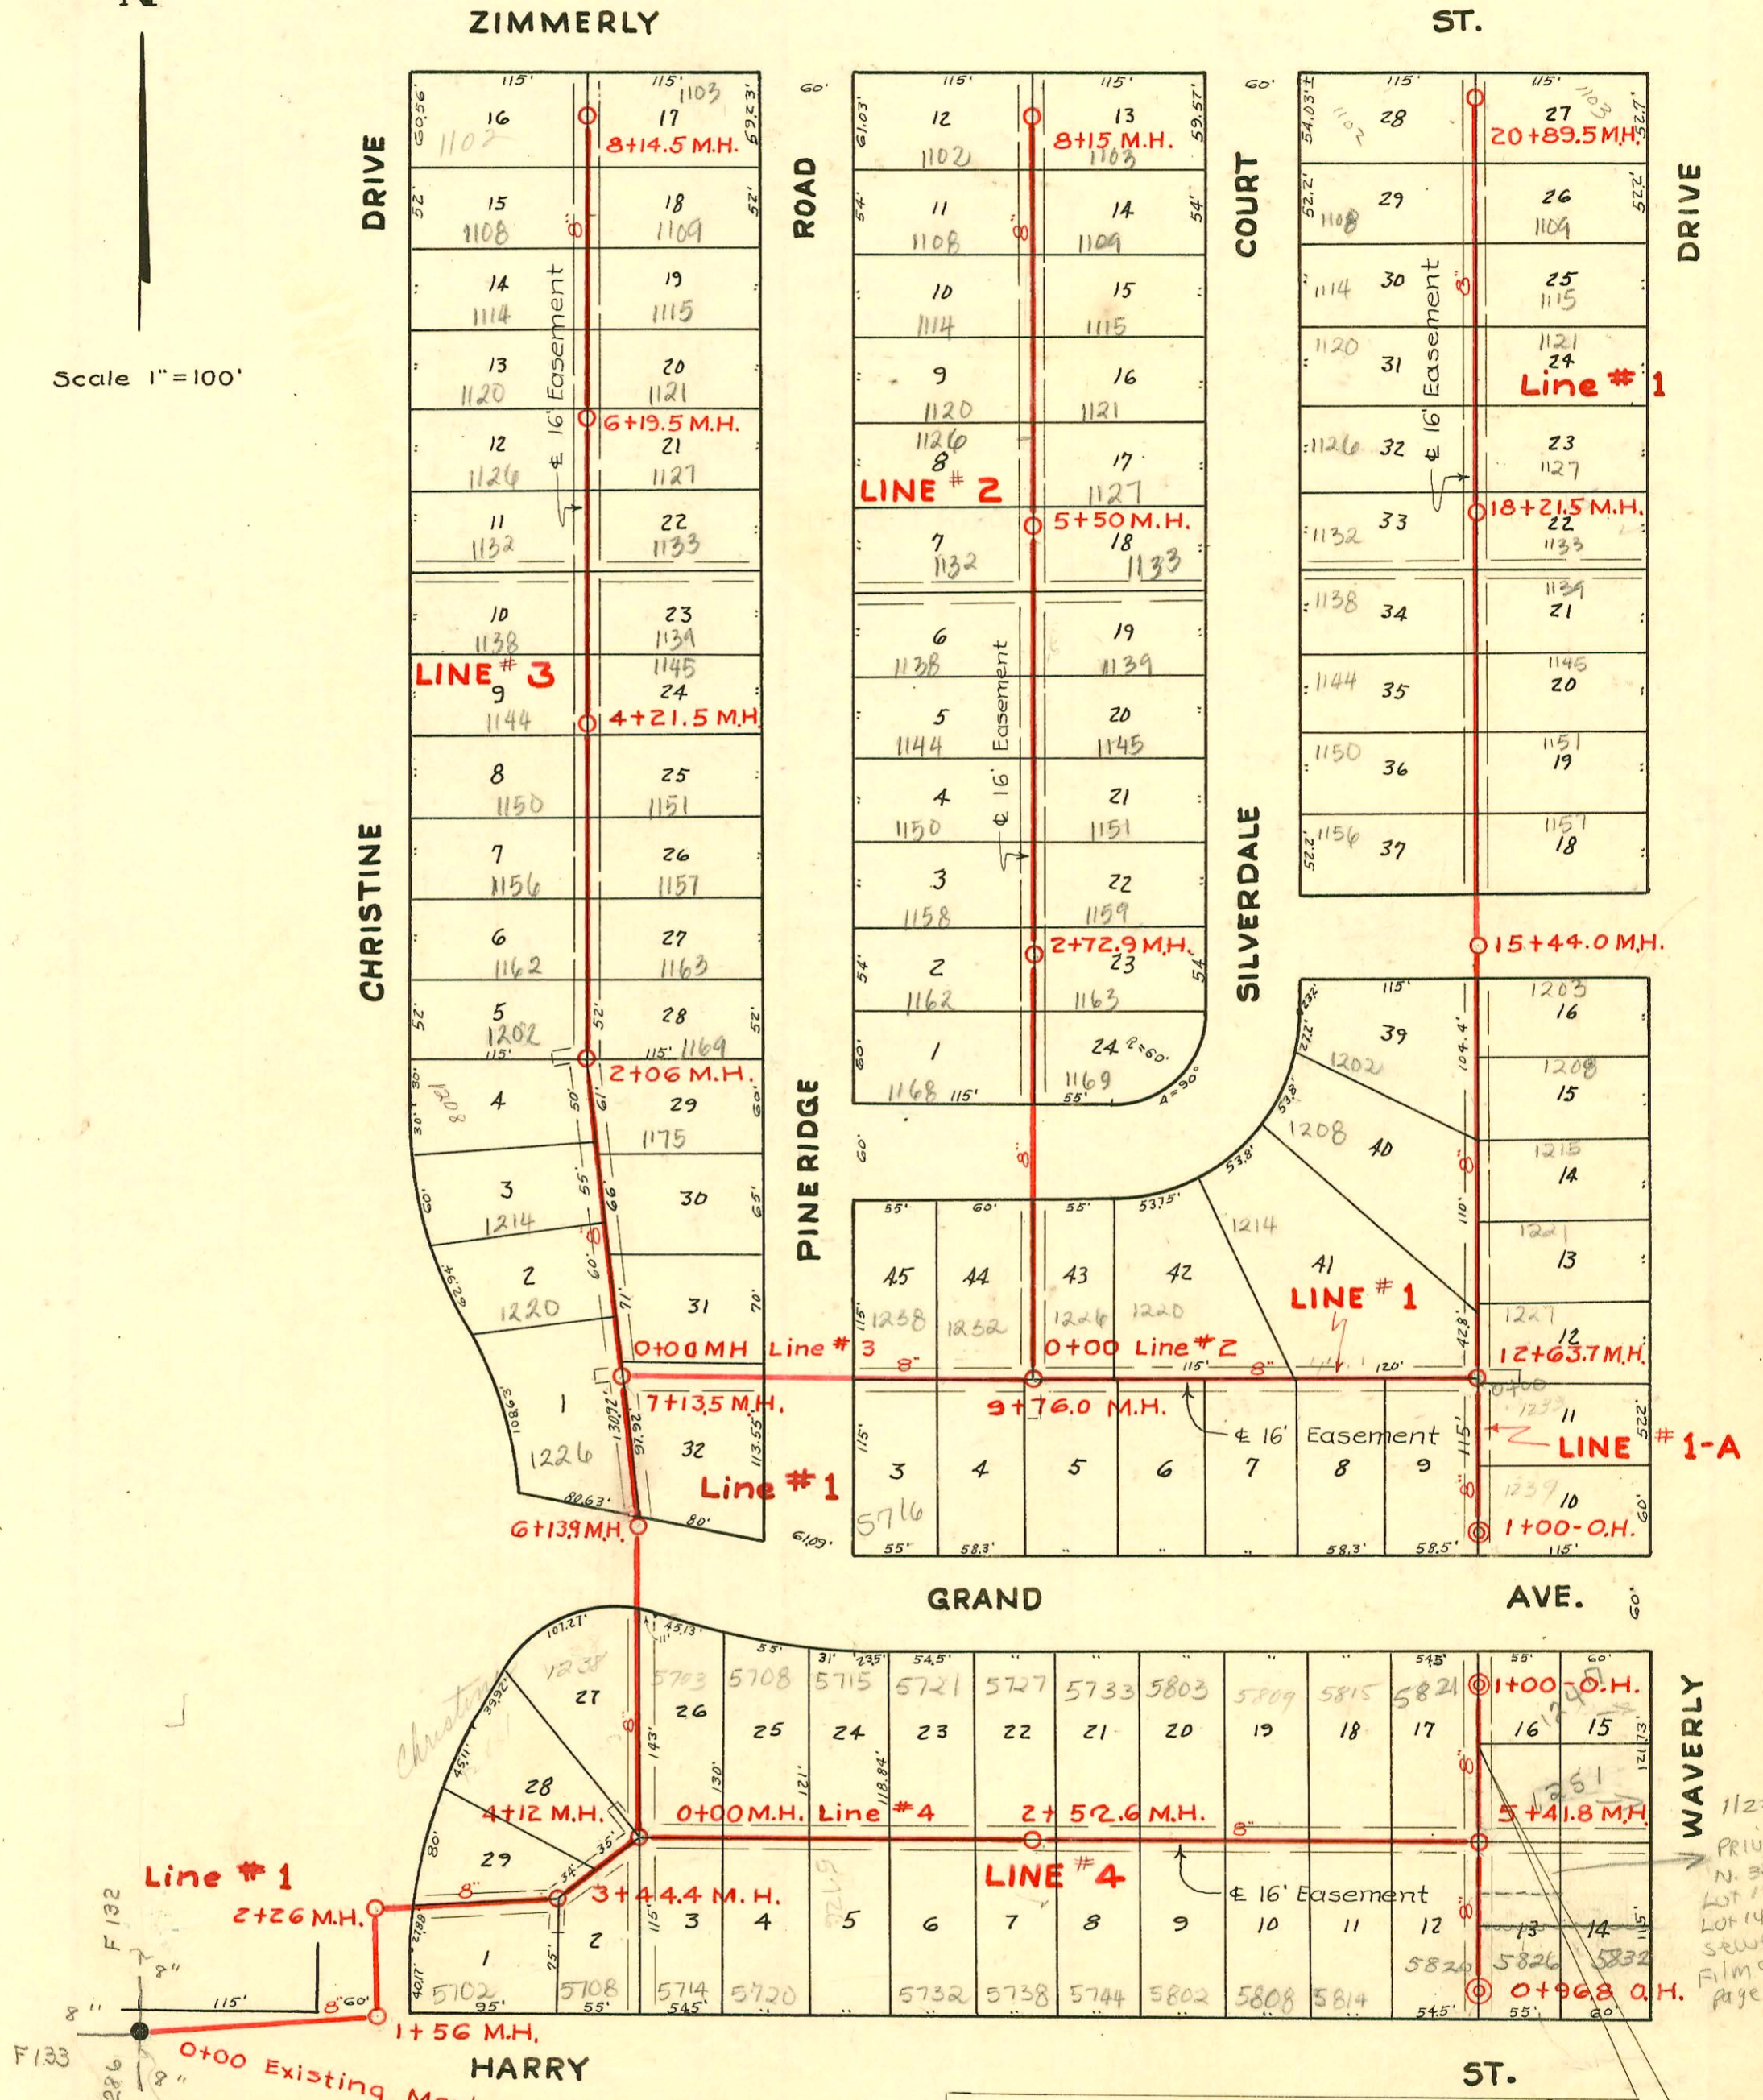

Note: The Lateral running North from Line 4 all Wye's are West Wye's and the City is to issue taps at no charge to Lots on the East.

1122188
Private Ewe
N. 35' of
Lot 13 to
Lot 14 for
sewer.
Film 944
Page 1230

LAT. 43, DRY CREEK SUBMAIN, S.S.#12
CITY OF WICHITA, KANS.
L.K. WHITE CITY ENGINEER
W. B. CARTER 1950
PROJECT NO. C 20- 6
Book #44

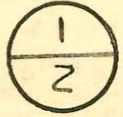

CONSTRUCTION RECORD

SERVICE RECORD

LINE # 3

LINE # 4

STUB No.

STUB Sq.

STATION	ELEVATION		Depth	MANHOLE	4-INCH "Y" BRANCHES		No. of Permit		House Number		DATE OF PERMITS			
	Ground	Grade			North West	South East	North West	South East	North West	South East	North West	South East	North West	South East
0+00	148.9	137.94	11.22	0+00=7+13.5 in line # 1	0+10.9	+81.9	#464		1226		4-13-50			
1+00	150.1	138.04	12.26		1+38.0	+99.4	#465		1203		4-13-50			
2+00	151.2	138.14	13.29		2+38.2	+75.6	#466	#1439	1195		4-13-50	6-28-50		
2+06	151.3	144.60	7.53	2+06.0	2+35.2	+72.6	#467	#1438	1195		4-13-50	6-28-50		
3+00	152.4	144.10	8.59		3+34.2	+90.0	#468	#1437	1195		4-13-50	6-28-50		
4+00	153.5	144.20	9.51		4+42.8	+87.0	#469	#1436	1195		4-13-50	6-28-50		
4+21.5	153.6	144.22	9.61	4+21.5	4+39.8	+89.0	#470	#1435	1195		4-13-50	6-28-50		
5+00	154.2	144.30	10.11		5+44.3	+97.4	#471	#1434	1195		4-13-50	6-28-50		
6+00	154.5	144.40	10.38		6+50.4	+98.0	#472	#1433	1195		4-13-50	6-28-50		
6+19.5	154.5	144.42	10.33	6+19.5	6+47.4	+98.0	#473	#1432	1195		4-13-50	6-28-50		
7+00	154.6	144.50	10.34		7+01.0	+53.6	#474	#1431	1195		4-13-50	6-28-50		
8+00	154.1	144.60	9.71		8+04.4	8+01.4	#475	#1430	1195		4-13-50	6-28-50		
8+14.5	153.6	144.62	9.25	8+14.5			#476	#1429	1195		4-13-50	6-28-50		
0+00	147.2	137.64	9.76	0+00=4+12 in Line # 1	0+19.4	+71.4	#2076	#2140	5709	5714E	8-24-50	8-31-50		
1+00	146.3	137.74	8.83		1+25.0	+76.2	#2077	#2141	5709	5728E	8-24-50	8-31-50		
2+00	144.9	137.84	7.27		2+27.0	+78.4	#2078	#2142	5710	5736E	8-24-50	8-31-50		
2+52.6	143.9	137.89	6.30	2+52.6	2+24.0	+75.4	#2079	#2143	5711	5737E	8-24-50	8-31-50		
3+00	143.2	137.94	5.55		3+27.4	+80.1	#2080	#2144	5712	5738E	8-24-50	8-31-50		
4+00	142.1	138.04	4.26		4+26.5	+76.1	#2081	#2145	5713	5739E	8-24-50	8-31-50		
5+00	141.0	138.14	3.13		5+25.4	+74.8	#2082	#2146	5714	5740E	8-24-50	8-31-50		
5+41.8	140.8	138.18	2.90	5+41.8	5+34.2		#2083	#2147	5715	5741E	8-24-50	8-31-50		
0+0	140.6	138.28	2.52	0+00=5+41.8 in Line # A	0+29.8		#2084	#2148	5716	5742E	8-24-50	8-31-50		
1+00	142.6	138.38	4.51	1+00-O.H.			#2085	#2091	5821A	1351	8-24-50	8-24-50		
0+0	140.6	138.28	2.52	0+00=5+41.8 in Line # 4	0+30.7		#2149		5822E	1247		8-31-50		
0+96.8	141.0	138.38	2.82	0+96.8-O.H.	+74.0				5823E					

Taps to issued to East Lots on North Lateral

SERVICE RECORD

CONSTRUCTION RECORD

2000-01617-11565 Christine - 7113100 - Bammes - 4" sch 40 Main Extension / 1-Ferno / 1-Nohub / 1-TWINCO

See drawing on page 176