


CONSTRUCTION RECORD

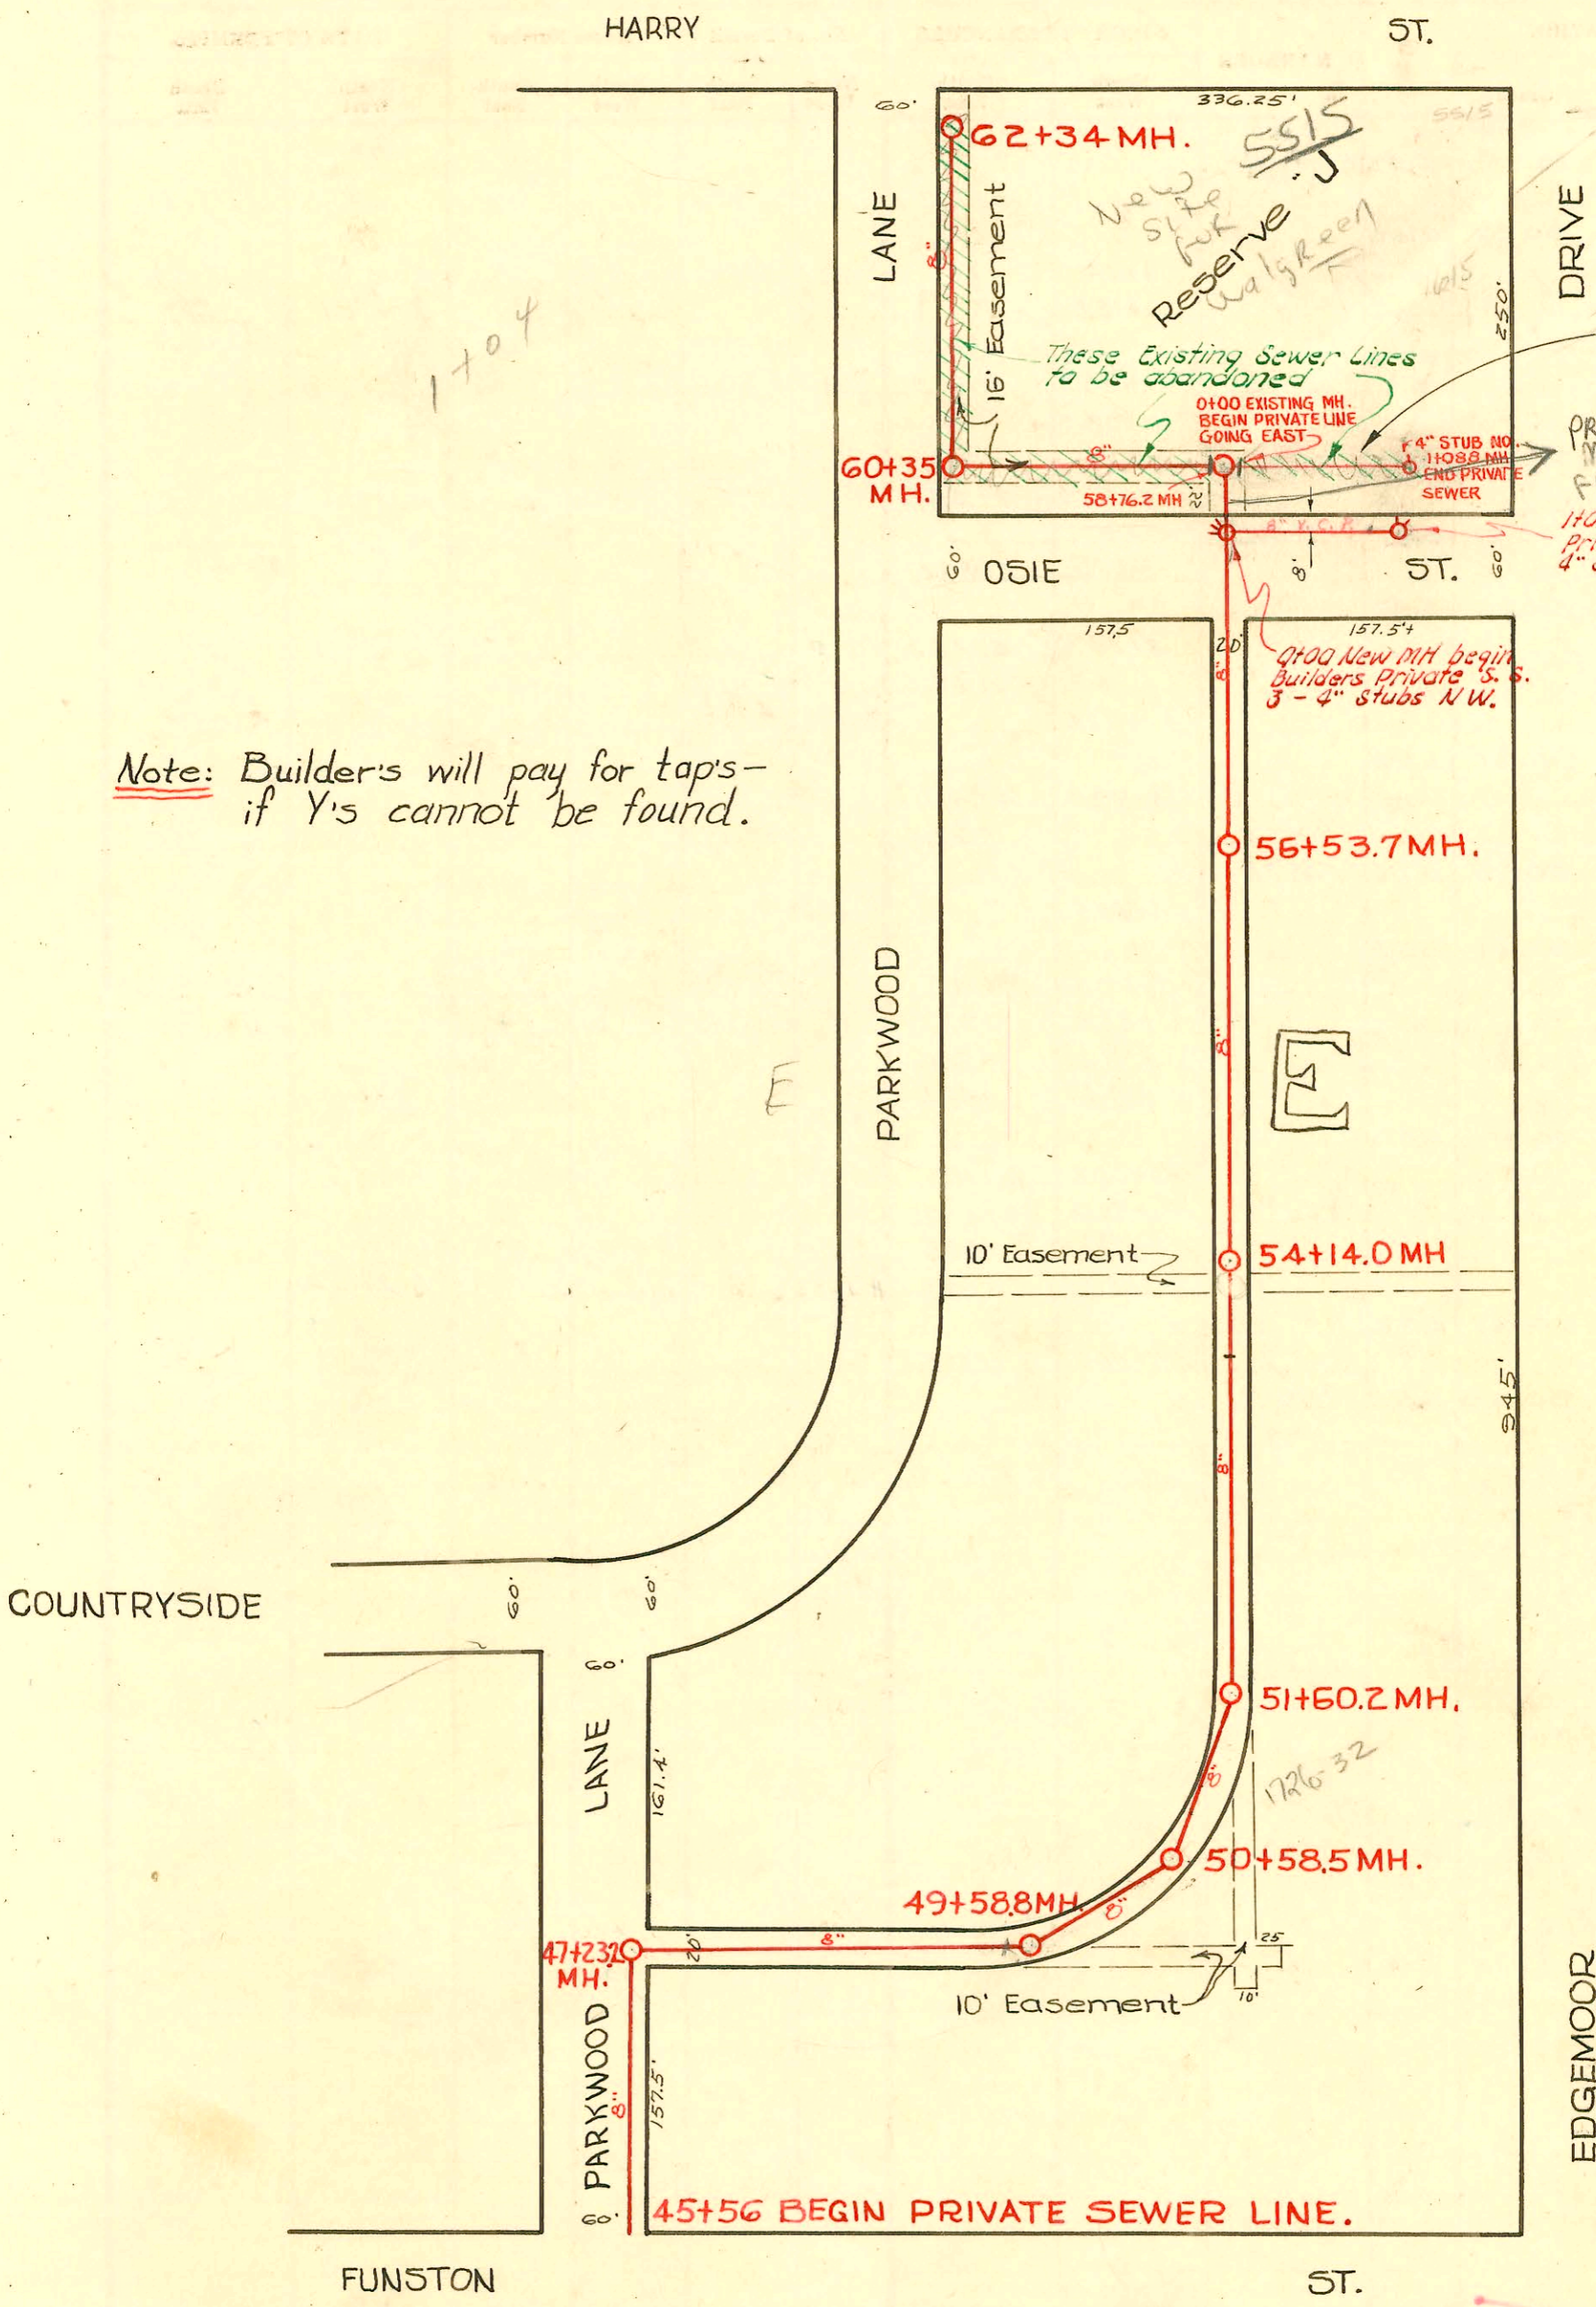

Note: Builder's will pay for taps - if Y's cannot be found.

LAT. 7, SUBMAIN 1, WAR INDUSTRIE'S SEWER
 CITY OF WICHITA, KANSAS
 L.K. WHITE CITY ENGINEER
 PRIVATE CONSTRUCTION
 MAY 1950

- # 14256 Tap MH (1+00) 1625 S. Edgemoor - Vernon Lippoldt 6-5-61
- # 320 - Tap - 5402-4-6-8 E. J. Tranton - 4-4-50 - Wichita P.D. Co Book # M12
- # 321 - Tap - 5410-12-14-16 E. Tranton - 4-4-50 - Wichita P.D. Co
- # 322 - Tap - 5502-4-6-8 E. J. Tranton - 4-4-50 - Wichita P.D. Co
- # 325 - Tap - 1749-51-53-55 S. Edgemoor - 4-4-50 - Wichita P.D. Co
- # 331 - Tap - 1665-67-69-71 S. Edgemoor - 4-4-50 - Wichita P.D. Co
- # 6940 - Tap - 5515 E. Harry - 12-28-51 - Richard LaFoy, Jr.
- # 7229 - Tap - 1615 S. Edgemoor - 12-15-53 - Richard LaFoy, Jr.

