
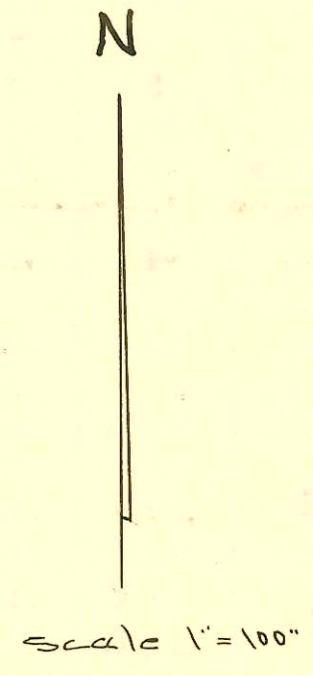


CONSTRUCTION RECORD SERVICE RECORD

FUNSTON ST.

MH. 0+00-Line#9B-Existing MH. on Submain

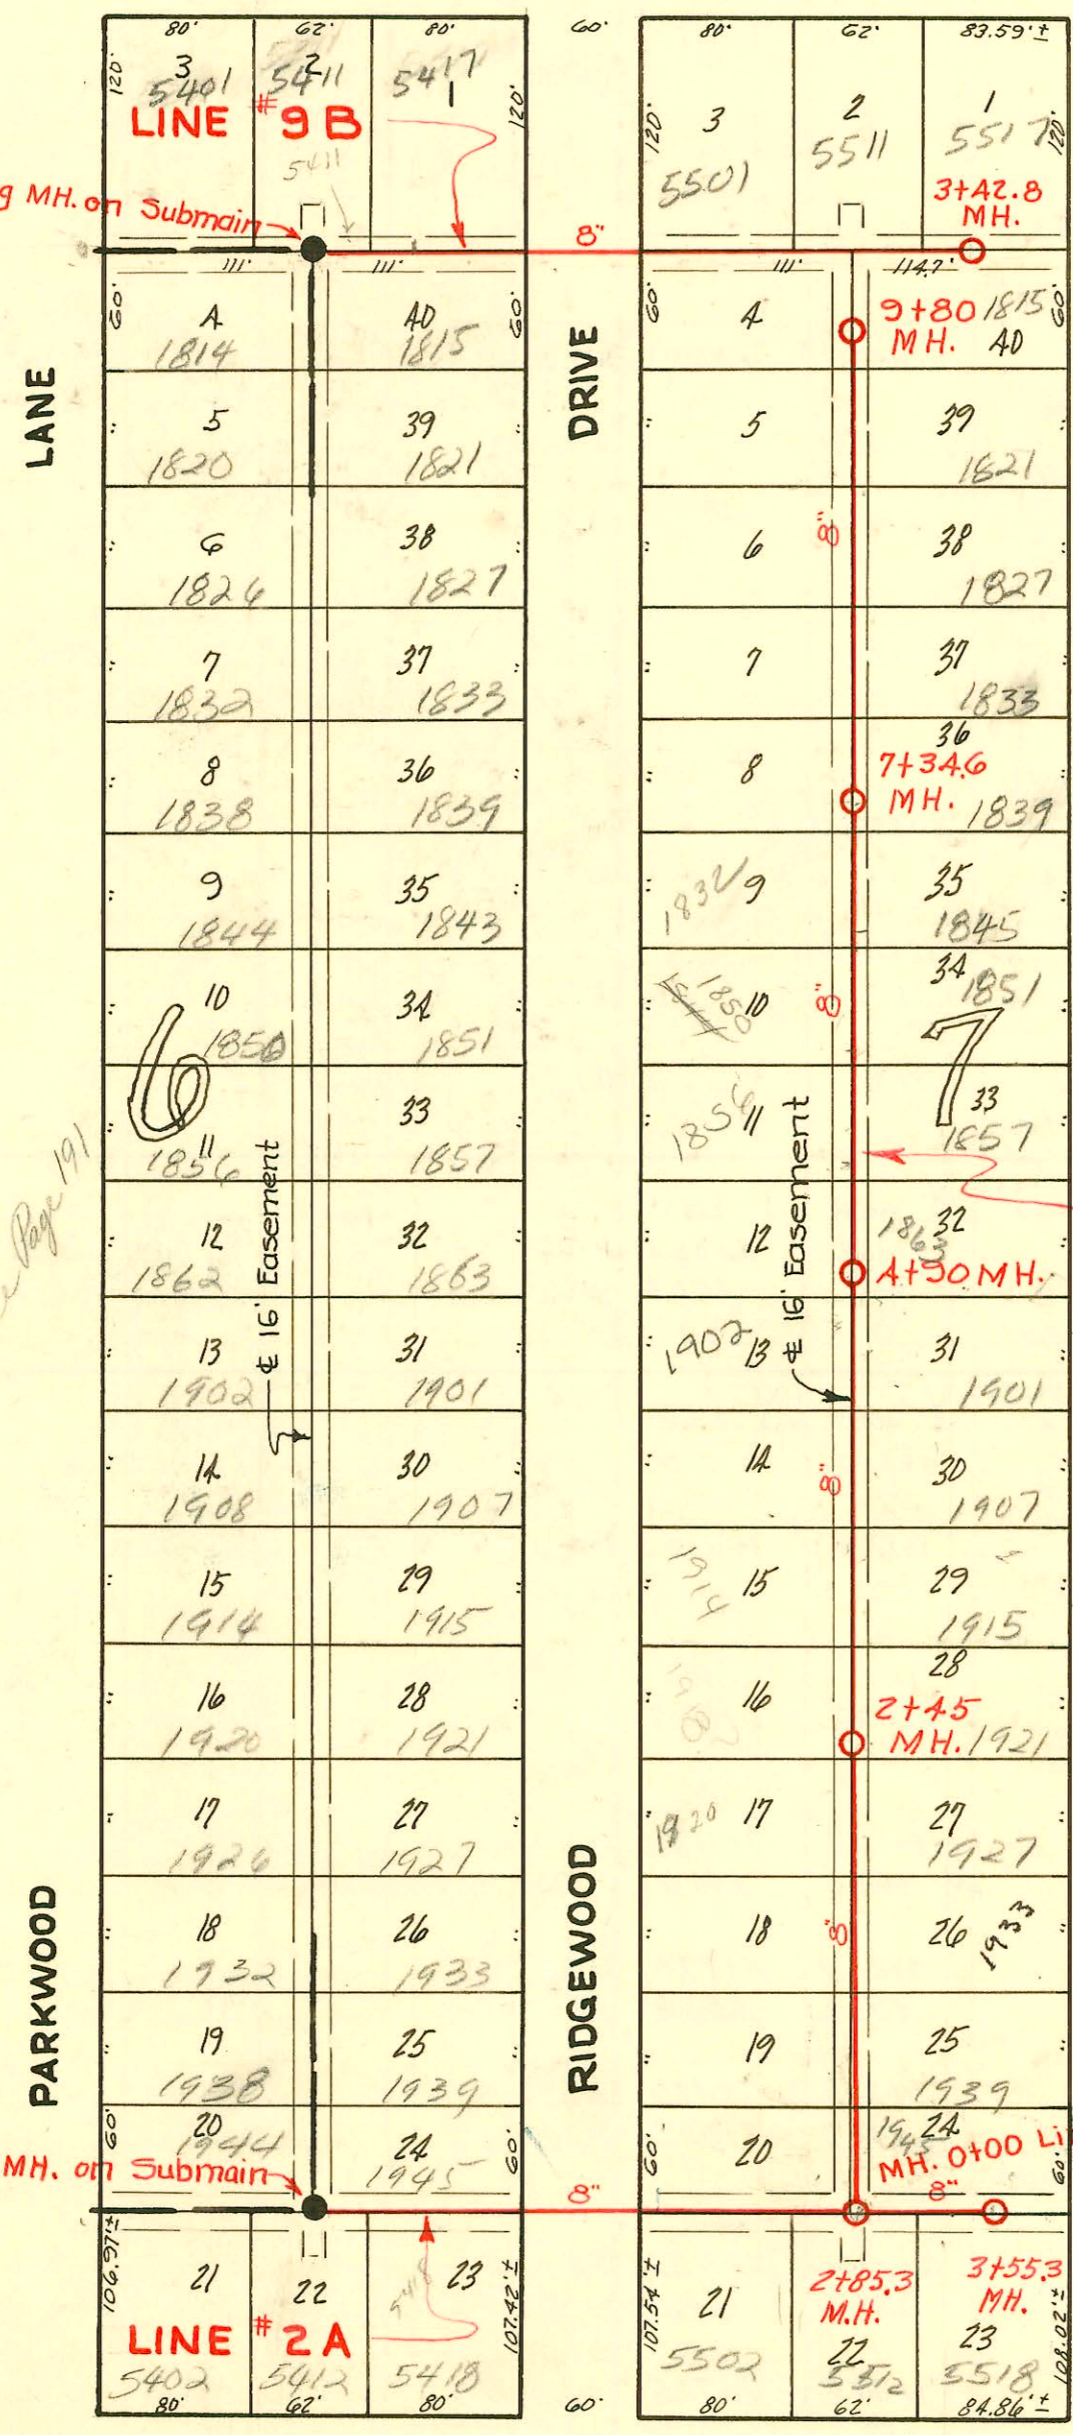

MH. 0+00 Line#2A-Existing MH. on Submain

MH. 2+85.3 Line#2A

See Page 191

NOTE: See page 196 for title, name of contractor and date of project.

4/6

CONSTRUCTION RECORD						SERVICE RECORD						
STATION	ELEVATION		Depth	MANHOLE	4-INCH "Y" BRANCHES		No. of Permit		House Number		DATE OF PERMITS	
	Ground	Grade			North West	South East	North West	South East	North West	South East	North West	South East
Line # 2A 0+00	130.9	121.64	9.48	0+00 Exist'g MH.								
1+00	133.1	123.57	19.81			0+52.3		C 76413 #3868	5418 R Mt. Vernon		2-6-80 2-20-51	
2+00	135.7	125.5	10.44			1+97.0		C 76413 #4336	5502 R Mt. Vernon		2-4-80 4-9-51	
2+85.3	138.1	127.18	11.19	2+85.3		2+69.2		#4335	5512 Mt. Vernon		4-9-51	
3+00	138.3	127.43	11.12			3+35.6		95-1552-1 #4334	5518 R Mt. Vernon		10-3-95 4-9-51	
3+55.3	139.8	128.39	11.67	3+55.3								
Line # 8 0+00	138.1	127.36	11.01	0+00=2+85.3 in Line # 2A	Y's West	Y's East						
					0+17.0	0+14.0	#4943	#3641	1944 R Edgemoor	1945 S Edgemoor	6-12-51	1-11-59
					+65.5	+62.5	#4944	#3642	1938 R Edgemoor	1939 S Edgemoor	6-12-51	2-11-51
1+00	139.0	127.78	11.47		1+26.6	1+23.0	#4945	#3643	1932 R Edgemoor	1933 S Edgemoor	6-12-51	4-13-87 1-11-51
					+84.0	+81.0	#4946	#3644	1926 R Edgemoor	1927 S Edgemoor	6-12-51	1-11-51
2+00	140.1	128.18	12.12		2+35.6	2+32.6	#4947	#3645	1920 R Edgemoor	1921 S Edgemoor	6-12-51	1-11-51
2+45	140.2	128.36	12.09	2+45								
3+00	140.2	128.58	11.83		3+05.2	3+02.2	#4948	#3646	1914 R Edgemoor	1915 S Edgemoor	3-27-81 6-12-51	1-11-51
					+63.2	+60.2	#4949	#3647	1908 R Edgemoor	1909 S Edgemoor	6-12-51	9-9-76 1-11-51
4+00	139.0	128.98	10.22		4+23.6	4+20.6	#4950	#3648	1902 R Edgemoor	1903 S Edgemoor	6-12-51	1-12-51
					+84.0	+81.0	#5012	#3681	1863 R Edgemoor	1863 S Edgemoor	6-18-51	3-9-71 1-12-51
4+90	138.6	129.34	9.54	4+90.0								
5+00	138.8	129.38	9.68		5+47.1	5+44.1	#5016	#3423	1856 R Edgemoor	1857 S Edgemoor	2-6-91 6-18-51	12-20-50
6+00	138.8	129.78	9.31		6+04.6	6+01.6	#5014	#3422	1850 R Edgemoor	1851 S Edgemoor	9-28-89 6-18-51	12-20-50
					6+67.8	+64.8	#5015	#3421	1844 R Edgemoor	1845 S Edgemoor	6-18-51	3-13-94 12-20-50
7+00	138.8	130.18	8.90		7+25.0	7+22.0	#5016	#3420	1838 R Edgemoor	1839 S Edgemoor	6-18-51	12-20-50
7+34.6	139.1	130.32	9.06	7+34.6								
					7+85.4	7+82.4	#5017	#3001	1832 R Edgemoor	1833 S Edgemoor	6-18-51	11-6-50
8+00	139.5	130.58	9.20		8+46.0	8+43.0	#5018	#3000	1826 R Edgemoor	1827 S Edgemoor	6-18-51	11-6-50
9+00	140.0	130.98	9.22		9+06.8	9+03.8	#5019	#2999	1820 R Edgemoor	1821 S Edgemoor	6-18-51	11-6-50
					+67.0	+64.0	#5020	#2998	1814 R Edgemoor	1815 S Edgemoor	6-18-51	3-2-75 11-6-50
9+80	140.2	131.30	9.17	9+80								
Line # 9B 0+00	136.9	129.00	8.16	0+00 Existing MH.	Y North	Y South						
					0+07.6		#3636		5411 S Fennell		1-11-51	
					0+52.5		#3637		5417 S Fennell		10-28-85 1-11-51	
1+00	136.9	129.58	7.56		1+97.7		#3638		5501 S Fennell		1-11-51	
2+00	138.1	130.16	8.21		2+67.6		#3639		5511 S Fennell		1-11-51	
3+00	140.4	130.74	9.89		3+42.8	3+31.8	#3640		5517 S Fennell		1-11-51	

C 23177 - 1863 S Edgemoor - J C Severn 3-9-71 - top (5+04.8)