


CONSTRUCTION RECORD SERVICE RECORD



NOTE: See page 196 for title, name of contractor and date of project.

66

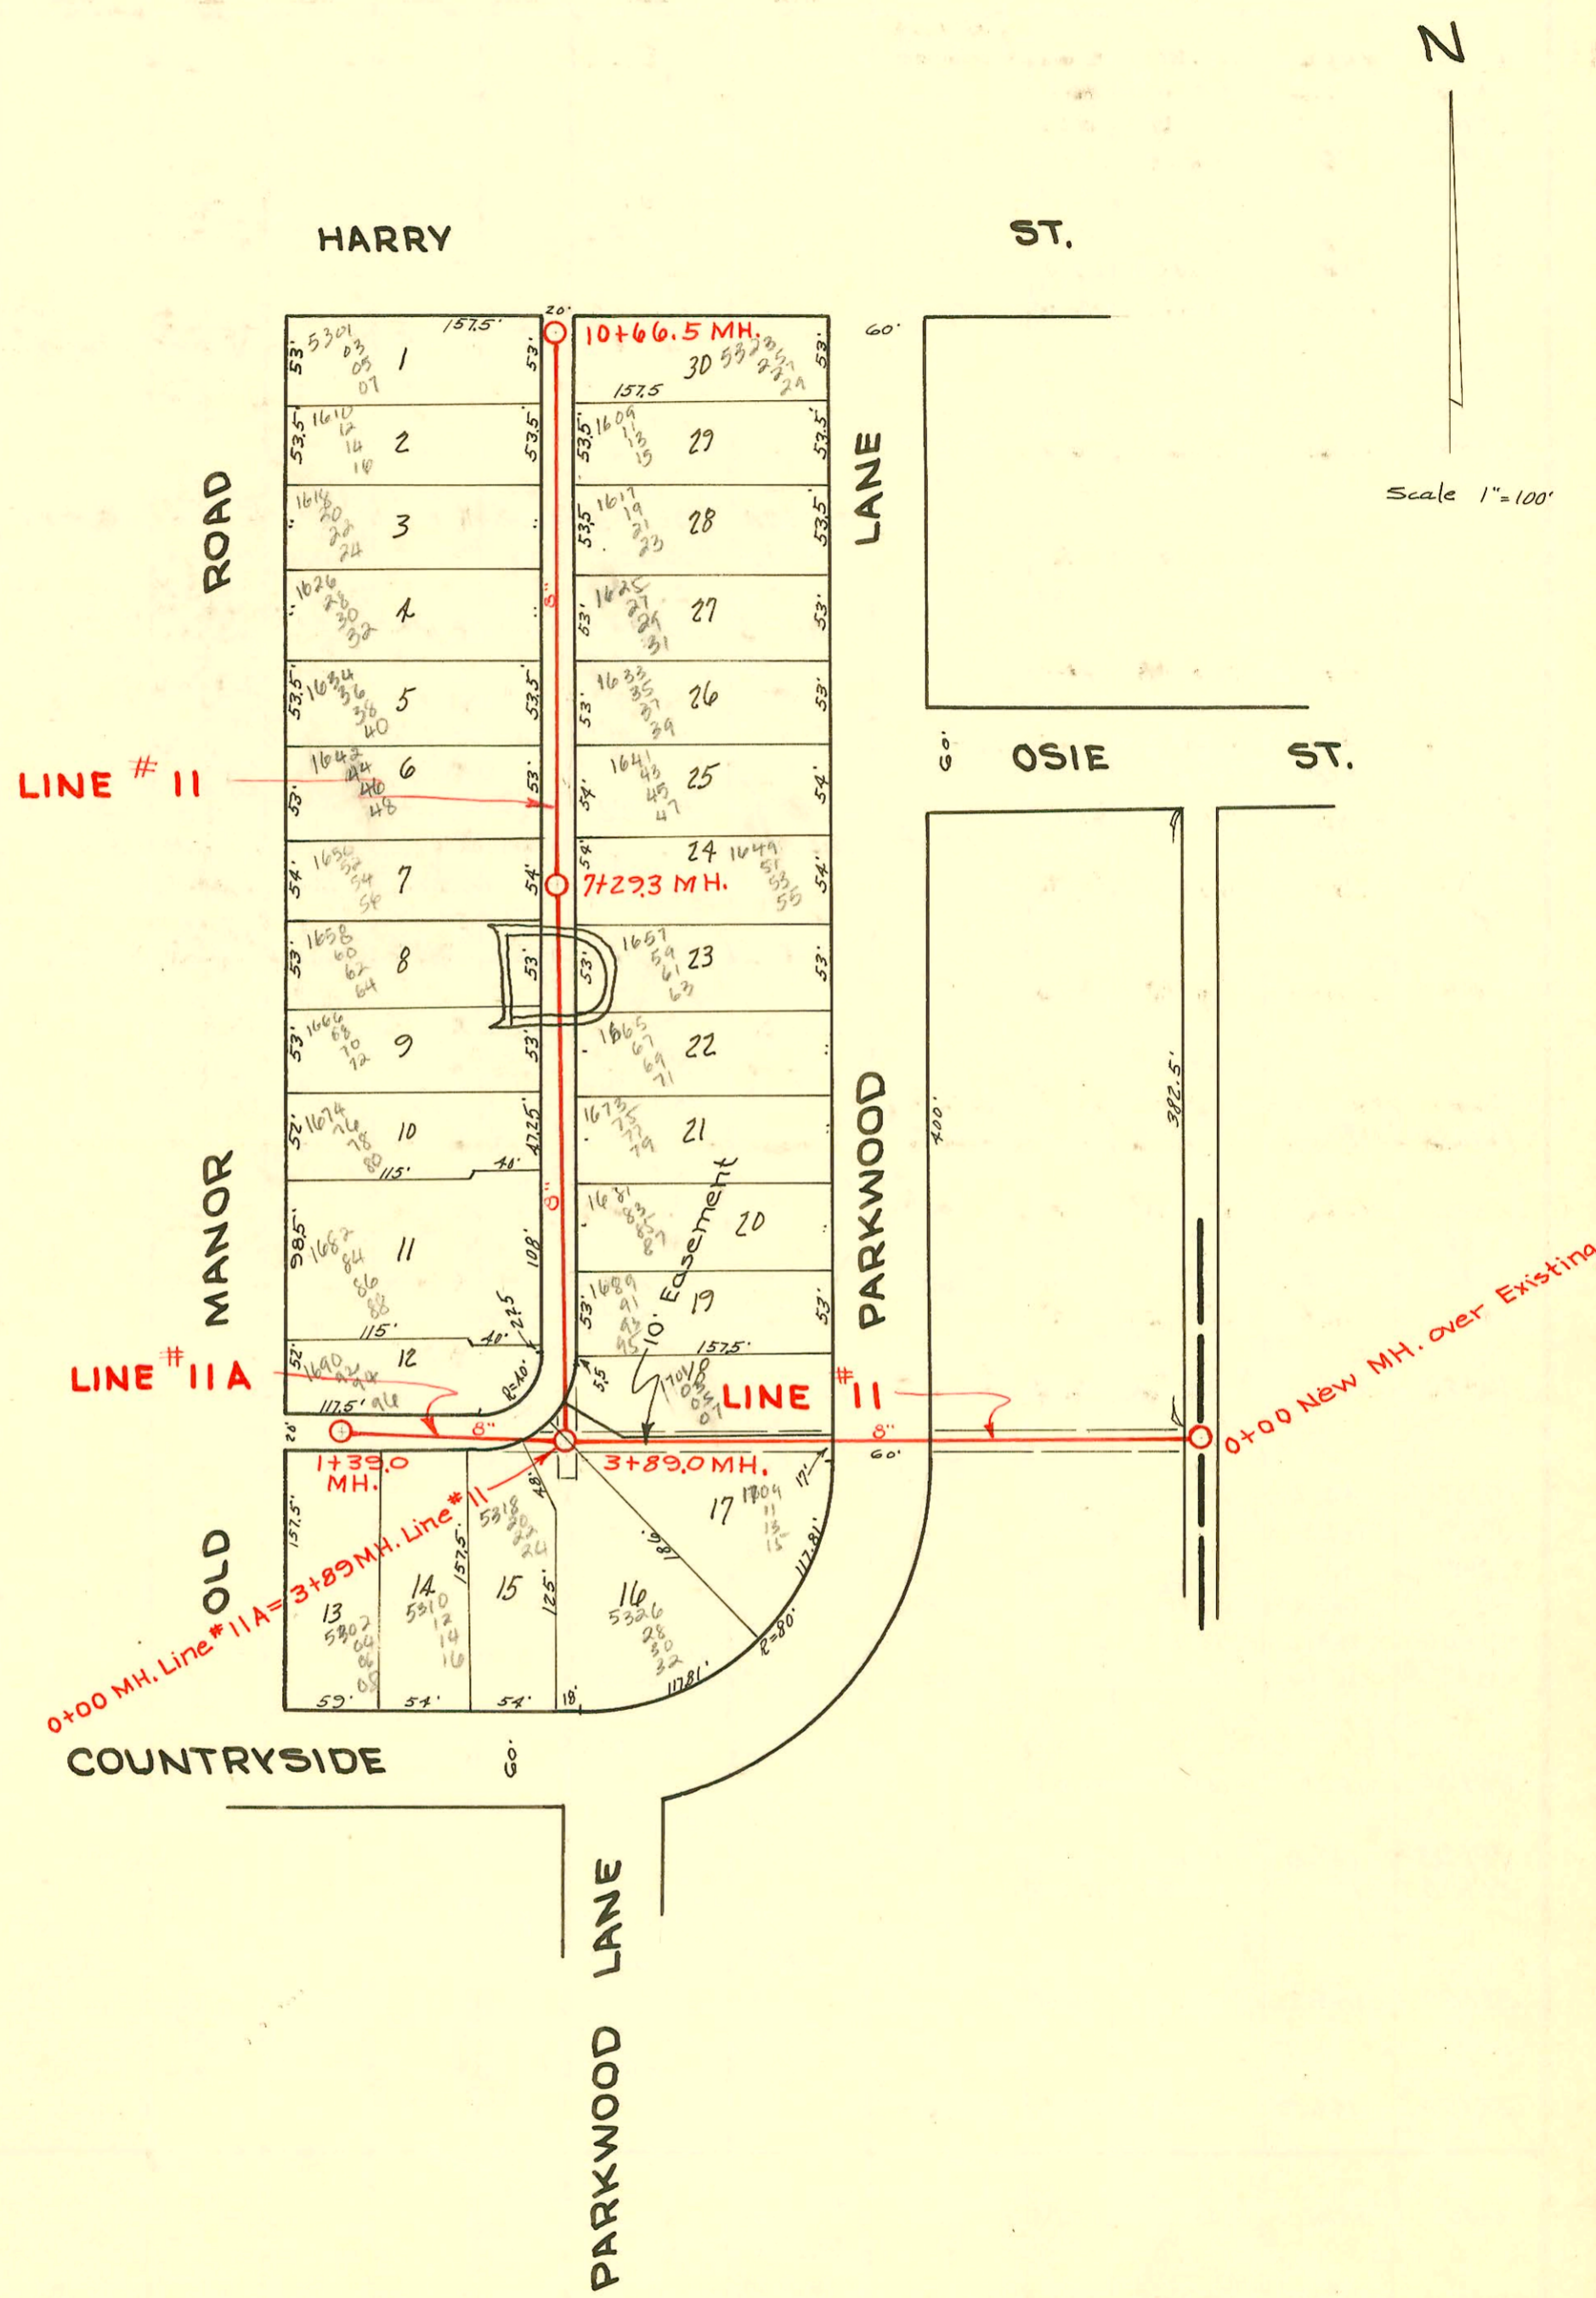