


CONSTRUCTION RECORD

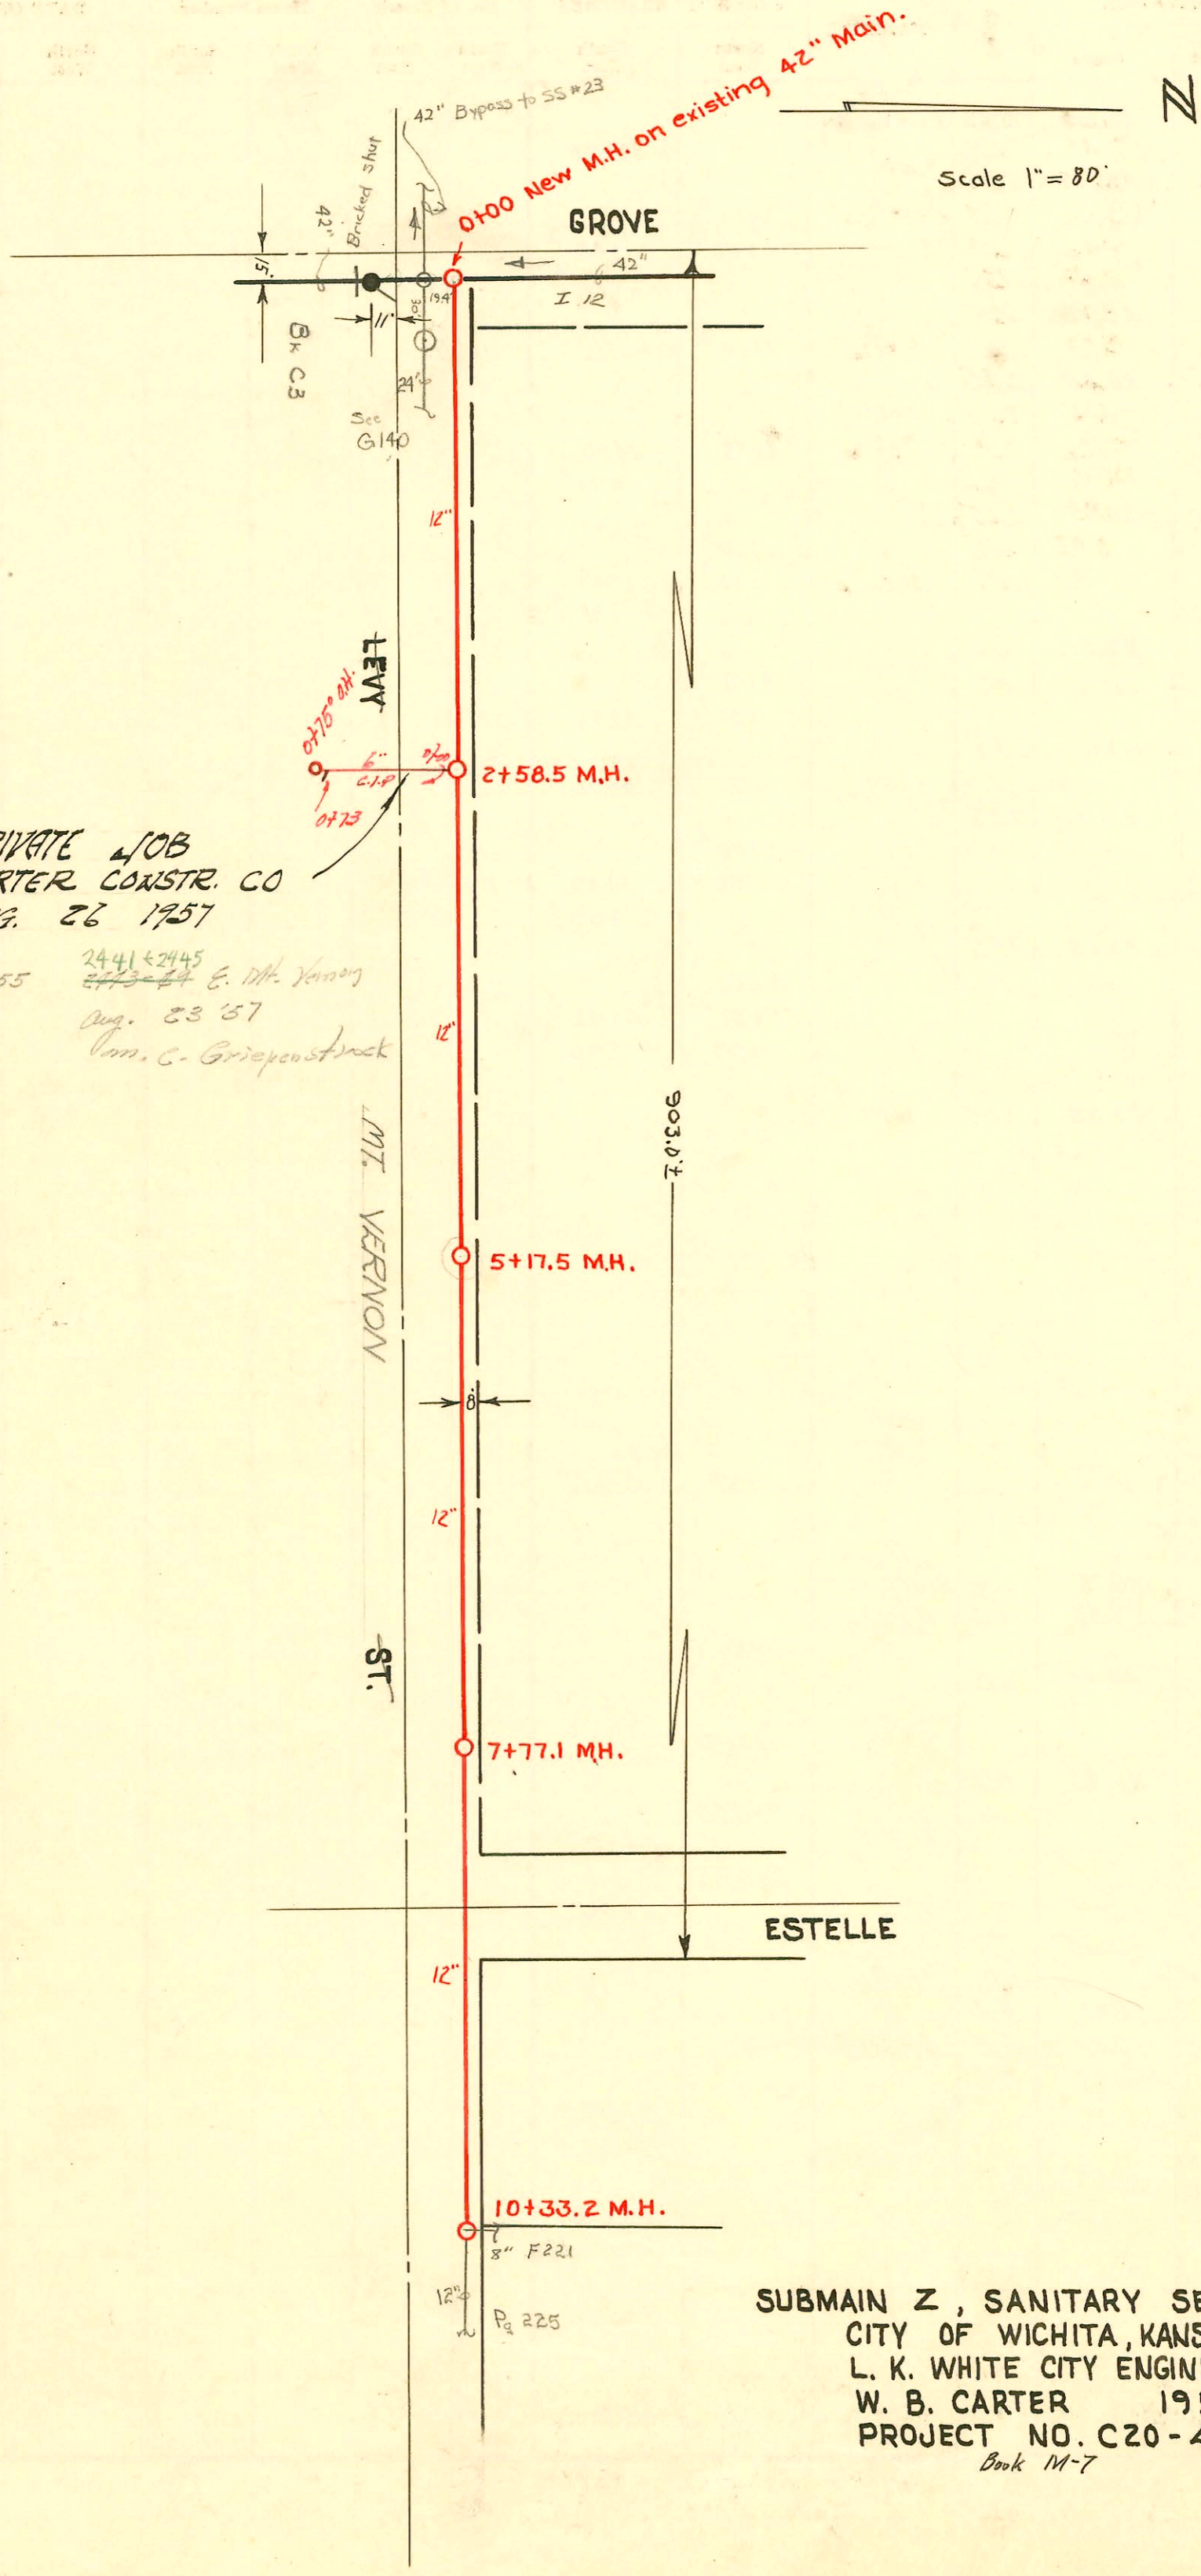

Scale 1" = 80'

PRIVATE JOB
 W.B. CARTER CONSTR. CO
 AUG. 26 1957

Permit # 5155
 2441 & 2445
 E. Mt. Vernon
 Aug. 23 '57
 Wm. C. Griepentrock

SUBMAIN Z, SANITARY SEWER # 12
 CITY OF WICHITA, KANSAS
 L. K. WHITE CITY ENGINEER
 W. B. CARTER 1950
 PROJECT NO. C20-41
 Book M-7

CONSTRUCTION RECORD						SERVICE RECORD						
STATION	ELEVATION		Depth	MANHOLE	4-INCH "Y" BRANCHES		No. of Permit		House Number		DATE OF PERMITS	
	Ground	Grade			North West	South East	North West	South East	North West	South East	North West	South East
0+00	98.2	91.05	7.15	0+00 New M.H.								
1+00	97.4	91.15	6.25									
2+00	97.2	91.25	5.95									
2+58.5	97.1	91.31	5.79	2+58.5								
3+00	97.1	91.35	5.75									
4+00	97.0	91.45	5.55									
5+00	97.5	91.55	5.95									
5+17.5	97.3	91.57	5.73	5+17.5								
6+00	97.2	91.65	5.55									
7+00	97.5	91.75	5.75									
7+77.1	97.5	91.83	5.67	7+77.1								
8+00	97.5	91.85	5.65									
9+00	97.5	91.95	5.55									
10+00	98.2	92.05	6.15									
10+33.2	98.4	92.08	6.32	10+33.2								

Add/Remodel to Mead Middle School - SWR 2002-00177 11/8/02 - SE Corner or East of new addition 46.6' of private mt, 1 Cast Iron town CO - 2601 E Skinner - Tri State Pkg

1409 - Private Line Connection - 2601 E. Skinner (School) - 5-28-52 - Orby Bros.
 # 1686 - Private Line Connection - 2601 E. Skinner (School) - 6-19-52 - Orby Bros.