

REVERSE RECORD

CONSTANT FROM RECORD

DATE

BY

DATE

BY

DATE

BY

DATE


BY

DATE

BY

DATE

BY

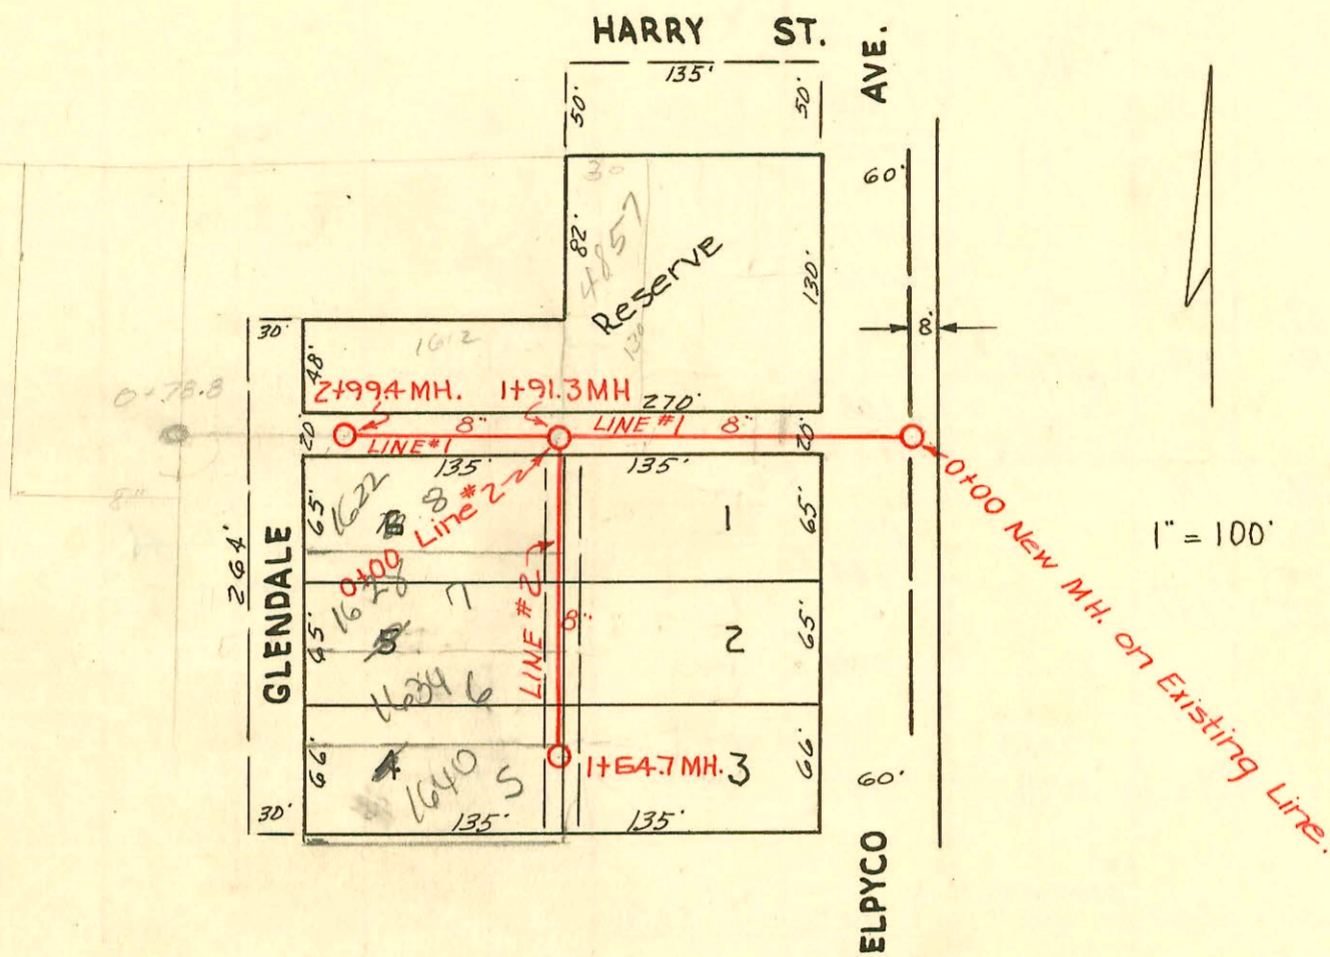

392
221
156
789

LAT. 41, D.C.S., S. S. #12
 CITY OF WICHITA, KANSAS
 L.K. WHITE CITY ENGINEER
 UTILITY CONTRACTORS INC. 1950
 PROJ. NO. C 29-39
 AUGUST 5, 1950
 Bk. M-2

top #4478 1622 1 Glendale Lago - 4 - 26-51
 top #3793 - 4851 E. Harry - 1-15-53 - C. R. Leidy #10724 lead off 4851 E. Harry L. L. Donohue 6-23-59
 top #1343 - 4857 E. Harry 6-24-58 La Song Jr.
 #8900 - 4805 E. Harry - Queen Pllg. 12-31-58

*Y's cked
dw.*

CONSTRUCTION RECORD

SERVICE RECORD

Line # 1

STATION	ELEVATION		Depth	MANHOLE	4-INCH "Y" BRANCHES		No. of Permit		House Number		DATE OF PERMITS	
	Ground	Grade			North West	South East	North West	South East	North West	South East	North West	South East
0+00	151.6	138.00	13.60	0+00 New MH.								
1+00	149.4	138.40	11.00		0+59 ²		#1890		4865 E. Harry		8-8-50	
1+91 ³	147.7	138.76 out 138.76 in	8.94 8.74	1+91 ³	1+59 ²		#1928		4861 R. Harry E. Harry		8-10-50	
2+00	147.7	139.00	8.70		2+17 ² +64 ³							
2+99 ⁴	145.1	139.43	5.67	2+99 ⁴								
					Y West	Y East						
0+00	147.7	138.94	8.76	0+00 = 1+91.3 in Line #1	0+49	0+52						
1+00	149.7	139.34	10.36		4" SCH 40 - 00 1+04 +58 ²	1+07 ² +61 ²	2002-00354 #4479 #4480	16288 R Blendale 1634 S Blendale		2-11-52 4-26-51 4-26-51		
1+64 ²	150.5	139.60	10.90	1+64.7								

Line # 2

Inf - #4207 - gen C Lago - 1625 E. Harry - 3-24-51
 Inf - #4204 - gen C. Lago - 1613 E. Harry - 3-24-51
 Inf - #4205 - gen C. Lago - 1617 E. Harry - 3-24-51
 Inf - #4206 - gen C. Lago - 1621 E. Harry - 3-24-51
 Inf - #4481 - 1640 S. Blendale - 4-26-51 - gen C Lago (Inf into m.h. 1+64.7)
 Inf - #4630 - 4831 E. Harry - 5-11-51 - Stegins
 Inf - #3845 - 1612 S. Blendale - 1-23-53 - C. B. Coleman
 #3908 - Inf into m.h. 1+91.3 - 4847 E. Harry - 1-28-53 - C. R. Lutz