


TRAP  
(per computer)

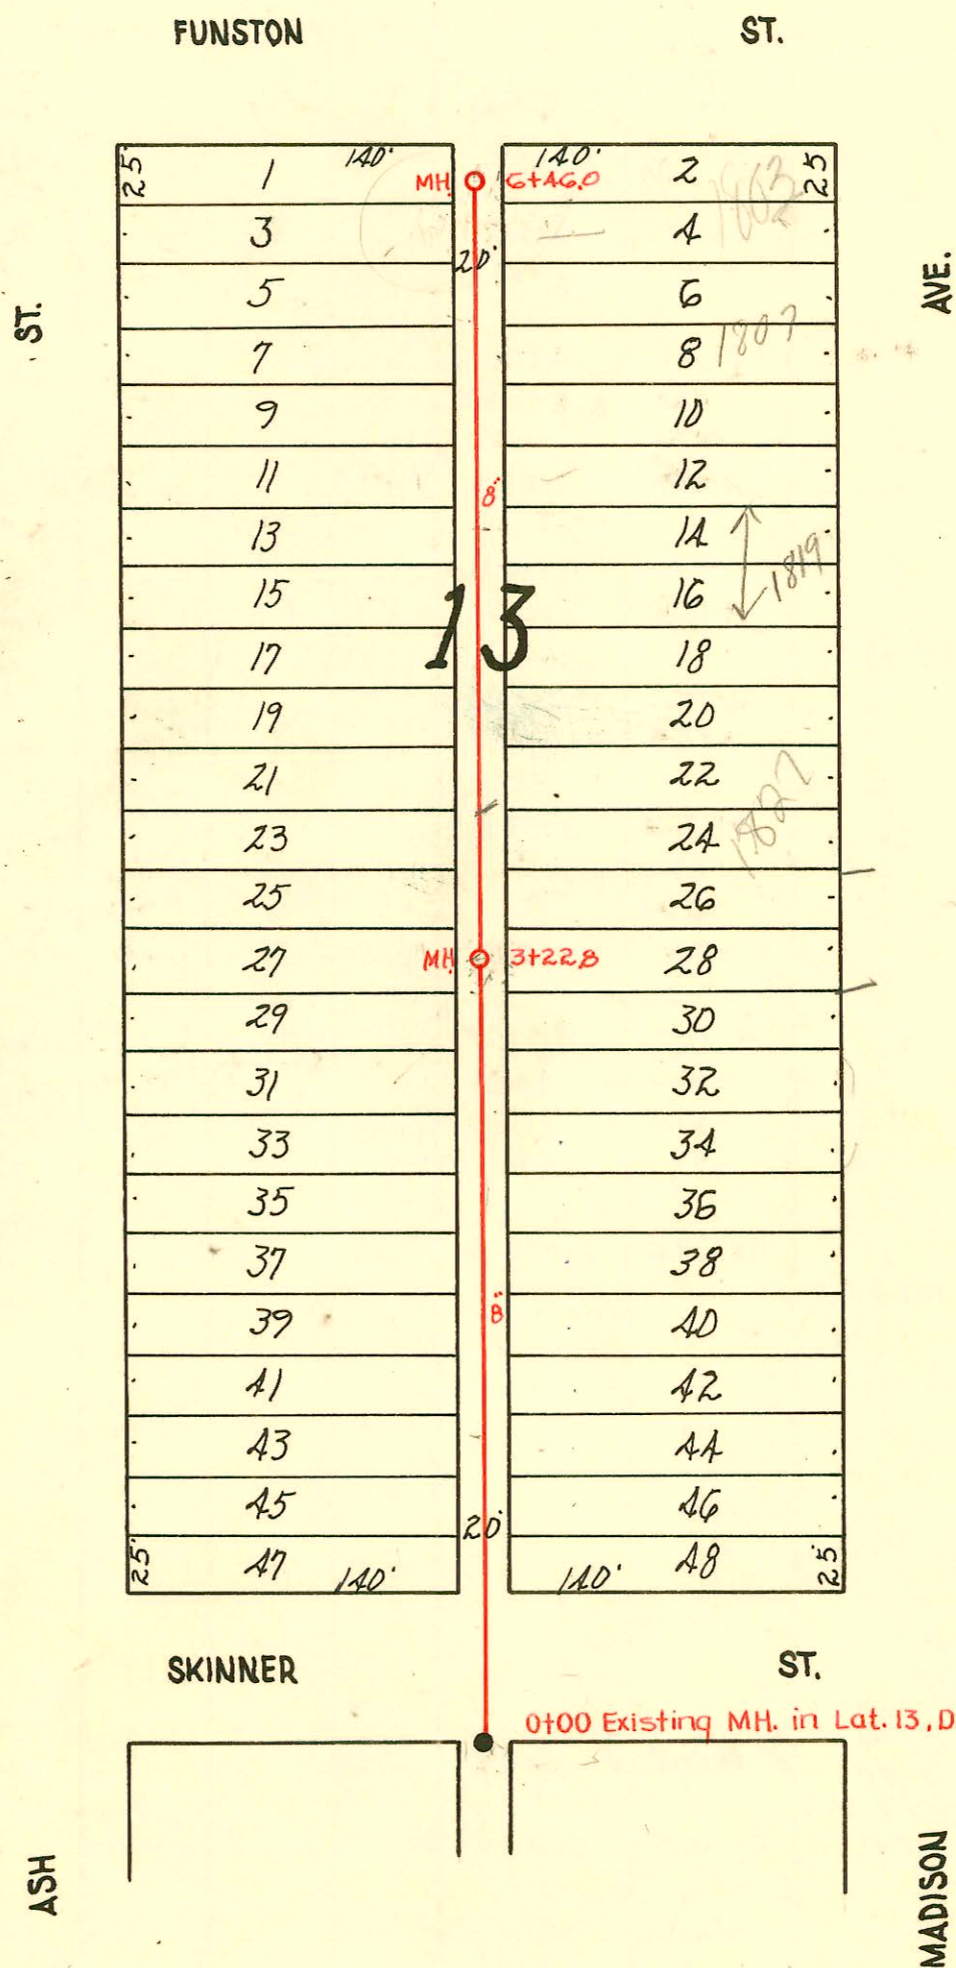

LAT. 12, DIST. A. S., S. S. NO. 12  
 CITY OF WICHITA, KANSAS  
 L. K. WHITE CITY ENGINEER  
 W. B. CARTER OCT., 1950  
 PROJ. NO. C20-48. BOOK # M12

CONSTRUCTION RECORD

SERVICE RECORD

LAT. 12, DIST. A.S. #12

| STATION | ELEVATION |       | Depth | MANHOLE              | 4-INCH "Y" BRANCHES |            | No. of Permit  |                 | House Number    |                 | DATE OF PERMITS   |            |                   |
|---------|-----------|-------|-------|----------------------|---------------------|------------|----------------|-----------------|-----------------|-----------------|-------------------|------------|-------------------|
|         | Ground    | Grade |       |                      | North West          | South East | North West     | South East      | North West      | South East      | North West        | South East |                   |
| 0+00    | 100.3     | 93.54 | 6.76  | 0+00<br>Exist'g M.H. |                     |            |                |                 |                 |                 |                   |            |                   |
| 1+00    | 99.9      | 93.64 | 6.26  |                      | 0+87.3              |            | #1261          |                 | 1860 S. Oak     |                 | 6-22-54           |            |                   |
|         |           |       |       |                      | 1+06.0              |            | #7738<br>#1098 |                 | 1855 S. Madison |                 | 3-23-83<br>6-2-54 |            |                   |
|         |           |       |       |                      | 1+25.0              |            | 1021           |                 | 1852 S. Oak     |                 | 6-7-56            | 6-26-70    |                   |
|         |           |       |       |                      | +51.3               | 1+48.3     | #19848<br>9488 |                 | 1857 S. Madison |                 | 2-1-59            |            |                   |
| 2+00    | 99.9      | 93.74 | 6.16  |                      | 1+92.1              |            | #3588          |                 | 1848 S. Oak     |                 | 1-5-51            |            |                   |
|         |           |       |       |                      | 2+10.5              |            | #3984          |                 | 1855 S. Madison |                 |                   | 3-28-55    |                   |
|         |           |       |       |                      | 2+26.4              |            |                |                 |                 |                 |                   |            |                   |
|         |           |       |       |                      | +50.8               |            |                |                 |                 |                 |                   |            |                   |
|         |           |       |       |                      | 2+63.1              |            | #3540          |                 | 1839 S. Madison |                 |                   | 1-2-51     |                   |
| 3+00    | 100.2     | 93.84 | 6.36  |                      | 2+84.2              | +87.2      | #3559          | #3506           | 1836 S. Oak     |                 | 9-12-52           | 12-29-50   |                   |
|         | 100.3     | 93.86 | 6.44  | 3+22.8               |                     |            |                |                 |                 |                 |                   |            |                   |
|         |           |       |       |                      | 3+30.8              | 3+27.8     | #7007          | #1660           | 1832 S. Oak     |                 | 11-17-53          | 7-15-64    |                   |
|         |           |       |       |                      | +56.1               | +53.1      |                |                 |                 |                 |                   |            |                   |
|         |           |       |       |                      | +80.0               |            | #6966          | 98-00107        | 1828 S. Oak     |                 |                   | 11-13-53   |                   |
| 4+00    | 100.3     | 93.94 | 6.36  |                      | 3+89.1              |            | #520           |                 | 1827 S. Oak     |                 |                   | 3-28-50    |                   |
|         |           |       |       |                      | 4+04.5              |            |                |                 |                 |                 |                   |            |                   |
|         |           |       |       |                      | 4+17.4              |            | #2683          |                 | 1825 S. Madison |                 |                   | 10-14-50   |                   |
|         |           |       |       |                      | 4+26.2              |            | #2715          |                 | 1824 S. Oak     |                 | 10-16-50          |            |                   |
|         |           |       |       |                      | +82.1               | 4+79.1     | #2744          | 00044           | 1817 S. Oak     |                 | 1-6-54            |            |                   |
| 5+00    | 100.7     | 94.04 | 6.66  |                      | 5+00                |            | #6865          |                 | 1817 S. Madison |                 | 10-12-50          | 12-19-51   |                   |
|         |           |       |       |                      | 5+27.3              |            |                |                 |                 |                 |                   |            |                   |
|         |           |       |       |                      | 5+39.6              |            | #2754          |                 | 1811 S. Madison |                 |                   | 10-18-50   |                   |
|         |           |       |       |                      | 5+54.6              |            | #3797          |                 | 1812 S. Oak     |                 |                   |            |                   |
|         |           |       |       |                      | +73.8               | 5+76.8     | #2755          | 022077          | 1807 S. Madison |                 | 1-16-53           | 12-7-70    |                   |
| 6+00    | 100.8     | 94.14 | 6.66  |                      | 6+00.9              |            |                |                 |                 |                 |                   |            |                   |
|         |           |       |       |                      | 6+28                | +25        | #4122          | #12180<br>#1308 | 2110<br>Juniper | 1803 S. Madison |                   | 3-20-51    | 10-5-84<br>9/4/56 |
|         | 101.2     | 94.19 | 7.01  | 6+46.0               |                     |            |                |                 |                 |                 |                   |            |                   |

96-12831-7 86-96 1819 S. Madison  
 96-12473-7 82-96 1819 S. Madison