


CONSTRUCTION RECORD SERVICE RECORD

21st St

2121

Replat see 10-37

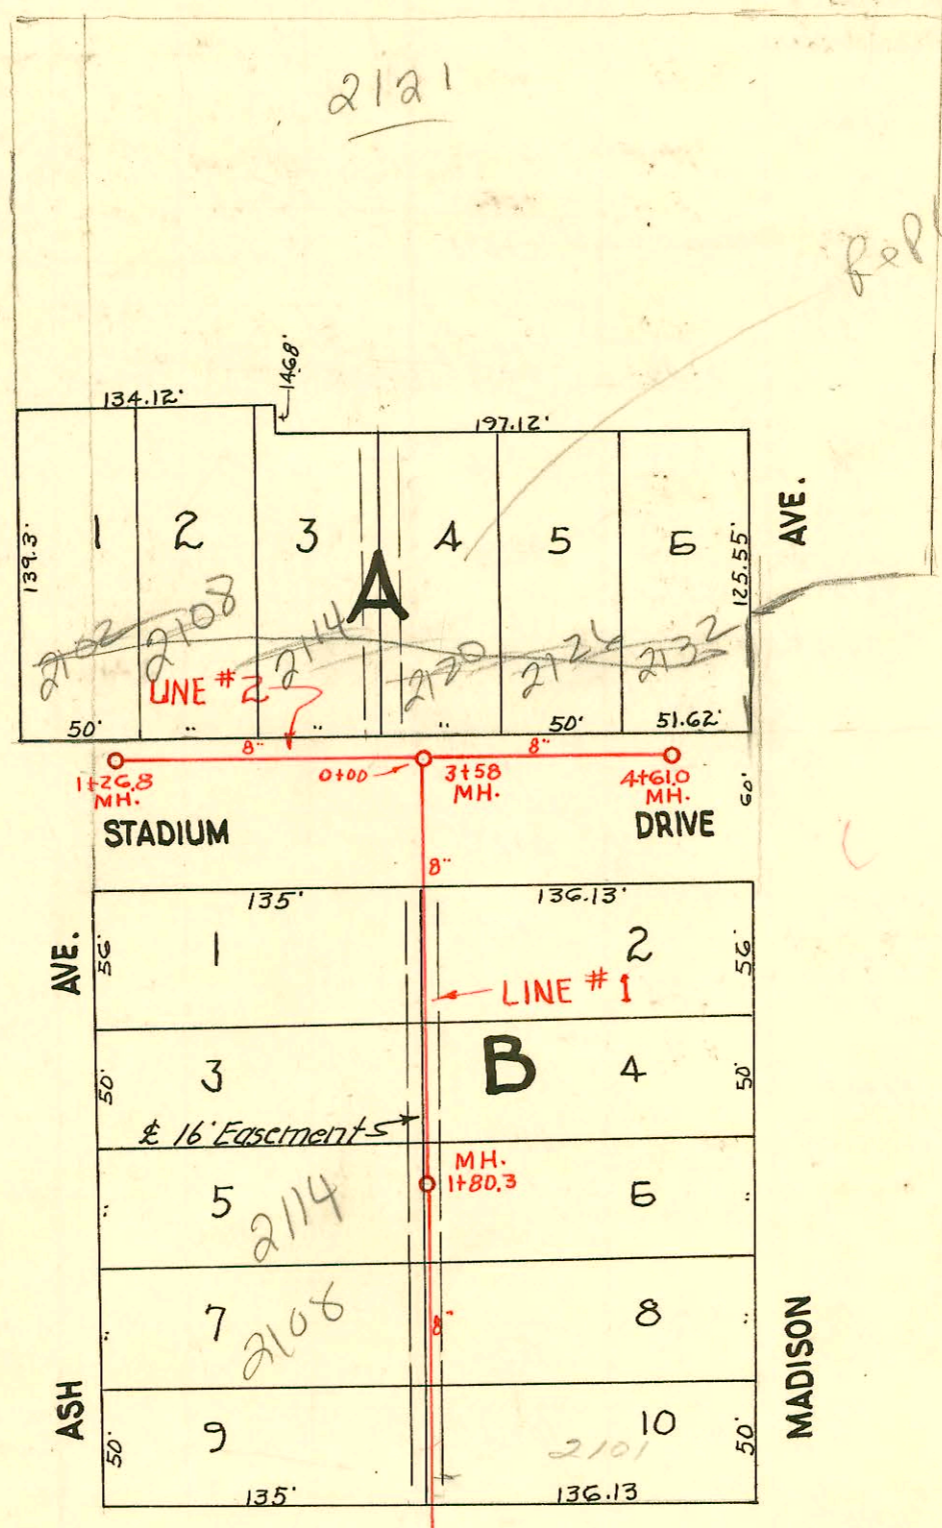

Scale 1" = 80'

0+00 Existing M.H. Approx. 50' S. of S.L. U.W. Ross Adn.

LAT. 19, DIST. E, S.S. NO. 12
 In J. Walter Ross 2ND Adn.
 City of Wichita, Kansas
 L.K. White City Engineer
 W. B. Carter Contractor
 Oct. 1950, Private Contract.
 Book No. 45

CONSTRUCTION RECORD

SERVICE RECORD

LINE NO. 1

LINE NO. 2

STATION	ELEVATION		Depth	MANHOLE	4-INCH "Y" BRANCHES		No. of Permit		House Number		DATE OF PERMITS	
	Ground	Grade			North West	South East	North West	South East	North West	South East	North West	South East
0+00	124.9	118.10	6.80	0+00 Existg MH.			260950 #3036	97-154857 #3983	2102 R Medison	2101 R Medison	4-19-97 11-8-50	9-10-97 3-1-51
1+00	124.5	118.20	6.30		0+59	0+56						
1+80.3	124.8	118.28	6.52	1+80.3	1+07.5	1+04.5	#3037 #3038	#3984 #3985	2108 R Medison	2107 R Medison	11-8-50 9-2-50	3-1-51 3-1-51
2+00	124.7	118.30	6.40		2+05.2	2+02.2	#3039	#3986	2120 R Medison	2117 R Medison	11-8-50	3-1-51
3+00	124.8	118.40	6.40		3+58		#3040	#3987	2126 Medison	2123 R Medison	11-8-50	3-1-51
4+00	125.2	118.70	6.50	4+00	4+29.0	4+25.0	#3506	#3987	2124 R Medison	2125 R Medison	3-17-95 3-1-51 3-17-95	3-1-51
4+61.0	126.1	118.76	7.34	4+61.0	4+53.5		#3507	#3988	2125 R Medison		3-17-95 3-1-51	
0+00	124.9	118.66	6.24	0+00=3+58 in line #1	0+25.0	0+74.6	#3506	#3991	2114 R Medison	2108 R Medison	3-17-95 3-24-94 3-1-51 3-17-95	3-1-51
1+00	124.2	118.76	5.44		1+19.6		#3507	#3992	2102 R Medison		3-17-95 3-1-51	
1+26.8	124.5	118.79	5.71	1+26.8			#3507	#3993	2121 R Medison		6-27-96	