


NOTE: All sewer lines are 8" V.C.P.

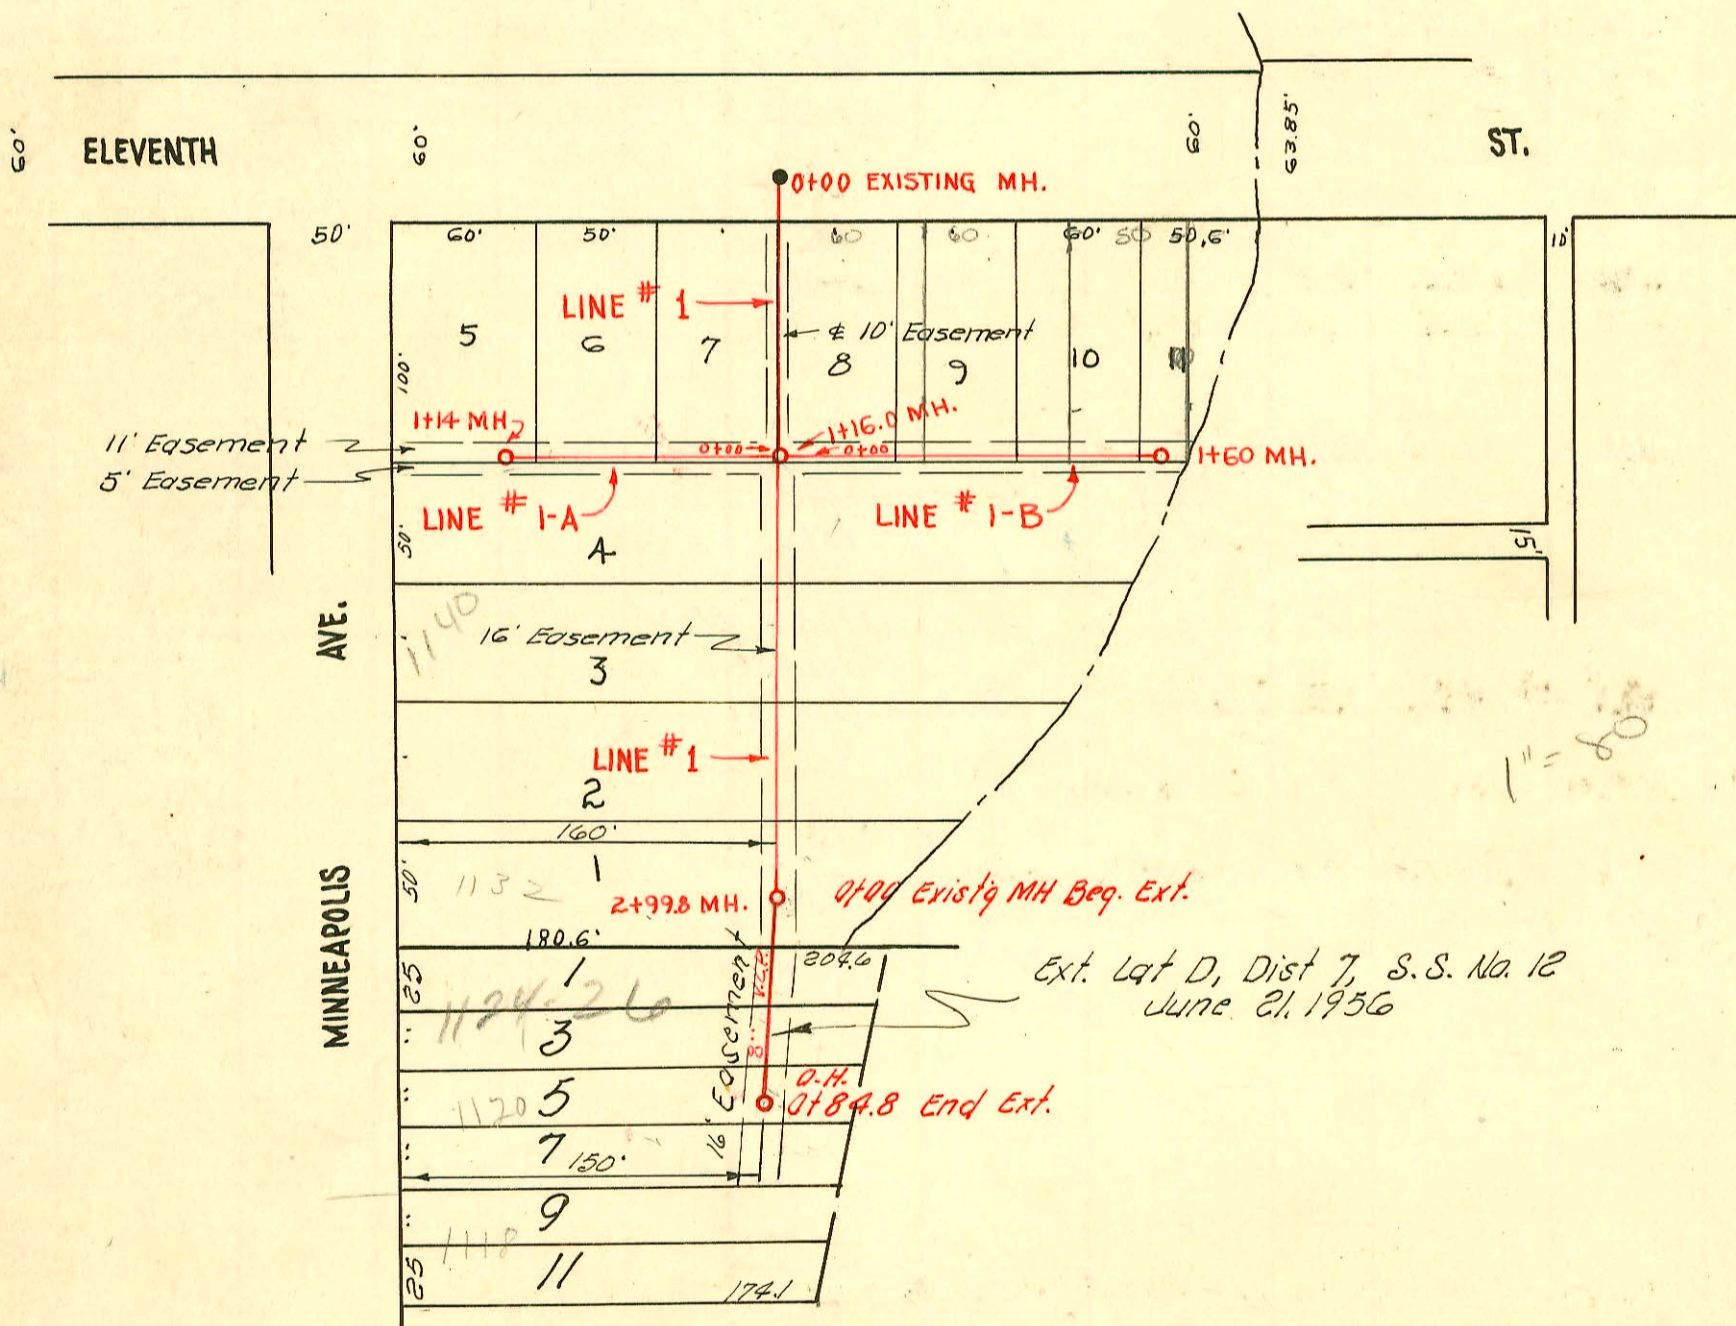

LAT. D, DIST. 7, S.S. #12  
W. B. Carter Constr. Co.  
Nov. 11, 1950, Proj. No. C20-5E  
Book No. E-4

