


CONSTRUCTION RECORD

SERVICE RECORD

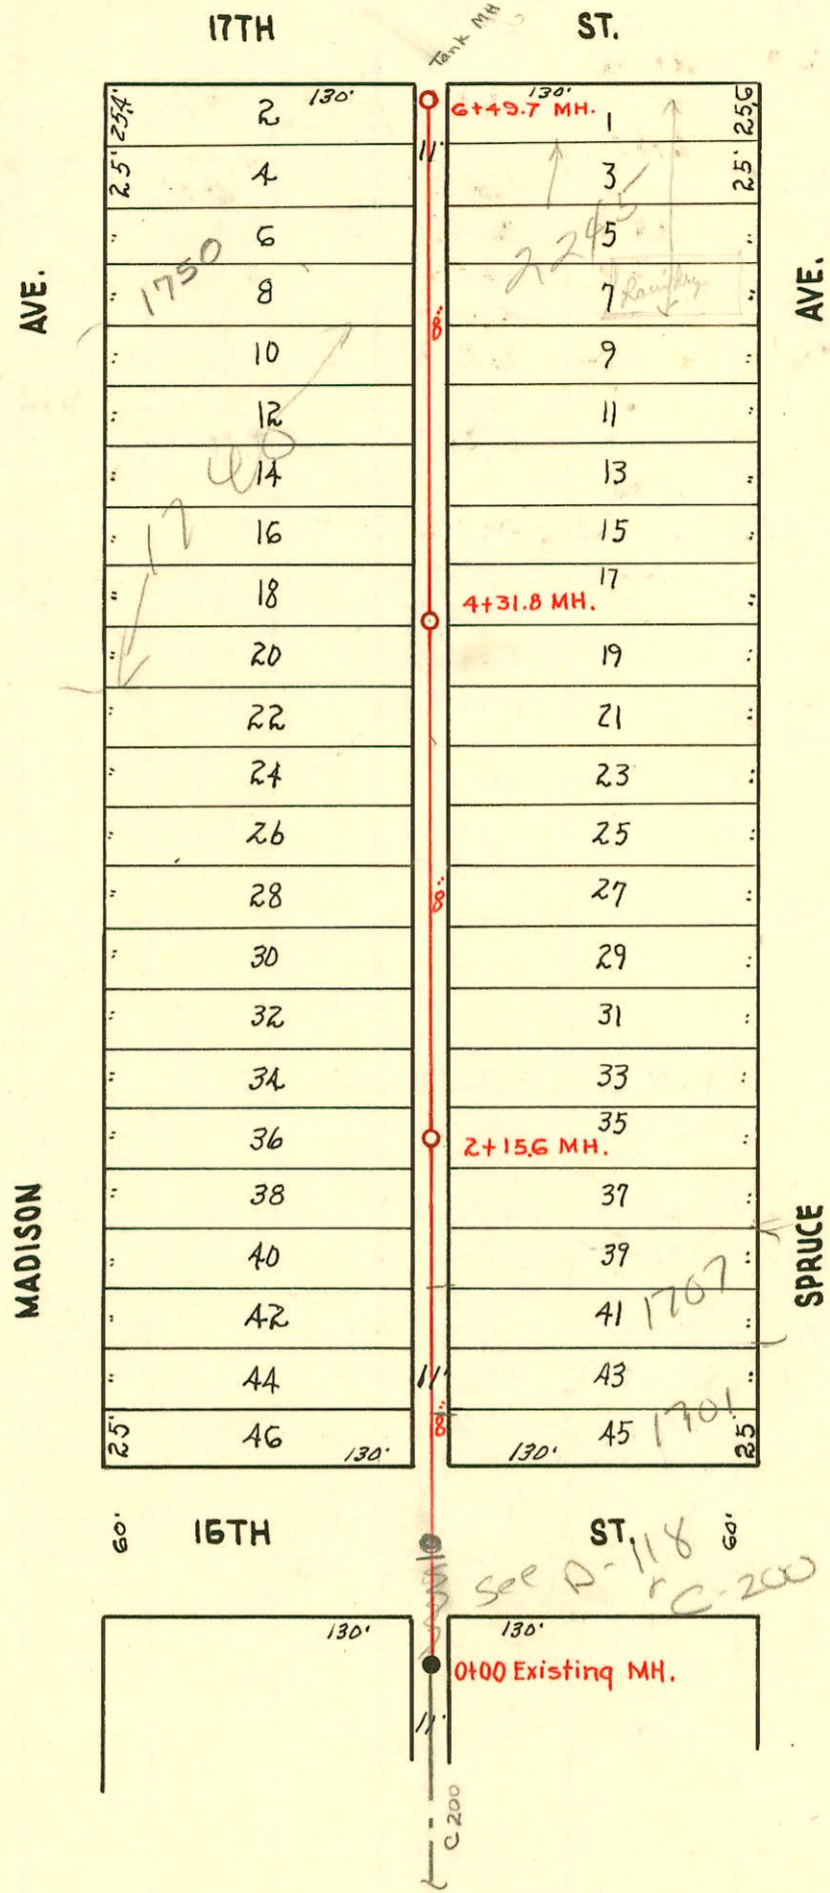

LAT. P, DIST. 0, S.S. #12
 W. B. CARTER - NOV. 29, 1950
 PROJ. NO. C20-20, BOOK # M-5

4" y chd
J.W.

CONSTRUCTION RECORD							SERVICE RECORD					
STATION	ELEVATION		Depth	MANHOLE	4-INCH "Y" BRANCHES		No. of Permit		House Number		DATE OF PERMITS	
	Ground	Grade			North West	South East	North West	South East	North West	South East	North West	South East
0+00	120.3	113.74	6.56	0+00 Existg MH.	0+77	0+94	#1258		1702 N. Madison		5-15-52	
1+00	120.2	113.84	6.36					#5148				7-5-51
					1+28.4	+25.4						
					+58.9	1+55.9	#5147		1727 N. 1767		5-9-78	7-5-51
					+95.5	+92.5	#2140	3343	1726 S. 7. Madison		8-12-52	12-12-50
2+00	120.7	113.94	6.76									
2+15.6	120.8	113.96	6.84	2+15.6	2+34.7							
						2+50.3		"	1717 N.			12-12-50
					2+80.0		#734	3344	1730			
						2+95.2		"	N. Madison		1-4-54	
								3345	1723 N.			12-12-50
3+00	121.0	114.04	6.96		3+40.8	3+37.8		#4807	1727 N.			1-15
					+86.1	+83.1			1727 N.			
4+00	121.7	114.14	7.56			4+10.7						
4+31.8	121.9	114.17	7.73	4+31.8	4+40.4	4+37.4	#01554		1740 N. A	See Below	6-25-51	
					+65.3		6250		Madison		2-19-51	
						4+76.7		#6580	1745 N.			9-28-53
					4+93							
5+00	122.1	114.24	7.86		5+26.5	5+23.5						
					+56.6	+53.6						
					5+93.5	5+90.5	17510	#18985	1750, 1750 Madison	2245 S.	11-17-56	4-27-70
6+00	121.7	114.34	7.36			6+20.9						
6+49.7	121.9	114.39	7.51	6+49.7								
2001-01554-6/25/01- 1740 N Madison Ave. Foto- 4" sch 40 Predco 34" No. 1 MH 4+31.8 (4+65.5) Replaced 20' low end 3V45												