


SERVICE RECORD

CONSTRUCTION RECORD

Plat 10-39B

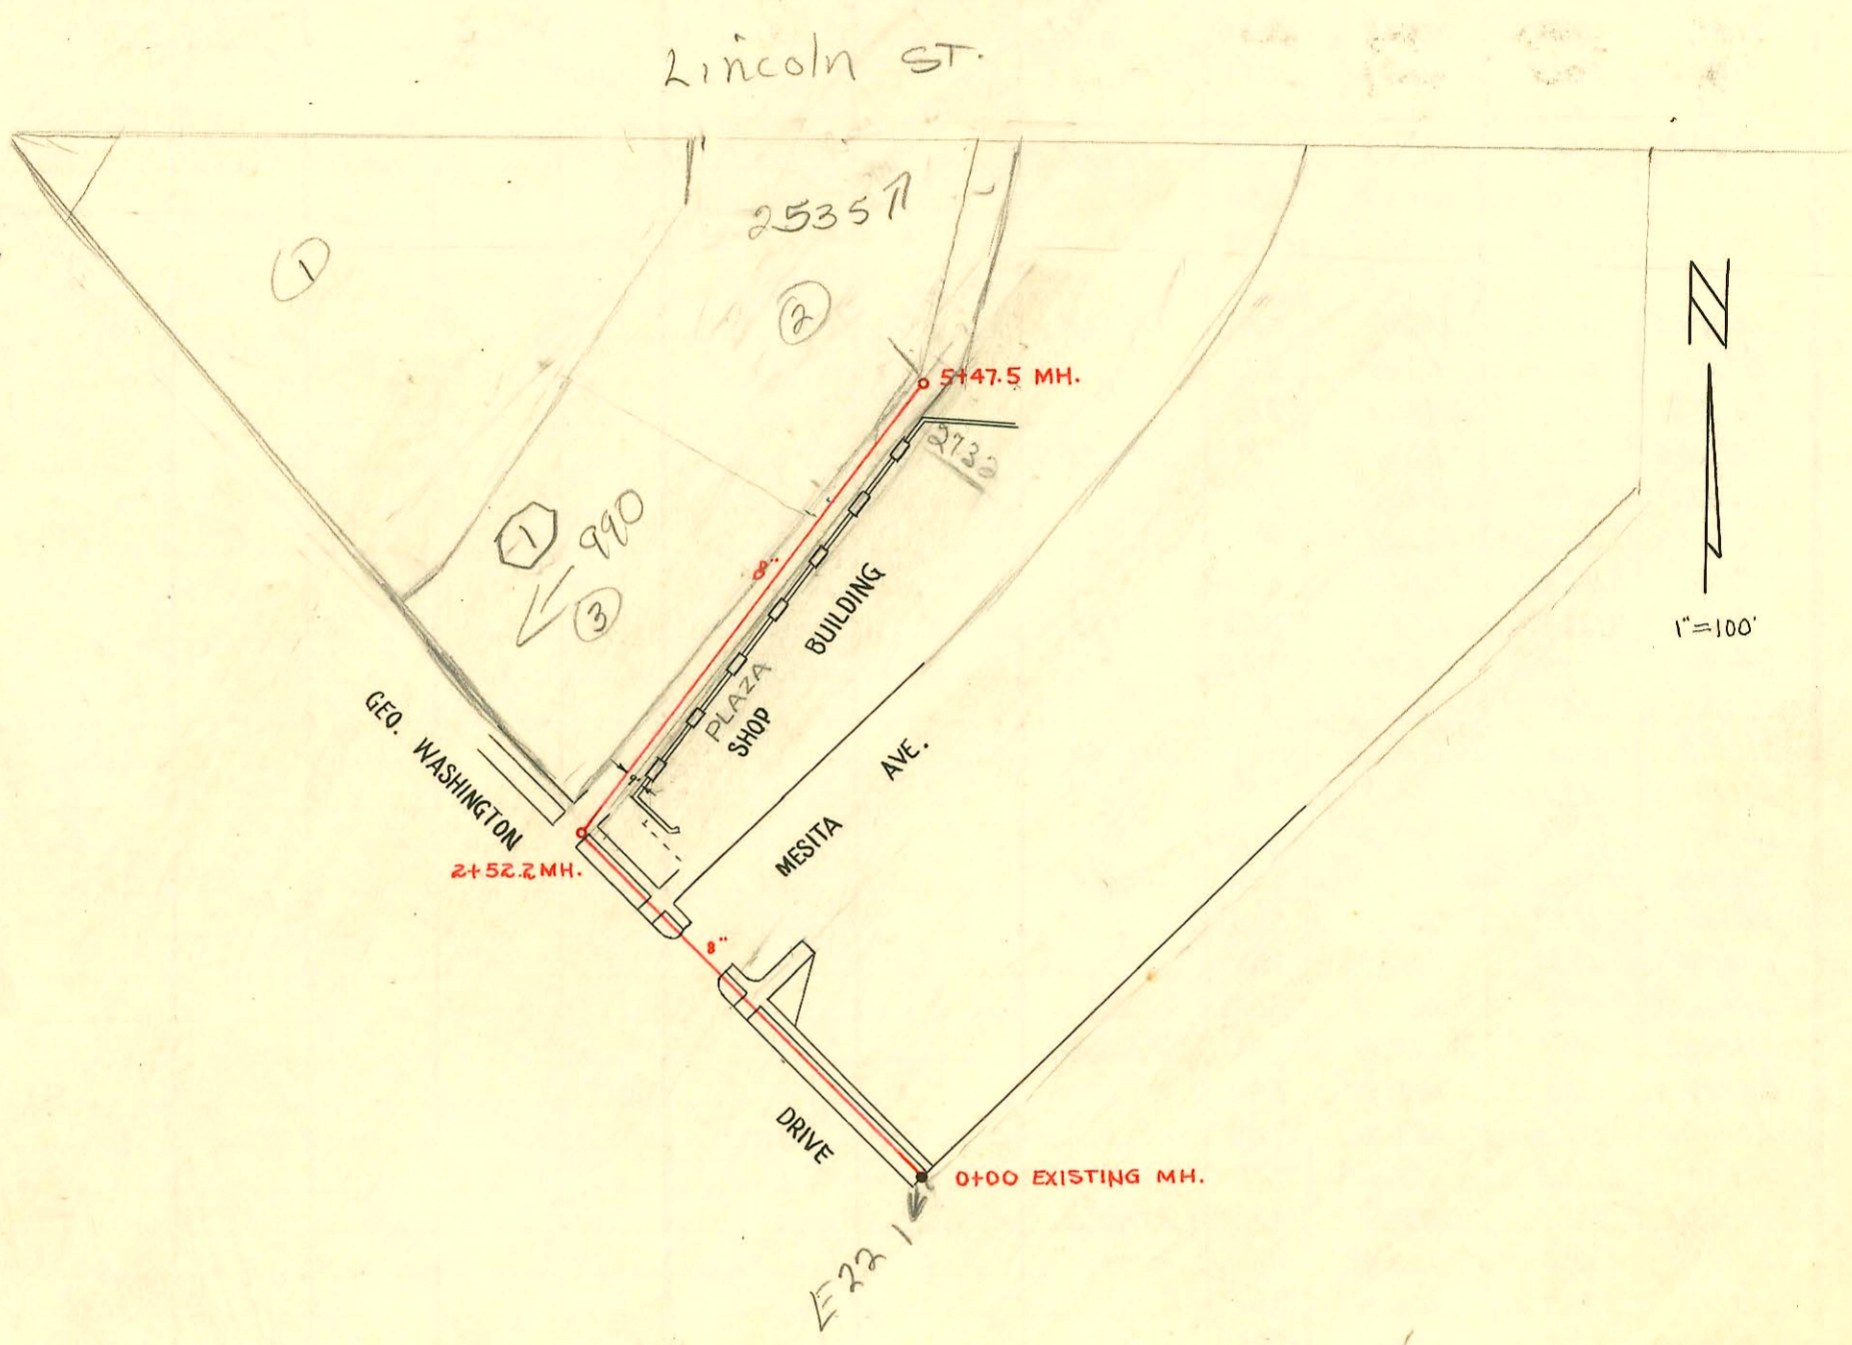

PRIVATE SANITARY SEWER
 IN WOMERS 2ND ADDITION
 W.B. CARTER, DEC. 8, 1950
 BOOK NO. M-4

CONSTRUCTION RECORD						SERVICE RECORD						
STATION	ELEVATION		Depth	MANHOLE	4-INCH "Y" BRANCHES		No. of Permit		House Number		DATE OF PERMITS	
	Ground	Grade			North West	South East	North West	South East	North West	South East	North West	South East
				0+00								
0+00	103.7	97.00	6.70	Exist'g M.H.								
1+00	103.9	97.20	6.70									
2+00	104.6	97.40	7.20									
2+52.2	104.4	97.51 out 97.71 in	6.89 6.69	2+52.2								
3+00	104.3	97.79	6.51									
						3+08.8		# 3153		2702 Mesita		11-20-50
						+41.7		# 3154		2706 Mesita		11-20-50
						+81.6		# 3155		2710 Mesita		11-20-50
4+00	104.7	97.99	6.71			4+14.7		# 3156		2714 Mesita		11-20-50
						+50.6		# 3157		2718 Mesita		11-20-50
					4" Sch 40 PVC 4471.9 tap	+87.4		# 3158	996 S. Co. Wash. St. 253 S Lincoln	2722 Mesita	8-25-93	11-20-50
5+00	104.3	98.19	6.11		5+44.5 tap	5+21.0	21942	# 3159		2726 Mesita	10-21-88	11-20-50
5+47.5	104.1	98.29	5.81	5+47.5	mening ab. mt			# 6011		2732 Mesita		10-2-51
								669876		2734 Mesita		12-18-78

MC #

14831 2732 Boulevard Plaza 10-10-95 Burke (addr)

#6012 - 2732 Mesita - 10-2-51 - Frederick Pllg Co
 #1770 - 2726-30 Boulevard Pl. - 7-1-52 - Frederick Pllg Co (line extended).
 # 5003 - 900 Eo. Washington Blvd Tap 7-19-57, Cowan Pllg
 11575 Tap 2700 Mesita Dr. Frederick 9-28-59 2+81.2