


N

Scale 1"=80'

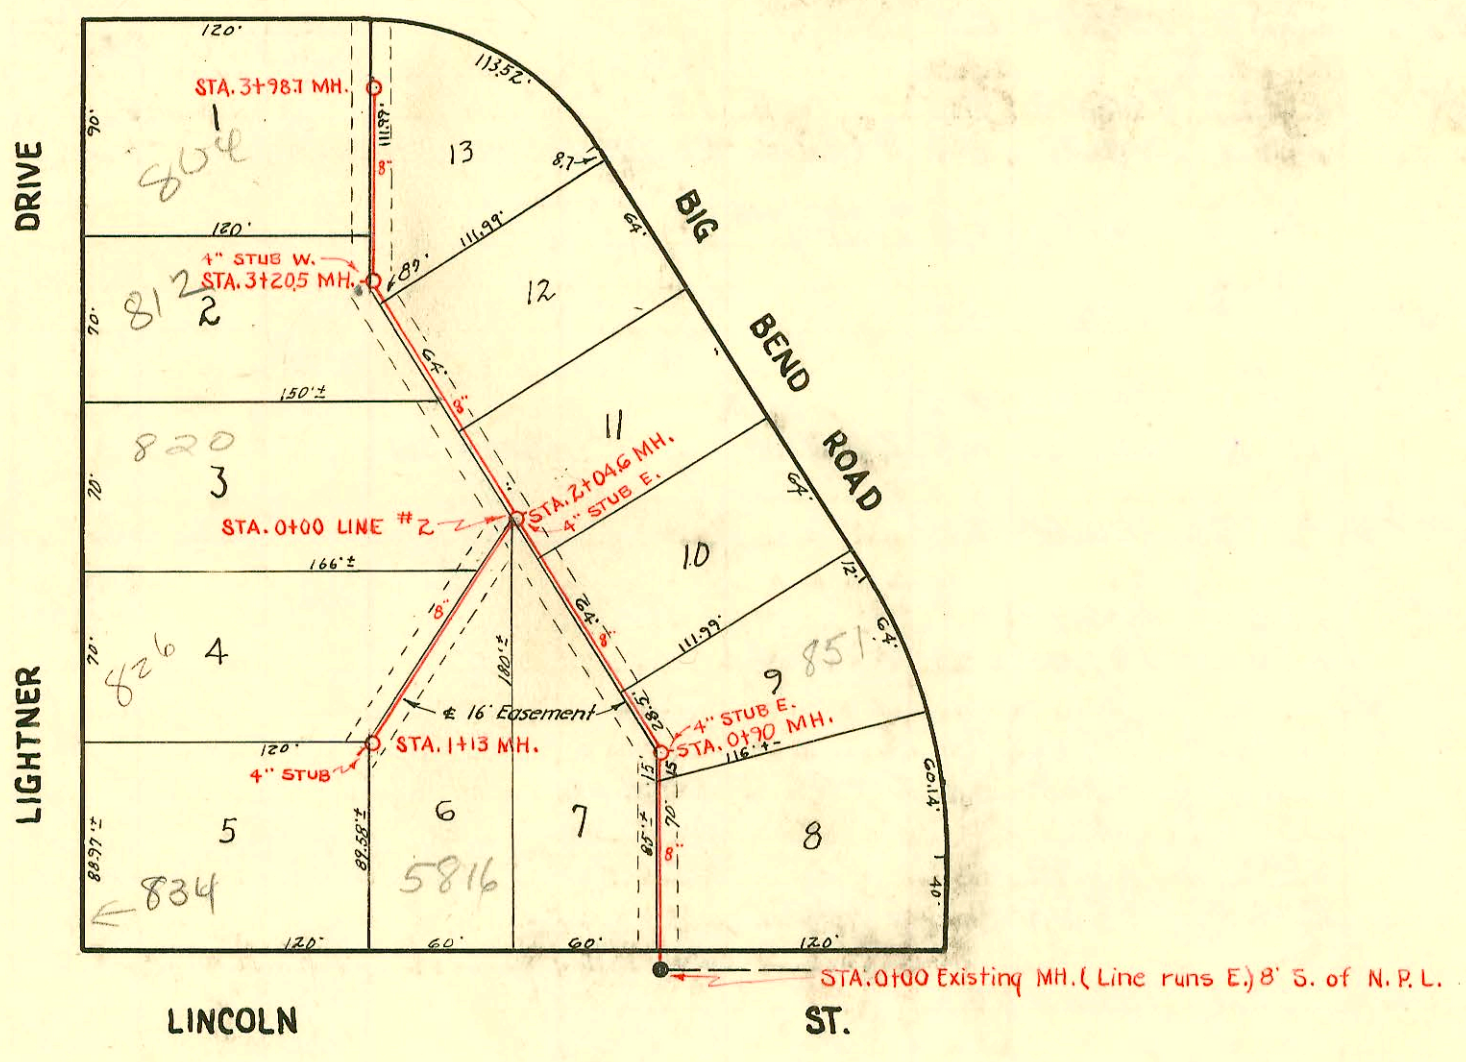

Lot. 3, Submain 3, W.I.S.
 Private Sewer Contract
 Reserve A, Prairie Park Addn.
 City of Wichita, Kansas
 L.K. White City Engineer
 W.B. Carter Contractor
 Book # M5, Feb. 24, 1951

CONSTRUCTION RECORD							SERVICE RECORD						
STATION	ELEVATION		Depth	MANHOLE	4-INCH "Y" BRANCHES		No. of Permit		House Number		DATE OF PERMITS		
	Ground	Grade			North West	South East	North West	South East	North West	South East	North West	South East	
LINE #1	0+00	154.5	145.50	9.00				#4117		859 R		3-13-52	
	0+90	155.6	146.06	9.54	0+90	0+45.3		#344		Big Bend			
	1+00	156.0	146.10	9.90		0+90 (4" stub E)		#6726		851 Big Bend		12-6-51	
					1+13								
						1+49.7		#4727		845 Big Bend		5-24-51	
	2+00	156.5	146.70	9.80									
	2+04.6	156.6	146.73	9.87	2+04.6	2+04.6 (4" stub E)		#4726		839 Big Bend		5-24-51	
					2+23			#4130		820 Lightner		3-20-51	
						2+68.6		#4724		833 Big Bend		5-24-51	
	3+00	157.0	147.30	9.70									
	3+20.5	157.2	147.43	9.77	3+20.5	3+20.5 (4" stub W)							
						3+39.3							
	3+98.7	157.2	147.90	9.30	3+98.7	3+73		#4136		824 Lightner		3-20-51	
						Y west	Y east						
LINE #2	0+00	156.6	146.97	9.63	0+00 = 2+04.6 in Line # 2	0+63.5	0+60.5	#4139	#6725	826 Lightner	5816 E. Lincoln	3-20-51	12-6-51
	1+00	157.1	147.40	9.70	City removed Clay stub with 1+13 stub			58393-7		824 R Lightner		8-28-45	
	1+13	157.1	147.45	9.65				#4141				5-20-51	

#1792
 #4137 - tap - 812 Lightner - 3-20-51 - Howard Shephard tap (3+00.5) 4" SDR 35
 #4725 - tap - 821 Big Bend - 5-24-51 - Howard Shephard
 #5629 - tap - 5824 E. Lincoln - 8-20-51 - game Donald.