


LATERAL 9 MAIN 21 WAR INDUSTRIES SEWER
 BUILT BY: UTILITY CONTR. INC.
 PROJ. NO 468-76-245-80857-000-000-001
 BOOKED 12-23 -80 FROM JLA 13

on map 12-69



DO NOT write
 sewer permit
 until in lieu
 fees are paid
 letter. Figure
 fees as per
 amount per
 permit at time
 connect. No
 55K

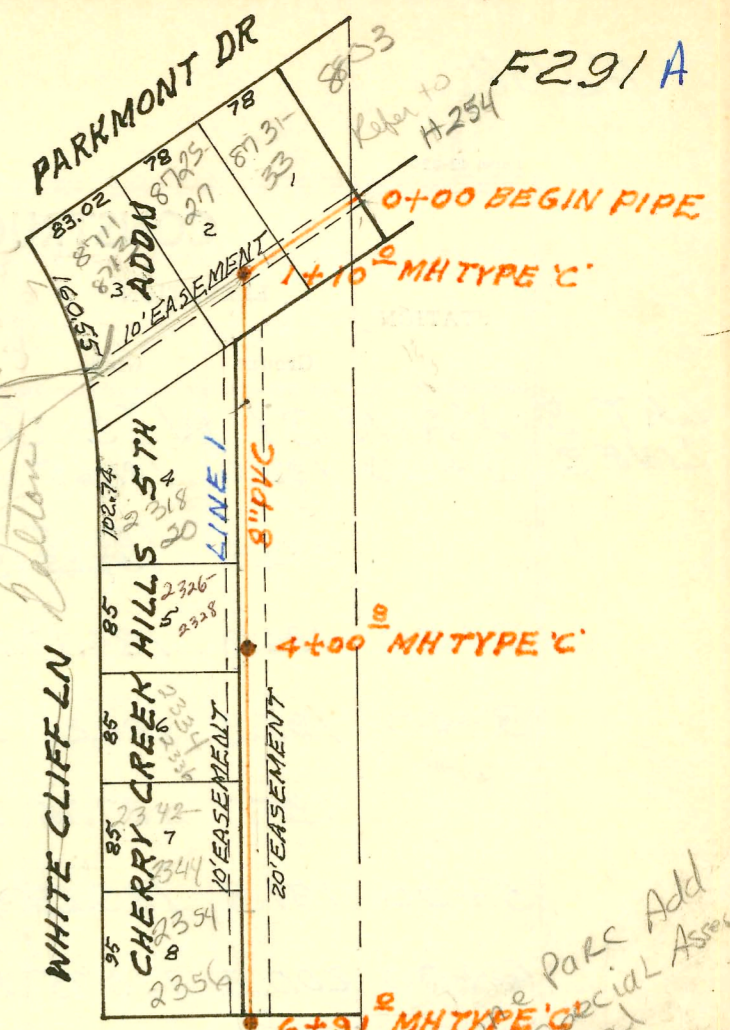

8301 E.
 OAK Knoll
 King Louie
 Enterprises
 INC

Free of 2,165
 Pl 6-3-93
 Receipt
 # 930017X
 OR

Flat Rate
 \$1925
 Main
 200

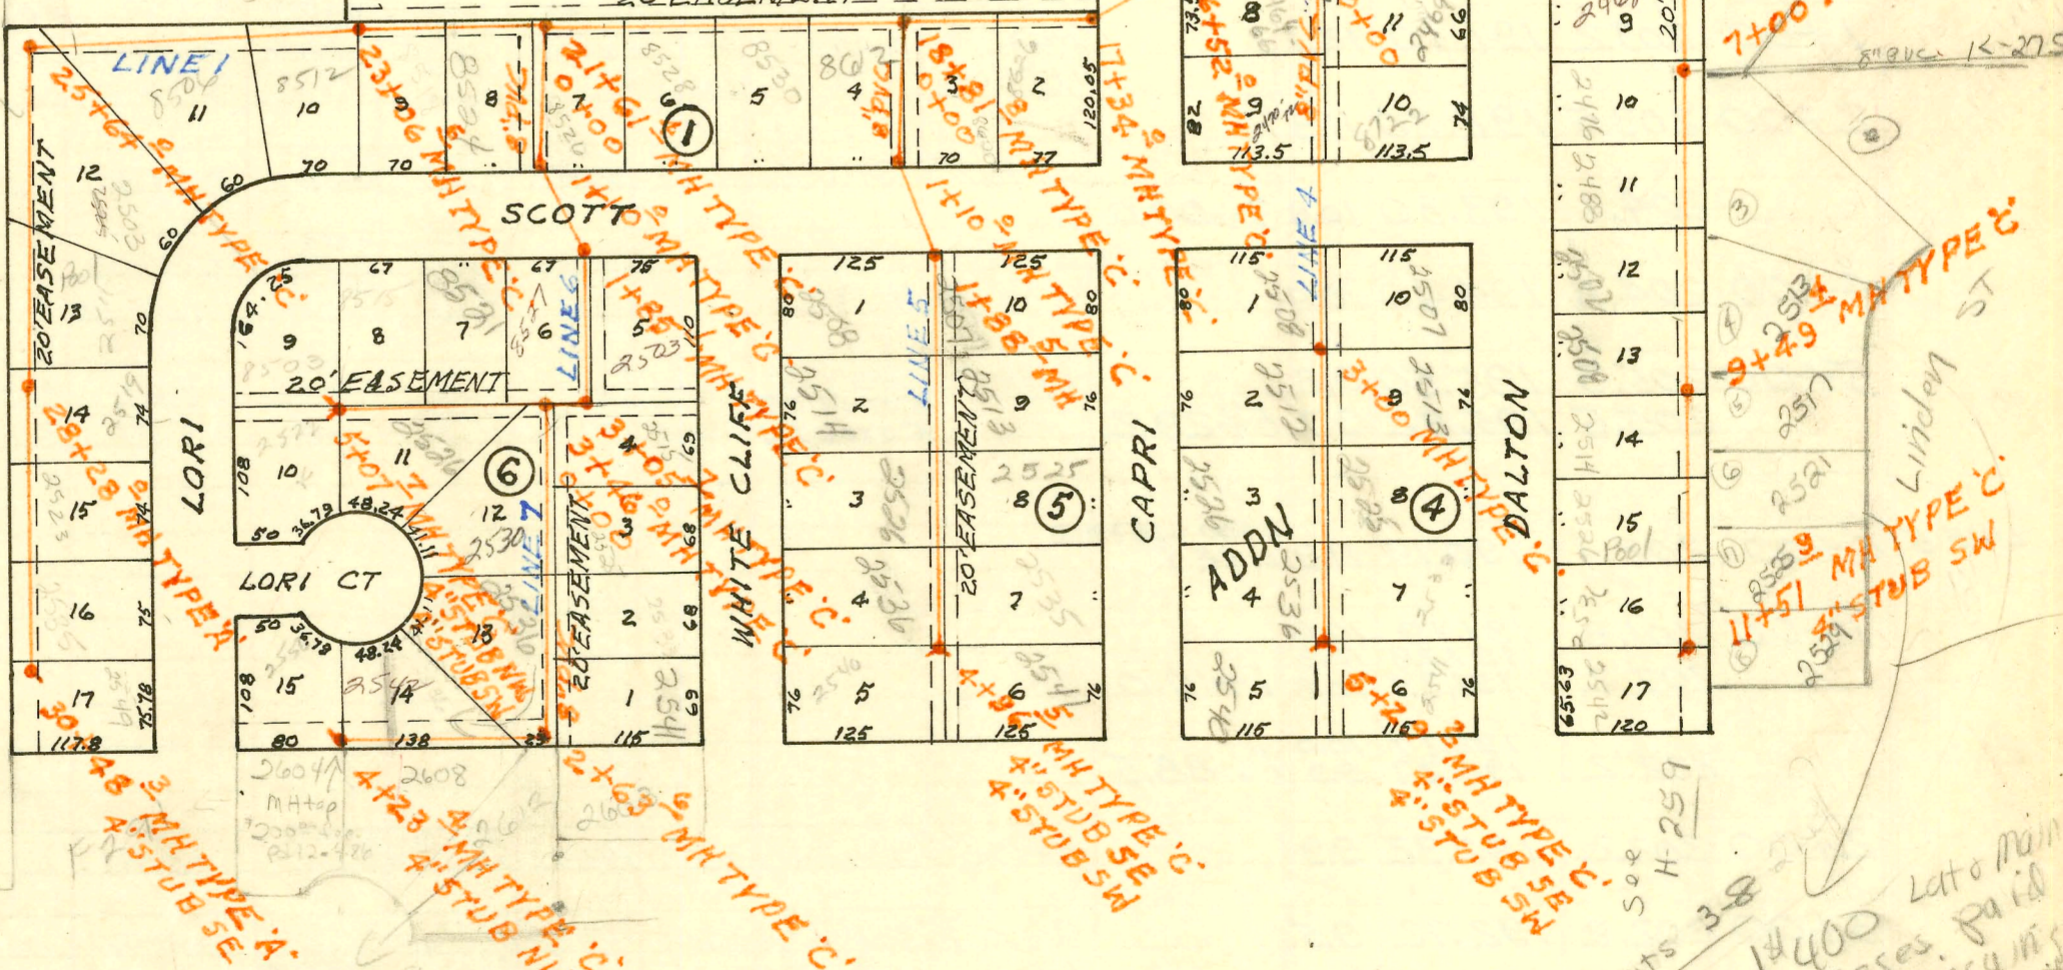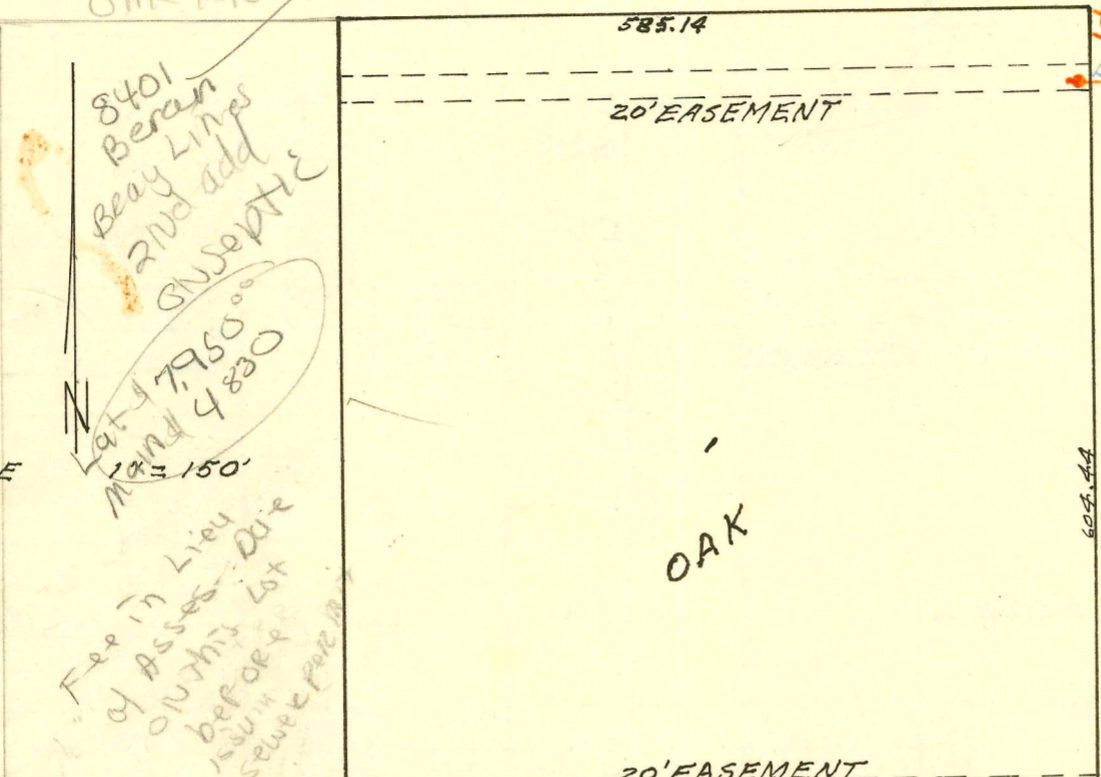

Need \$400 Loto Main
 Sewer Asses. Paid
 PRIOR TO ISSUING
 SEWER PERMITS

1367

CONSTRUCTION RECORD

SERVICE RECORD

LAT 9 MAIN 21 WIS (CONT'D)
LINE 1
CONT'D

| STATION | ELEVATION | | Depth | MANHOLE | 4-INCH "Y" BRANCHES | | No. of Permit | | House Number | | DATE OF PERMITS | |
|---------|-----------|--------|-------|---------|---------------------|-------------|---------------|------------|----------------------|----------------|-----------------|------------|
| | Ground | Grade | | | North West | South East | North West | South East | North West | South East | North West | South East |
| 4+00 | 182.1 | 173.54 | 8.6 | 4+00.8 | 4+41.8 TAP | | 13483 | | 2326 Dalton | | 4-16-85 | |
| 5+00 | 182.6 | 174.24 | 8.4 | | 4+65.3 TAP | | 16589 | | 2327 Dalton | | 7-10-86 | |
| 6+00 | 183.8 | 174.94 | 8.9 | | 4+66.8 TAP | | 16590 | | 2328 Dalton | | 7-10-86 | |
| 6+00 | 185.8 | 175.58 | 10.2 | 6+91.0 | 5+126.8 TAP | | 17511 | | 2342 S. Dalton | | 12-22-86 | |
| 6+00 | 185.8 | 179.48 | 6.3 | | 5+46.8 TAP | | 17512 | | 2344 S. Dalton | | 12-22-86 | |
| 7+00 | 186.1 | 179.52 | 6.6 | | 6+07 TAP | | 18021 | | 2354 S. Dalton | | 3-31-87 | |
| 7+00 | 186.1 | 179.52 | 6.6 | | 6+55.0 TAP | | 18022 | | 2356 S. Dalton | | 3-31-87 | |
| 8+00 | 188.6 | 179.92 | 8.7 | | | | | | | | | |
| 8+00 | 192.0 | 180.11 | 11.9 | 8+46.9 | | | | | | | | |
| 8+00 | 192.0 | 180.21 | 11.8 | | | | | | | | | |
| 9+00 | 192.8 | 180.42 | 12.4 | | | | | | | | | |
| 10+00 | 195.0 | 180.82 | 14.2 | | | | | | | | | |
| 10+00 | 197.3 | 180.96 | 16.5 | 10+34.2 | 10+68.2 TAP | 10+64.2 TAP | 8393 | 11229 | 2406 Capri Dalton | 2409 S Dalton | 6-2-83 | 6-20-84 |
| 10+00 | 197.3 | 185.55 | 11.8 | | 10+69.7 TAP | | 8319 | | 2408 Capri Dalton | | 6-9-83 | |
| 11+00 | 196.7 | 185.81 | 10.9 | | 11+38.2 TAP | 11+35.2 TAP | 6324 | 5536 | 2414 S. Capri Dalton | 2419 Dalton | 8-11-82 | 4-2-82 |
| 11+00 | 196.7 | 185.81 | 10.9 | | 11+40.2 TAP | | 6364 | | 2416 Capri Dalton | | 8-17-82 | |
| 12+00 | 197.6 | 186.21 | 11.4 | | 12+29.0 TAP | 12+08.7 TAP | 3344 | 91-27392-7 | 2422 S. Capri Dalton | 2427 S. Dalton | 8-7-81 | 11-14-91 |
| 12+00 | 197.6 | 186.21 | 11.4 | | 12+85.4 TAP | | 26660 | | 2426 S. Capri Dalton | | 7-13-81 | |
| 13+00 | 198.7 | 186.61 | 12.1 | | 12+45.2 TAP | | | 92-15427-7 | 2435 Dalton | | | 7-23-92 |
| 13+00 | 199.4 | 186.75 | 12.7 | 13+36.0 | | | | 3921 | 2441 Dalton | | | 8-17-81 |
| 13+00 | 199.4 | 186.75 | 12.7 | | 13+62.8 TAP | 13+94.7 TAP | 5161 | 94-2455-7 | 2446 Capri Dalton | 2449 Dalton | 2-2-82 | 2-20-94 |
| 14+00 | 200.6 | 187.01 | 13.6 | | 14+52.0 TAP | 14+49.7 TAP | 6250 | 94-2453-7 | 2450-52 CHPR Dalton | 2455 Dalton | 7-27-82 | 2-20-94 |
| 15+00 | 201.7 | 187.41 | 14.3 | | | | | | | | | |
| 15+00 | 202.2 | 187.50 | 14.6 | 15+48.7 | | | | | | | | |
| 15+00 | 202.2 | 187.70 | 14.5 | | | | | | | | | |
| 16+00 | 202.6 | 187.91 | 14.7 | | | | | | | | | |
| 16+00 | 202.6 | 188.12 | 14.5 | 16+52.0 | | | | | | | | |
| 16+00 | 202.6 | 188.22 | 14.4 | | | | | | | | | |
| 17+00 | 203.0 | 188.41 | 14.6 | | | | | | | | | |
| 17+00 | 202.6 | 188.55 | 14.1 | 17+34.0 | | | | | | | | |
| 17+00 | 202.6 | 188.65 | 14.0 | | | | | | | | | |
| 18+00 | 202.5 | 188.91 | 13.6 | | | | | | | | | |
| 18+00 | 202.1 | 189.24 | 12.9 | 18+81.8 | | | | | | | | |
| 18+00 | 202.1 | 189.24 | 12.9 | | | | | | | | | |
| 19+00 | 202.1 | 189.31 | 12.8 | | | | | | | | | |
| 20+00 | 201.7 | 189.71 | 12.0 | | | | | | | | | |
| 20+00 | 201.7 | 189.71 | 12.0 | | | | | | | | | |
| 21+00 | 201.7 | 190.11 | 11.6 | | | | | | | | | |
| 21+00 | 201.6 | 190.36 | 11.2 | 21+61.4 | | | | | | | | |
| 21+00 | 201.6 | 190.36 | 11.2 | | | | | | | | | |
| 22+00 | 201.7 | 190.51 | 11.2 | | | | | | | | | |
| 23+00 | 201.5 | 190.91 | 10.6 | | | | | | | | | |
| 23+00 | 201.5 | 190.94 | 10.6 | 23+06.6 | | | | | | | | |
| 23+00 | 201.5 | 190.94 | 10.6 | | | | | | | | | |
| 24+00 | 201.7 | 191.31 | 10.4 | | | | | | | | | |
| 25+00 | 201.6 | 191.71 | 9.9 | | | | | | | | | |
| 25+00 | 200.2 | 191.97 | 8.2 | 25+64.0 | | | | | | | | |
| 25+00 | 200.2 | 192.07 | 8.1 | | | | | | | | | |
| 26+00 | 201.2 | 192.21 | 9.0 | | | | | | | | | |
| 26+00 | 201.2 | 192.21 | 9.0 | | | | | | | | | |
| 27+00 | 200.7 | 192.61 | 8.1 | | | | | | | | | |
| 28+00 | 199.2 | 193.01 | 6.2 | | | | | | | | | |
| 28+00 | 199.2 | 193.12 | 6.1 | 28+28.0 | | | | | | | | |
| 28+00 | 199.2 | 193.12 | 6.1 | | | | | | | | | |
| 29+00 | 198.3 | 193.41 | 4.9 | | | | | | | | | |
| 30+00 | 197.6 | 193.81 | 3.8 | | | | | | | | | |
| 30+00 | 197.2 | 194.00 | 3.2 | 30+48.3 | | | | | | | | |
| 30+00 | 197.2 | 194.00 | 3.2 | | | | | | | | | |

Redd's Frnd
TV d Lifer on
10/10/66 x
veel. Fred
As sch
40
PR

CONT'D NEXT PAGE