

Need outside City  
Appl.  
\$500  
(\$500.00)

SCALE 1" = 400'

MAIN 22 WAR INDUSTRIES SEWER  
 BUILT BY: W.B. CARTER CONST. CO.  
 PROJ. NO 468-76-245-80509-000-000-001  
 PHASE II

LATERAL 12 MAIN 22 WAR INDUSTRIES SEWER  
 BUILT BY: CLEARWATER EXCAV. CO.  
 PROJ. NO 468-76-245-81006-000-000-001  
 BOOKED 5-2-81 FROM CG 22  
 (PAGE F300 FOR DATA)

CONSTRUCTION RECORD

SERVICE RECORD


MAIN 22 WIS (CONT'D)  
LINE 2B CONT'D

STATION	ELEVATION		Depth	MANHOLE	4-INCH "Y" BRANCHES		No. of Permit		House Number		DATE OF PERMITS		
	Ground	Grade			North West	South East	North West	South East	North West	South East	North West	South East	
14+00	193.5	181.91	11.6										
	193.5	182.03	11.5	14+40.3									
15+00	193.5	182.21	11.3										
16+00	193.3	182.51	10.8										
17+00	192.8	182.81	10.0										
18+00	192.5	183.11	9.4	18+00.4	8" STUB W								
19+00	192.5	183.41	9.1										
20+00	192.3	183.71	8.6										
21+00	192.7	184.01	8.7										
	192.6	184.19	8.4	21+60.7	8" STUB W								
22+00	193.5	184.31	9.2		30" X 20" STEEL CASING								
	193.5	184.31	9.2	22+01.1									
23+00	194.6	184.61	10.0										
24+00	196.4	184.91	11.5										
25+00	199.1	185.21	13.9										
	200.0	185.33	14.7	25+38.8									
26+00	201.8	185.51	16.3										
	201.8	185.66	16.1	26+46.9									
27+00	202.3	185.81	16.5										
	202.5	185.95	16.5	27+46.5									
28+00	200.9	186.21	14.7										
29+00	200.1	186.51	13.6					10073	1821		1-30-84		
				28+85.5 4" Sch 40 P.C. 29+17.2				93-29544-7	1831	Rock Rd CT		11-19-93	
30+00	199.6	186.81	12.8										
31+00	199.1	187.11	12.0										
	200.0	187.34	12.7	31+79.2									
LINE 3 0+00	193.8	184.00	9.8	0+00 = 98+64.9 LINE 1	0+56.9 0+77.0 1+36.6 1+93.2 2+41.6 2+81.7 3+82.3			6685	8577 Pappertree		10-5-82		
1+00	195.5	185.40	10.1					6686	8511 Pappertree		10-5-82		
2+00	196.2	186.80	9.4					6681	8505 Pappertree		10-5-82		
	197.2	187.63	9.6	2+59.2				6682	8427 Pappertree		10-5-82		
3+00	197.6	188.20	9.4					7012	8421 Pappertree		11-17-82		
4+00	198.6	189.60	9.0					7011	8417 Pappertree		11-17-82		
5+00	200.4	191.00	9.4					7380	8411 Pappertree		1-17-83		
	201.2	191.28	9.9	5+19.8									
6+00	202.7	192.08	10.6										
7+00	204.1	193.08	11.0					96112609	8310 E 21st (RIS BLAVO)		7-22-96		
	205.2	193.88	11.3	7+79.9									
8+00	205.2	194.14	11.1										
9+00	205.8	194.78	11.0										
10+00	206.4	195.42	11.0										
	207.2	195.71	11.5	10+45.5									
11+00	207.7	196.06	11.6		11+56.3			12531	8211 Pappertree		11-9-84		

RD permit  
10-5-82  
10-5-82  
10-5-82  
11-17-82  
11-17-82  
1-17-83

No fee per City Eng.

CONT'D NEXT PAGE

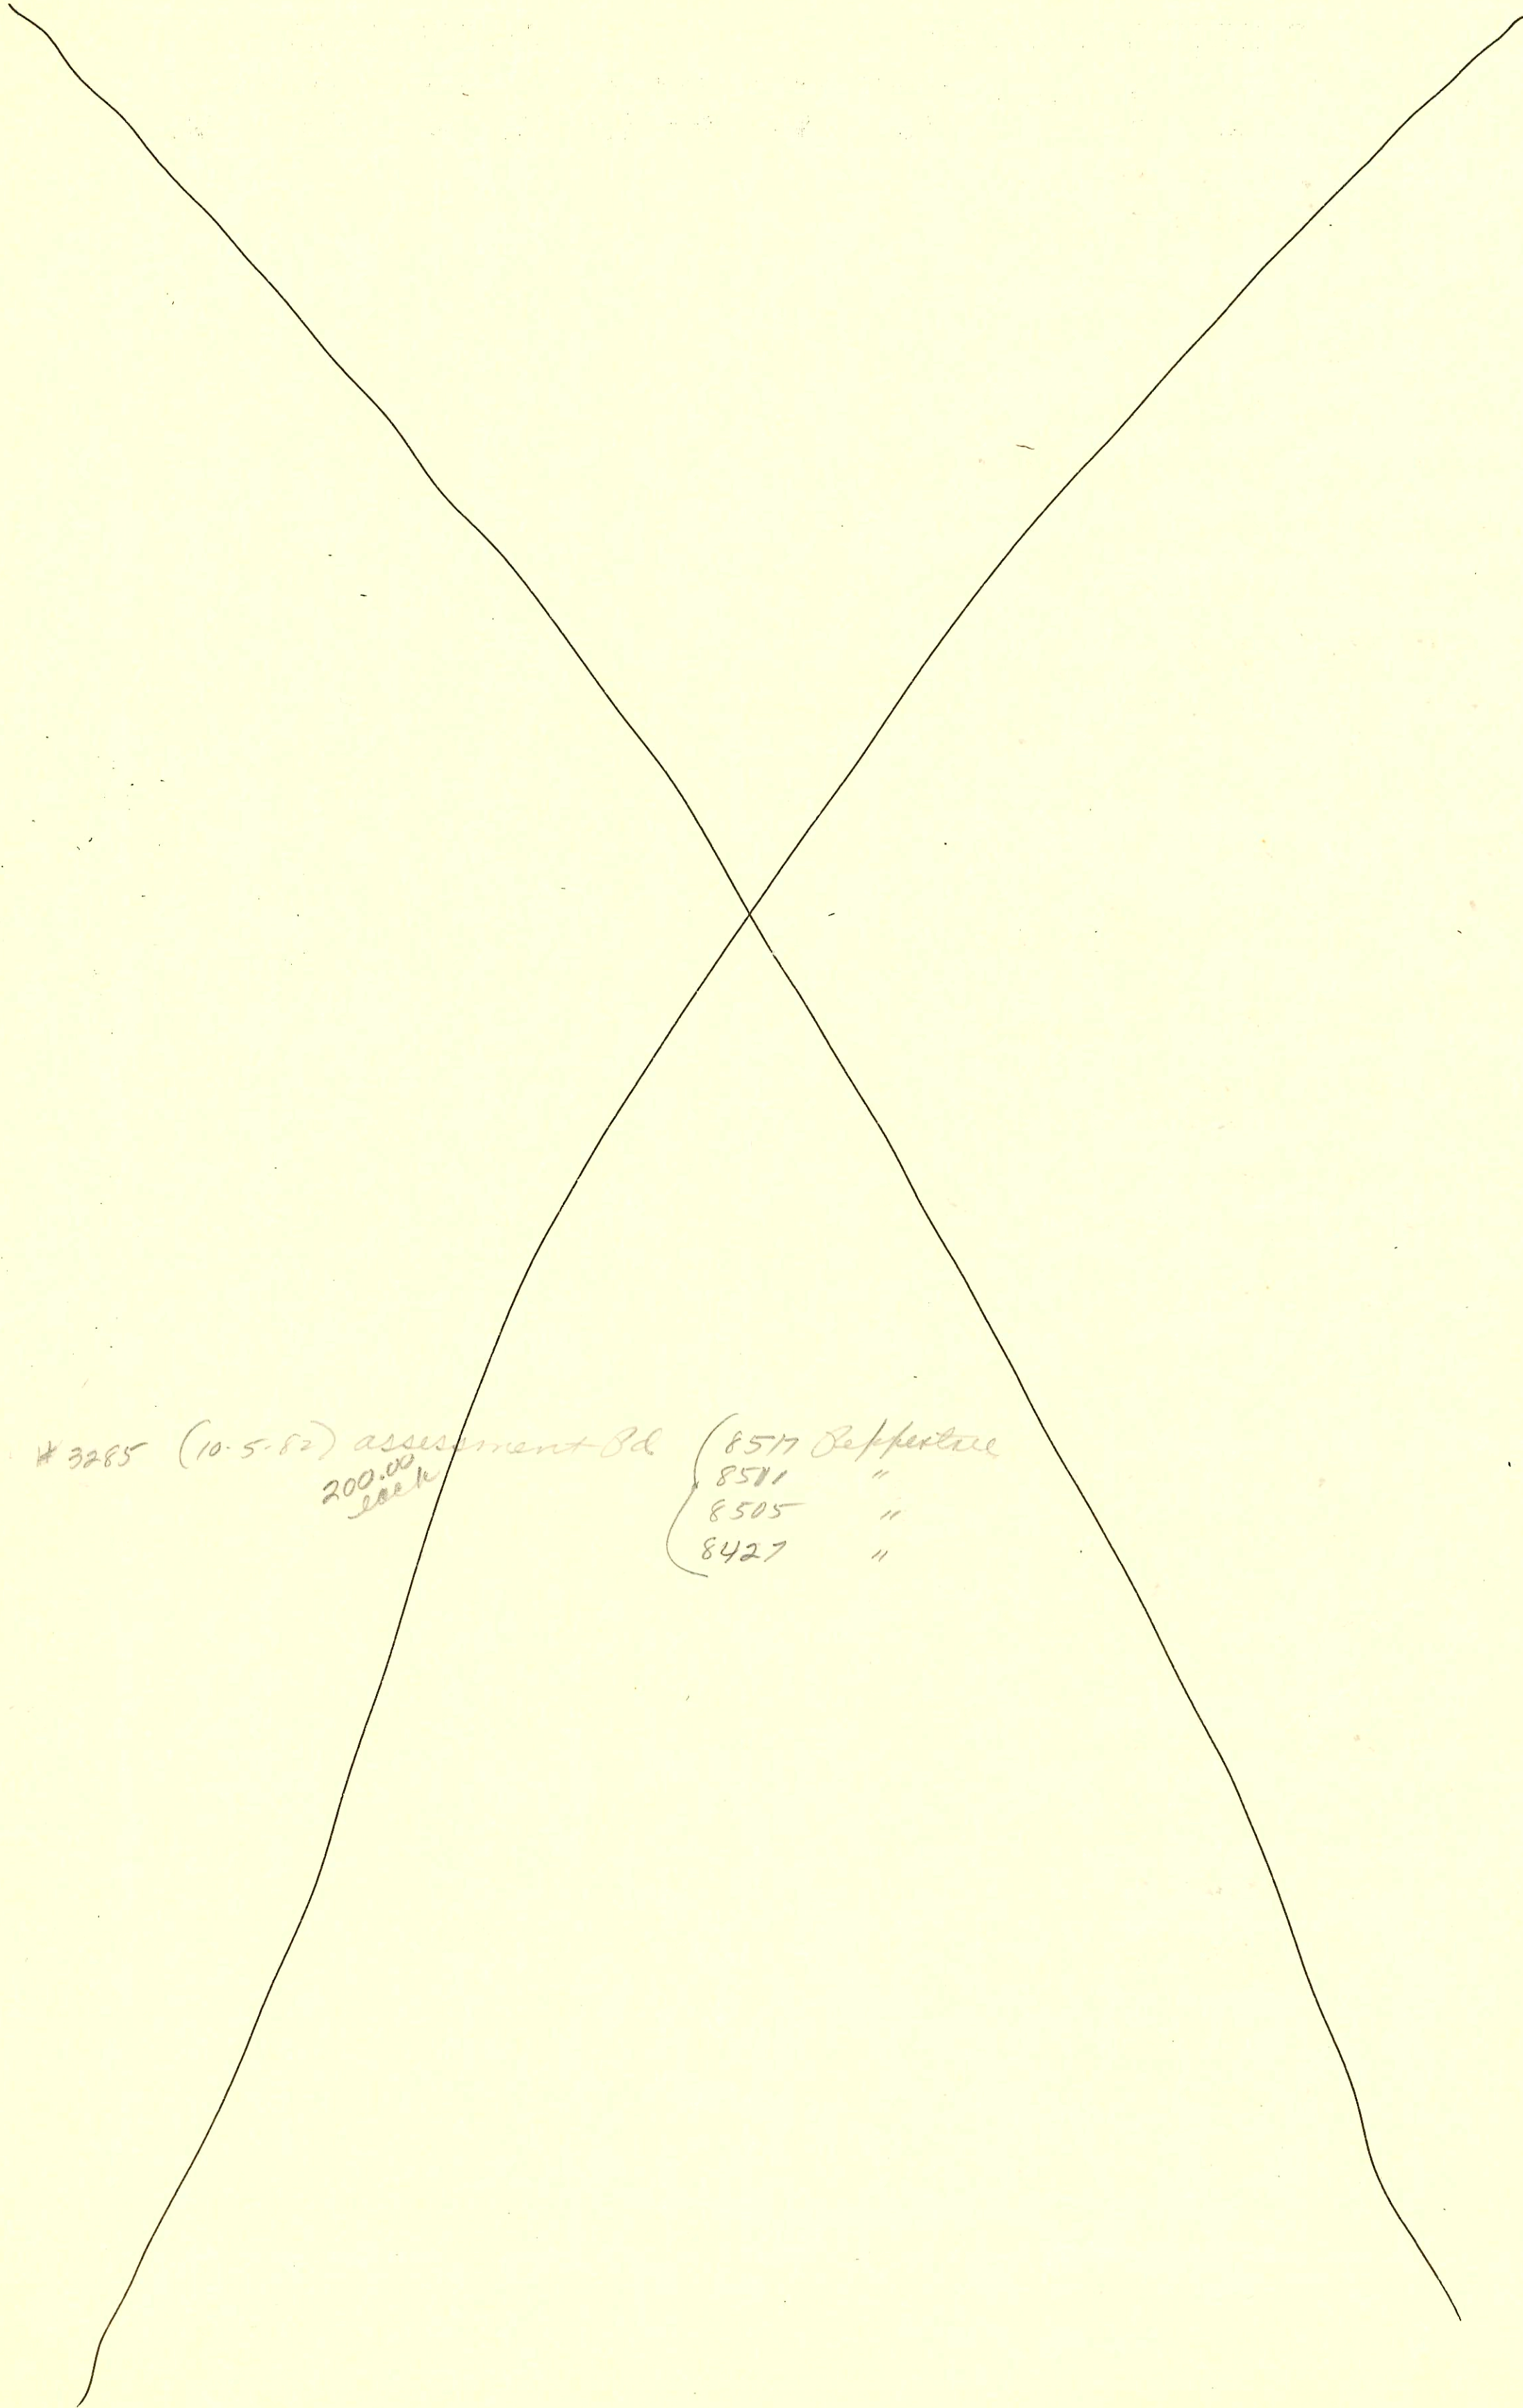

#3285 (10-5-82) assessment Bd { 8517 Pefferline  
200.00 " 8511 "  
each " 8505 "  
8427 "