




SCALE 1"=100'

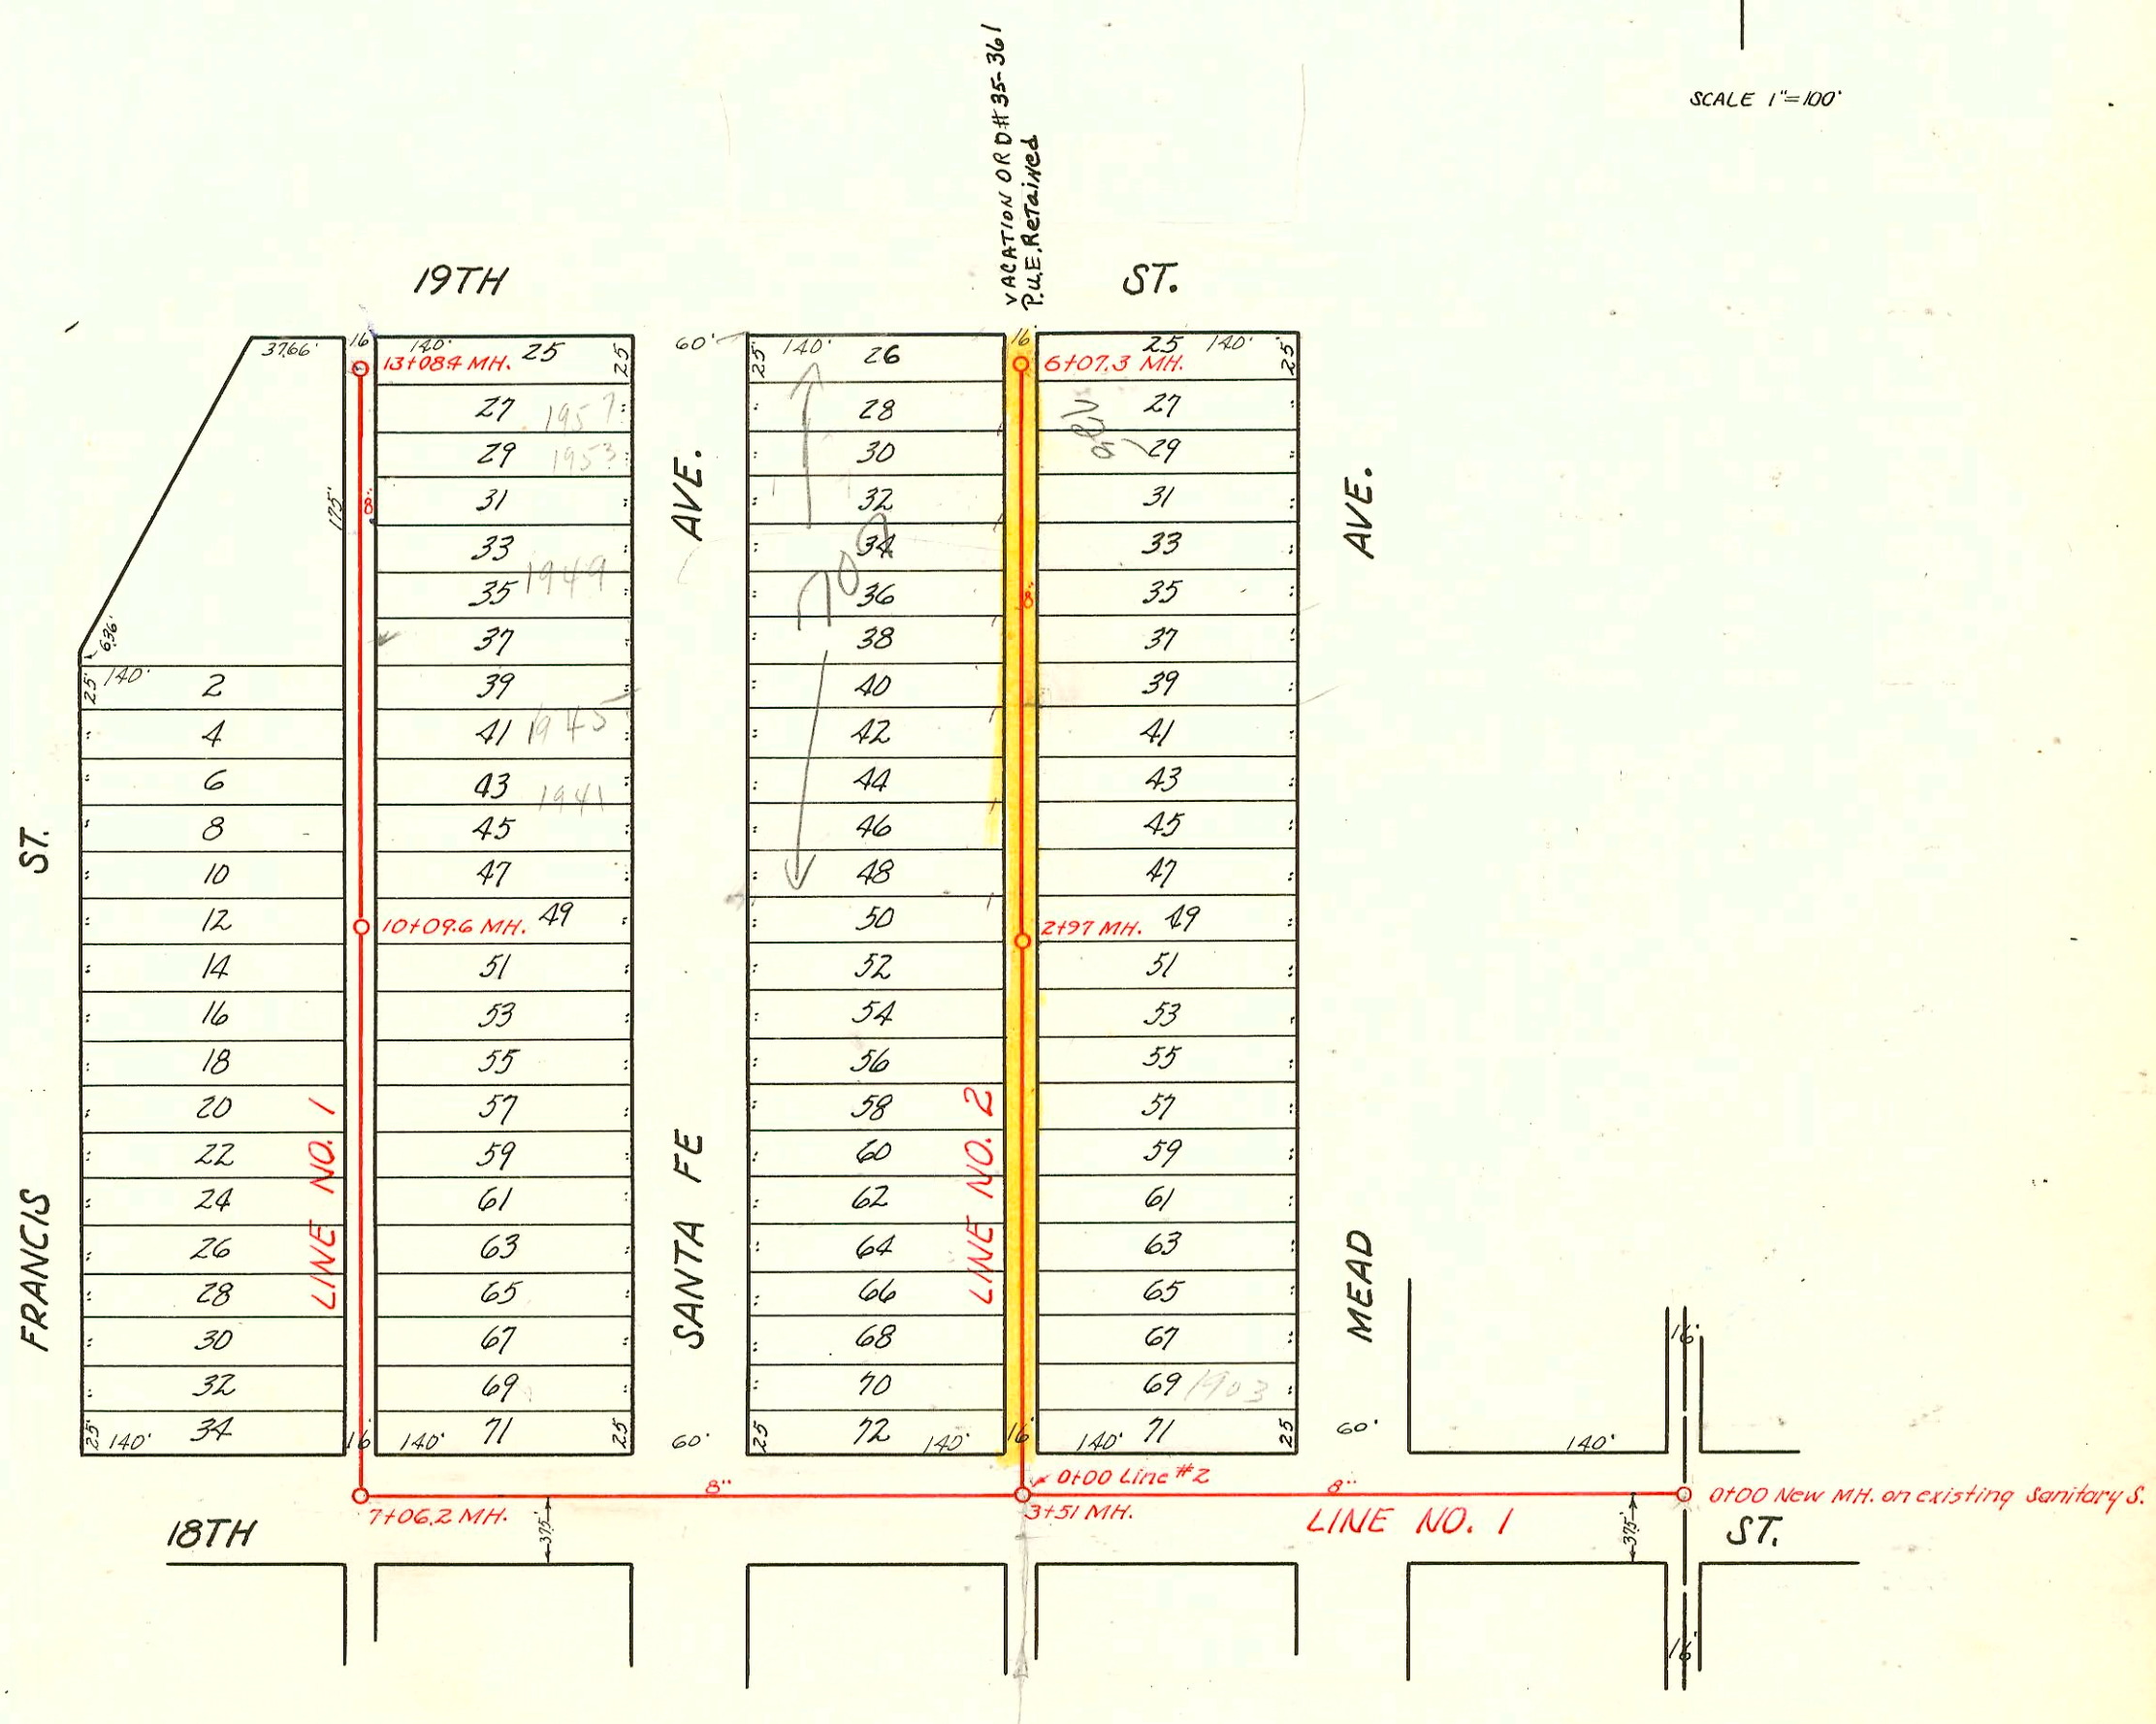

N/C 2115 725 E. 19th for Mead for 12-15-80

LAT. T, DIST. T, S.S. #20
W. B. CARTER ~ CONT.
BK. NO. 57 JF, DEC. 5, 1951
PROJ. # C21-50

CONSTRUCTION RECORD

SERVICE RECORD

LAT. T. DIST. T. S. S. #20
Line #1

Line #2

| STATION | ELEVATION | | Depth | MANHOLE | 4-INCH "Y" BRANCHES | | No. of Permit | | House Number | | DATE OF PERMITS | |
|---------|-----------|-------------------------|------------|---------------------------|---------------------|------------|---------------|------------|--------------|---------------------|-----------------|------------|
| | Ground | Grade | | | North West | South East | North West | South East | North West | South East | North West | South East |
| | | | | | | | | | | | | |
| 0+00 | 118.9 | 110.97 | 7.9 | 0+00 | | | | | | | | |
| 1+00 | 119.1 | 111.07 | 8.0 | | | | | | | | | |
| 2+00 | 120.3 | 111.17 | 9.1 | | | | | | | | | |
| 3+00 | 119.2 | 111.27 | 7.9 | | | | | | | | | |
| 3+51 | 119.0 | 111.32 | 7.7 | 3+51 | | | | | | | | |
| 4+00 | 119.0 | 111.37 | 7.6 | | | | | | | | | |
| 5+00 | 119.4 | 111.47 | 7.9 | | | | | | | | | |
| 6+00 | 118.6 | 111.57 | 7.0 | | | | | | | | | |
| 7+00 | 119.0 | 111.67 | 7.3 | | | | | | | | | |
| 7+06.2 | 119.2 | 111.68 in 111.78 out | 7.5 7.4 | 7+06.2 | 7+37.3 | 7+34.3 | | | | | | |
| | | | | | +55.0 | +52.0 | | | | | | |
| | | | | | +90.1 | +87.1 | | | #5397 | 1701 N. Santa Fe | | 6-28-58 |
| 8+00 | 118.7 | 111.87 | 6.8 | | 8+14.2 | 8+11.2 | | | | | | |
| | | | | | +38.4 | +35.4 | | | | | | |
| | | | | | +63.6 | +60.6 | | | | | | |
| | | | | | +88.5 | +85.5 | | | | | | |
| 9+00 | 118.4 | 111.97 | 6.4 | | 9+15.0 | 9+12.0 | | | | | | |
| | | | | | +40.5 | +37.5 | | | | | | |
| | | | | | +64.3 | +61.3 | | | | | | |
| | | | | | +89.3 | +86.3 | | | | | | |
| 10+00 | 118.5 | 112.07 | 6.4 | | | | | | | | | |
| 10+09.6 | 118.4 | 112.08 | 6.3 | 10+09.6 | 10+22.3 | 10+19.3 | | | | | | |
| | | | | | +37.6 | +34.6 | | | | | | |
| | | | | | +62.0 | +59.0 | | | | | | |
| | | | | | +86.3 | +83.3 | | | | | | |
| 11+00 | 118.6 | 112.17 | 6.4 | | 11+14.2 | 11+11.2 | | | | | | |
| | | | | | +38.2 | +35.2 | | | #327 | 1947 N. Santa Fe | | 3-27-56 |
| | | | | | | | | | | | | |
| | | | | | | | | | | | | |
| 12+00 | 119.2 | 112.27 | 6.9 | | | 12+08.5 | | | | | | |
| | | | | | | +35.5 | | | | | | |
| | | | | | | +59.9 | | | #2724 | 1757 N. Santa Fe | | 10-1-52 |
| | | | | | | +86.7 | | | | | | |
| 13+00 | 118.7 | 112.37 | 6.3 | | | 13+03.0 | | | | | | |
| 13+08.4 | 118.8 | 112.39 | 6.4 | 13+08.4 | | | | | | | | |
| | | | | | | | | | | | | |
| | | | | | | | | | | | | |
| 0+00 | 119.0 | 111.53 | 7.5 | 0+00 = 3+51 in Line #1 | 0+40 | 0+37.0 | | | | | | |
| | | | | | +58.5 | +55.5 | | | | | | |
| | | | | | +81.5 | +78.5 | | | | | | |
| 1+00 | 118.8 | 111.63 | 7.2 | | 1+06.2 | 1+03.2 | | | | | | |
| | | | | | +30.0 | +27.0 | | | | | | |
| | | | | | +58.0 | +55.0 | | | | | | |
| | | | | | +83.0 | +80.0 | | | | | | |
| 2+00 | 118.5 | 111.73 | 6.8 | | 2+06.8 | 2+03.8 | | | | | | |
| | | | | | +34.0 | +31.0 | | | | | | |
| | | | | | +54.8 | +51.8 | | | | | | |
| 2+97 | 118.2 | 111.83 | 6.4 | 2+97 | +82.4 | +79.4 | | | | | | |
| 3+00 | 118.2 | | | | 3+07.0 | 3+04.0 | | | | | | |
| | | | | | +30.5 | +27.5 | | | | | | |
| | | | | | +51.3 | +48.3 | | | | | | |
| | | | | | +83.2 | +80.2 | | | | | | |
| 4+00 | 118.3 | 111.93 | 6.4 | | 4+07.7 | 4+04.7 | | | | | | |
| | | | | | +28.4 | +25.4 | | | | | | |
| | | | | | +53.0 | +50.0 | | | | | | |
| | | | | | +74.0 | +71.0 | | | | | | |
| | | | | | | +98.3 | | | | | | |
| 5+00 | 118.7 | 112.03 | 6.7 | | 5+01.3 | | | | | | | |
| | | | | | +31.9 | 5+28.9 | | | | | | |
| | | | | | +53.7 | +50.7 | | | | | | |
| | | | | | +81.5 | +78.5 | | | | | | |
| | | | | | +73.1 | +70.2 | | | | | | |
| 6+00 | 118.7 | 112.13 | 6.6 | | 6+00.2 | | | | | | | |
| 6+07.3 | 118.6 | 112.14 | 6.5 | 6+07.3 | | | | | | | | |

C 34093 - 731 8-19th - 8-7-72 - Al Henning (5+71.3)
2401 - 1953 N. Santa Fe - 11-2-54. Greenmore

51654 - Jan - 1946 N. Santa Fe - 1-23-55 - Bureau Bldg. Co. - sealed off - C 31905 - 5-1-72 Al Henning (4+67)
24014 - Jan - 1954 N. Santa Fe - 9-6-56 - R. LaJoy, Jr. (LaJoy Bldg.)
24991 - Jan - 1956 N. Santa Fe - 9-21-56 - R. LaJoy, Jr. - sealed off 1956 N. Santa Fe - 1-13-66 (5+69.8)
C 23948 - Jan - 1941 N. Meade - R. LaJoy - 4/26/71 (4+22.3) house in rear - sealed off on permit C 30235 with front house 1-28-72