



1" = 80'

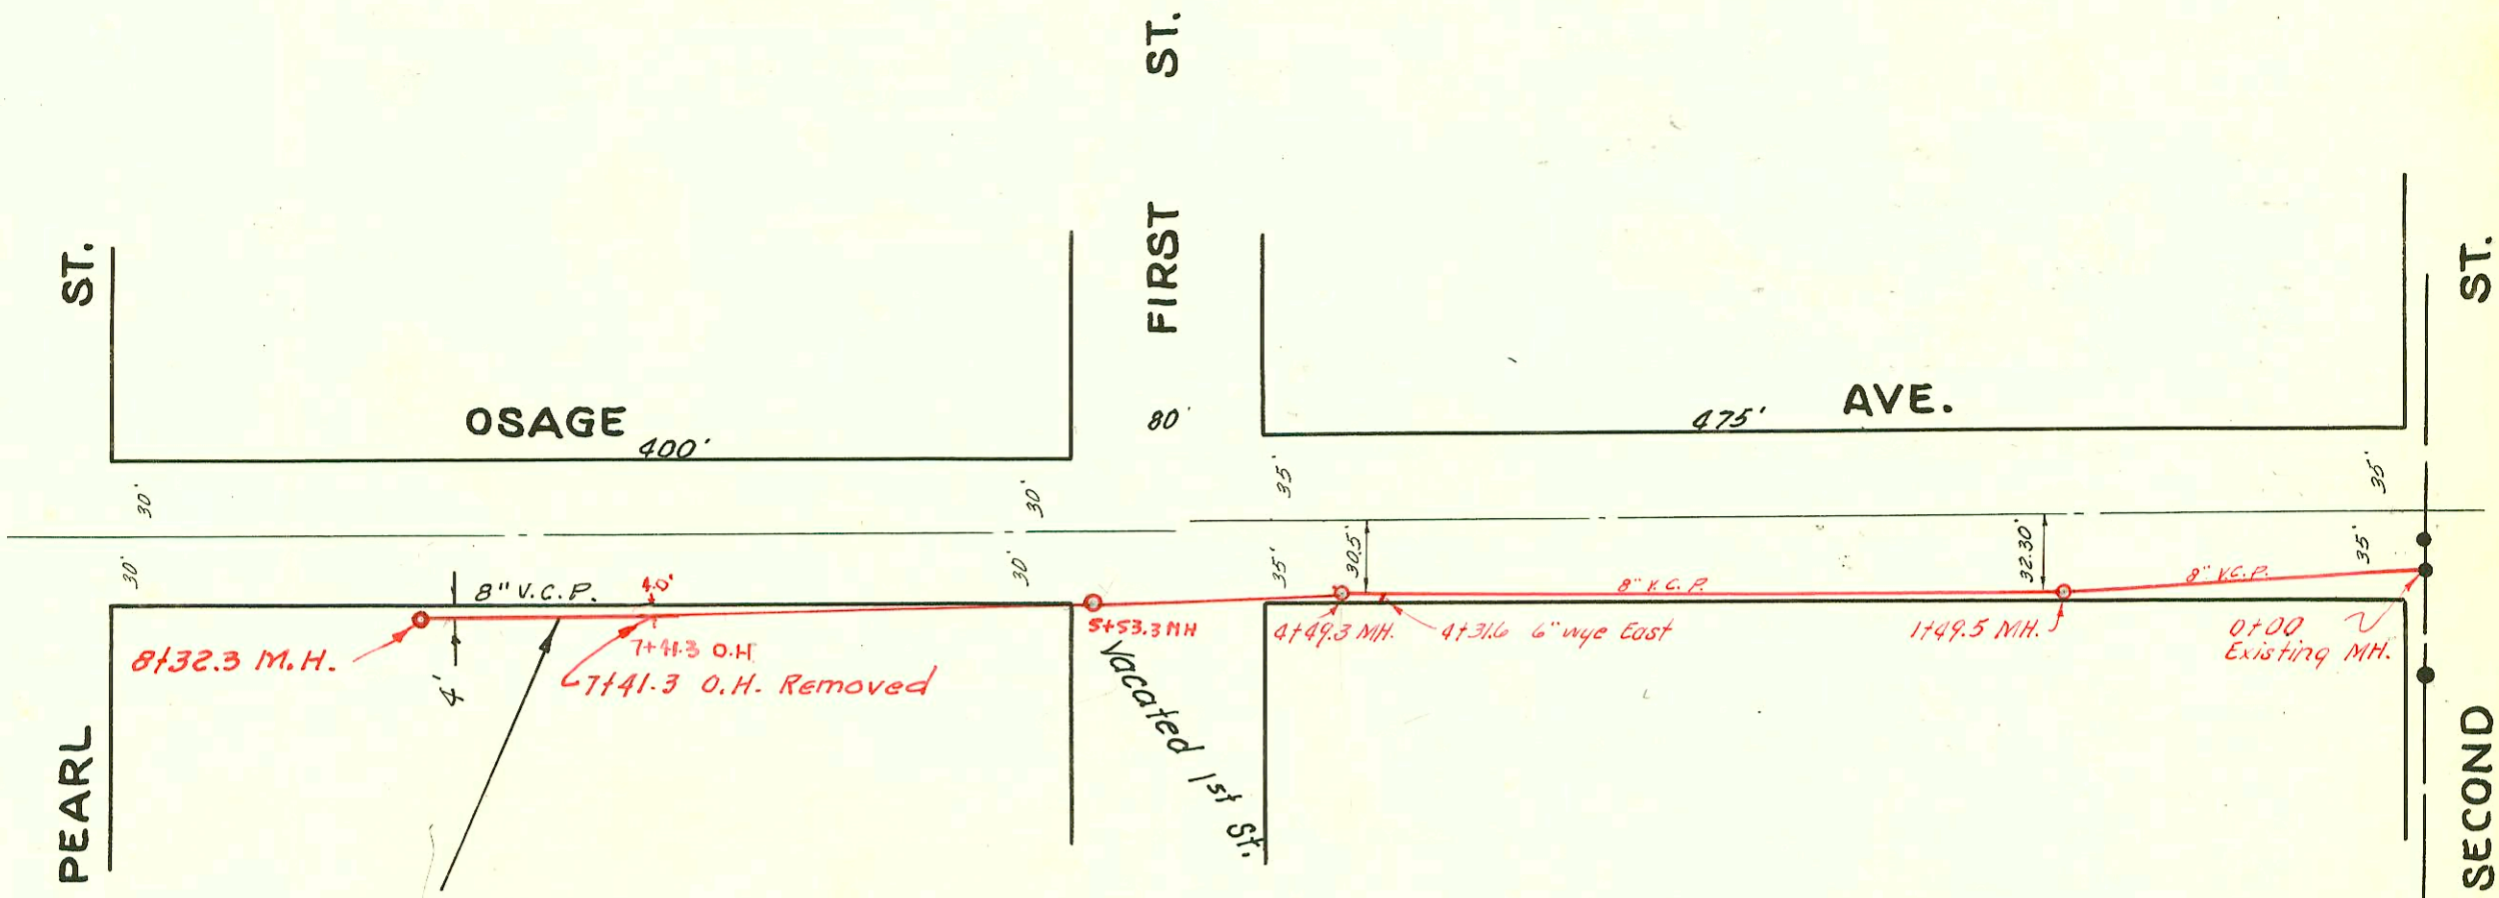

EXTENSION TO
SUB. S. S. DIST. NO. 21
W. B. CARTER CONST. CO. INC.
PRIVATE CONTRACT, BK. # K-71
12-23-65

PRIVATE SANITARY SEWER
LAWRENCE LUMBER COMPANY
W. B. CARTER MAY 7, 1953
BK. JT. 63, BOOKED 5-19-53

G₁

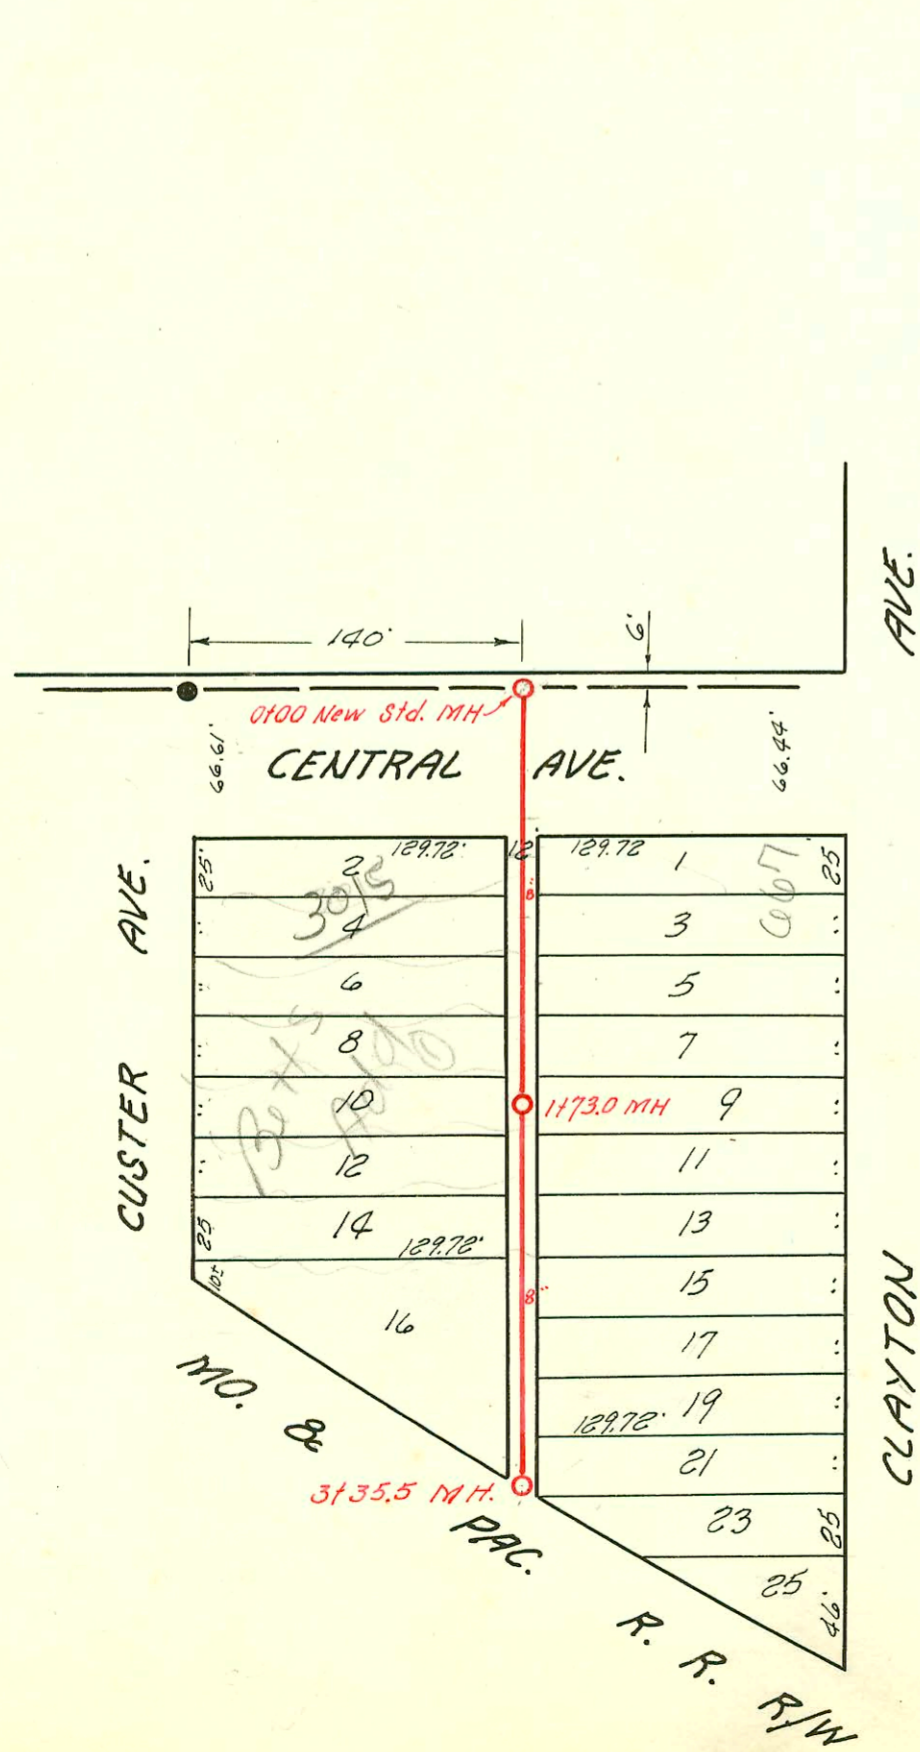

SCALE 1" = 80'

7-51

LAT. 35, DIST. A, S.S. 21
W. B. CARTER MAY 25, 1954
BK. NO. 61 JT, PROJ. NO. C 24-16

