
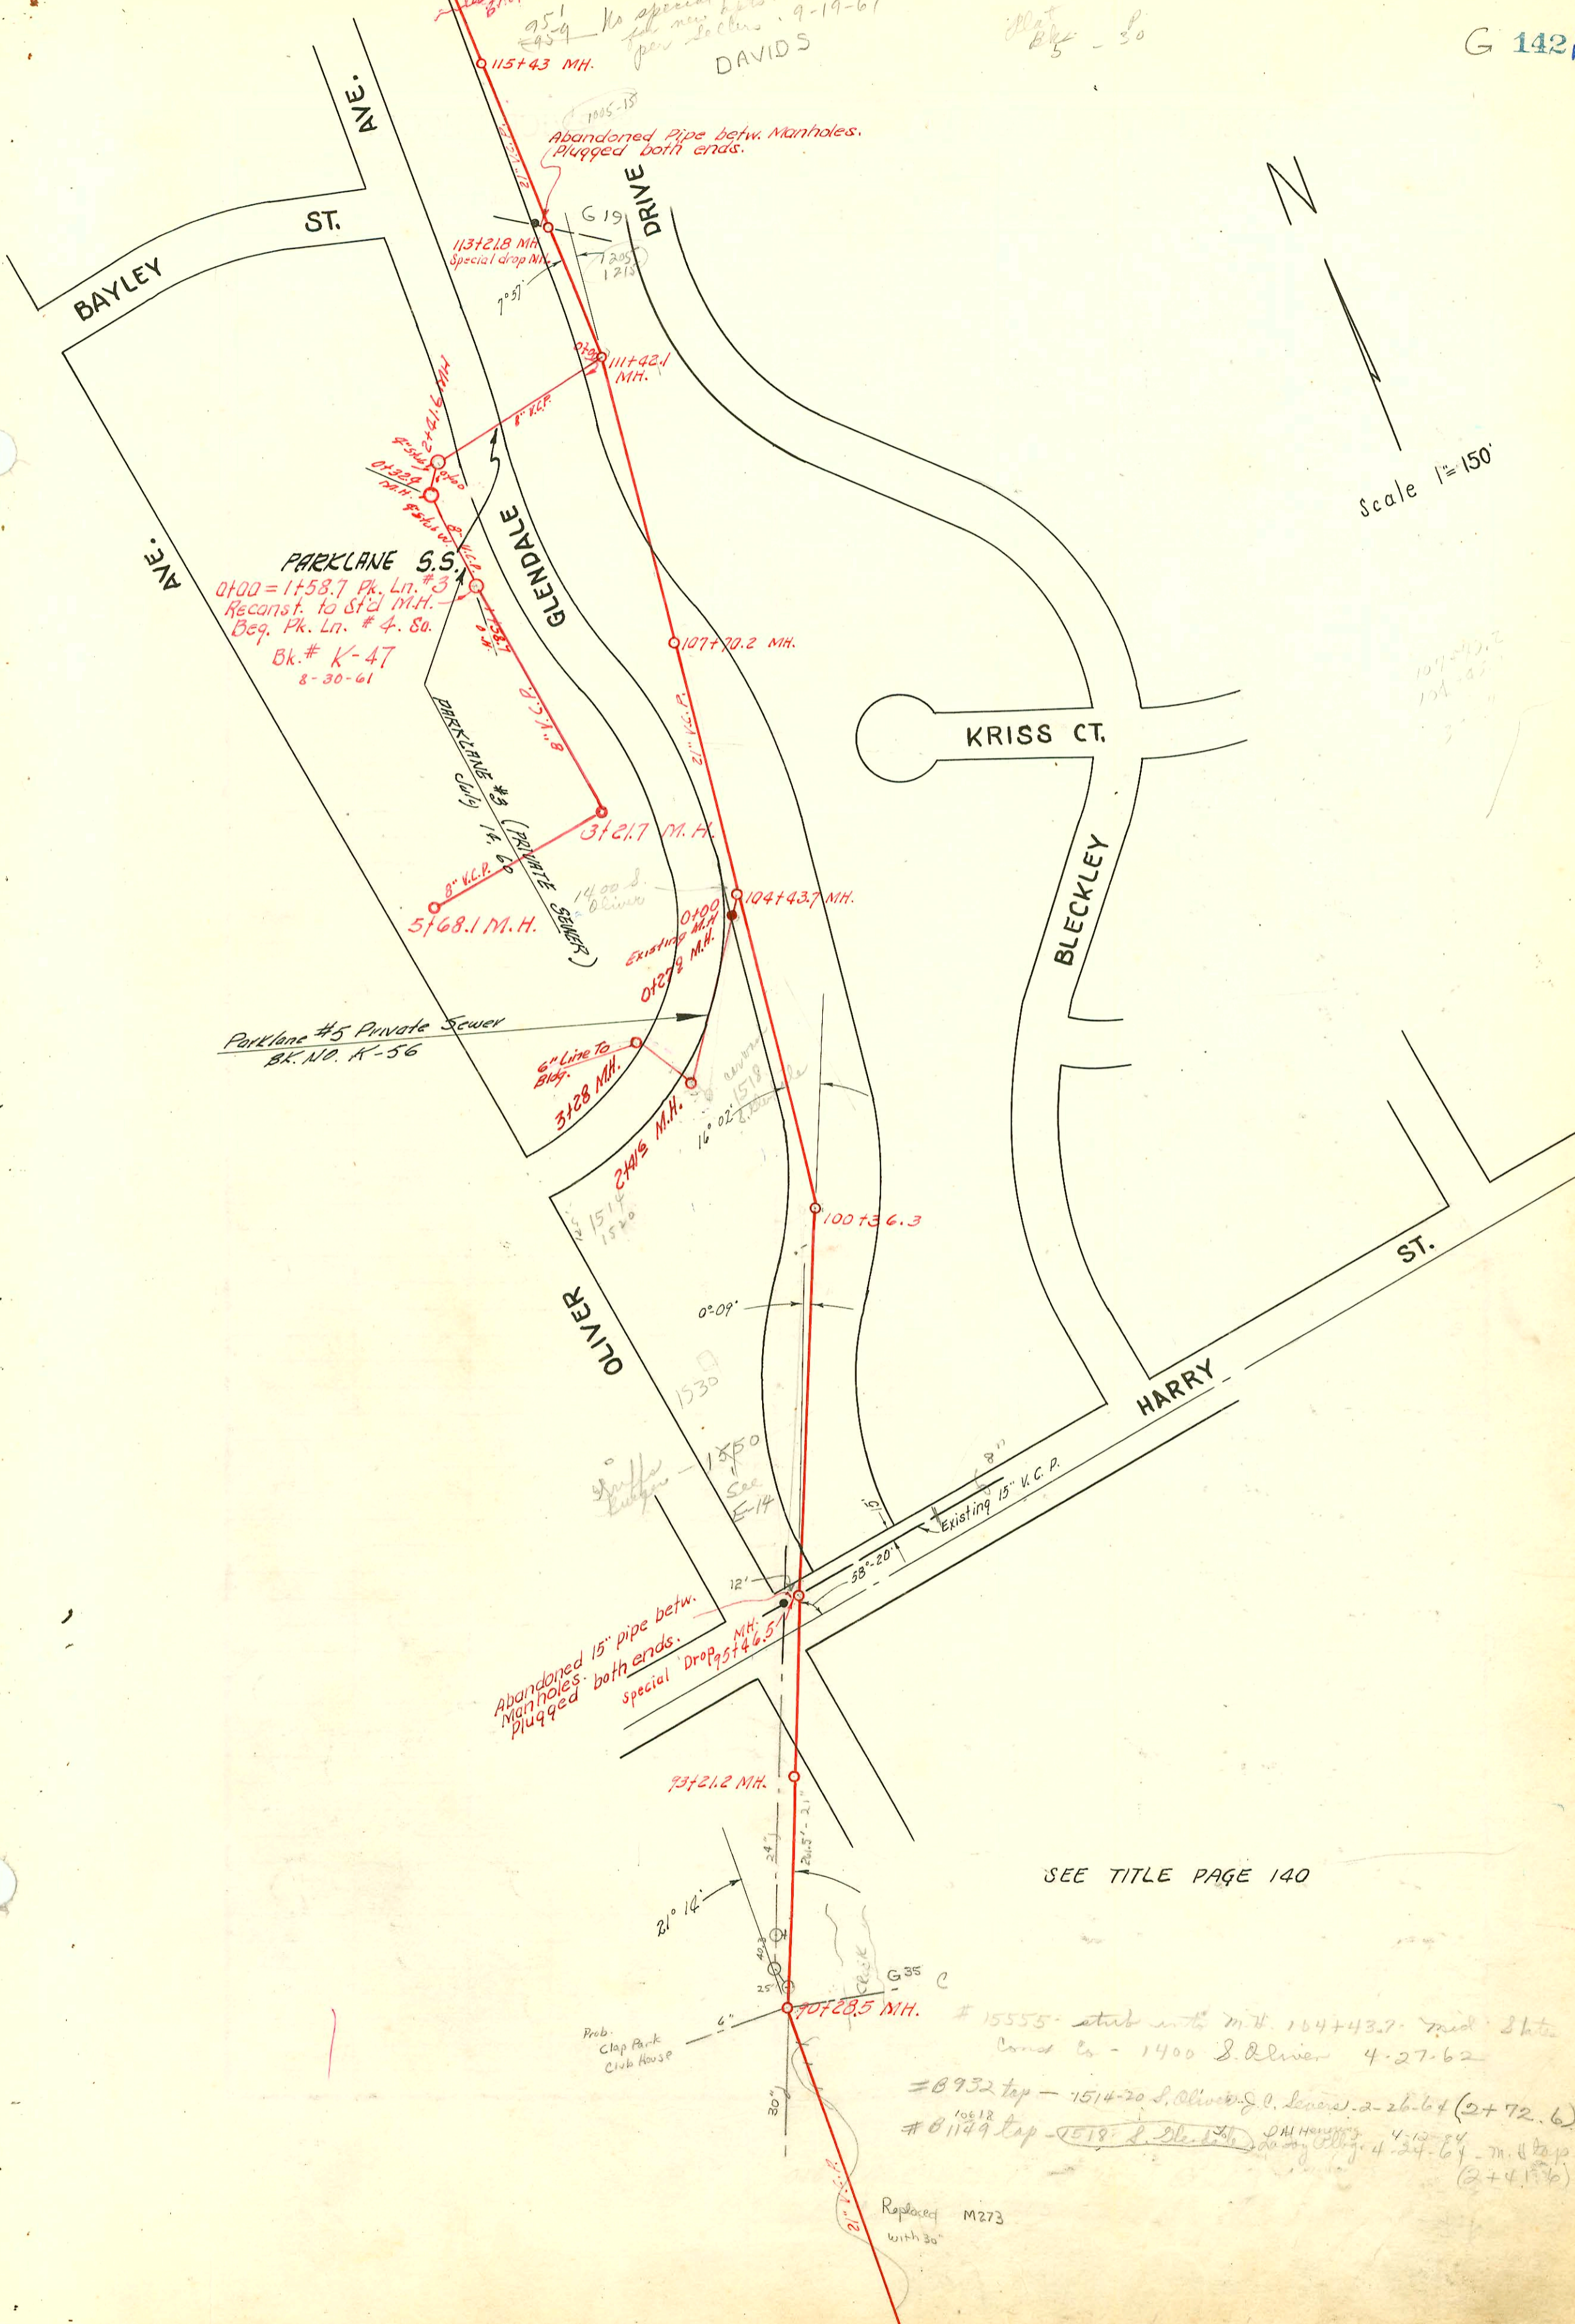


Plot Bk 5 - 30

DAVIDS -19-67

951
959
115+43 MH.
No special fee for new but new sections

1005-15
Abandoned Pipe betw. Manholes. Plugged both ends.

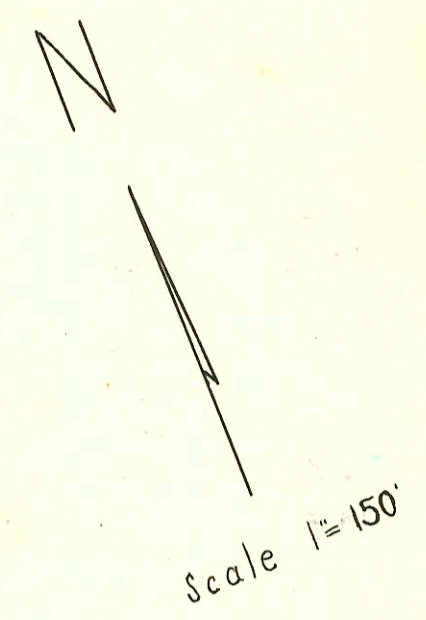

PARKLANE S.S.
0+00 = 1+58.7 Pk. Ln. #3
Reconst. to Std. M.H.
Req. Pk. Ln. # 4. Sa.
Bk. # K-47
8-30-61

Parklane #5 Private Sewer
Bk. No. K-56

1400 S. Oliver
Private Sewer

Abandoned 15" pipe betw. Manholes. Plugged both ends.
Special Drop 95+46.5

SEE TITLE PAGE 140

15555 - stub into m.h. 104+43.7 mid 80s
Cond. Co. - 1400 S. Oliver 4-27-62
8932 tap - 1514-20 S. Oliver S.O. Leaver. 2-26-64 (2+72.6)
81149 tap - 1518 S. Oliver S.O. Leaver. 4-24-64 (2+41.76)

Replaced M273 with 30"

G

1

