


BK G

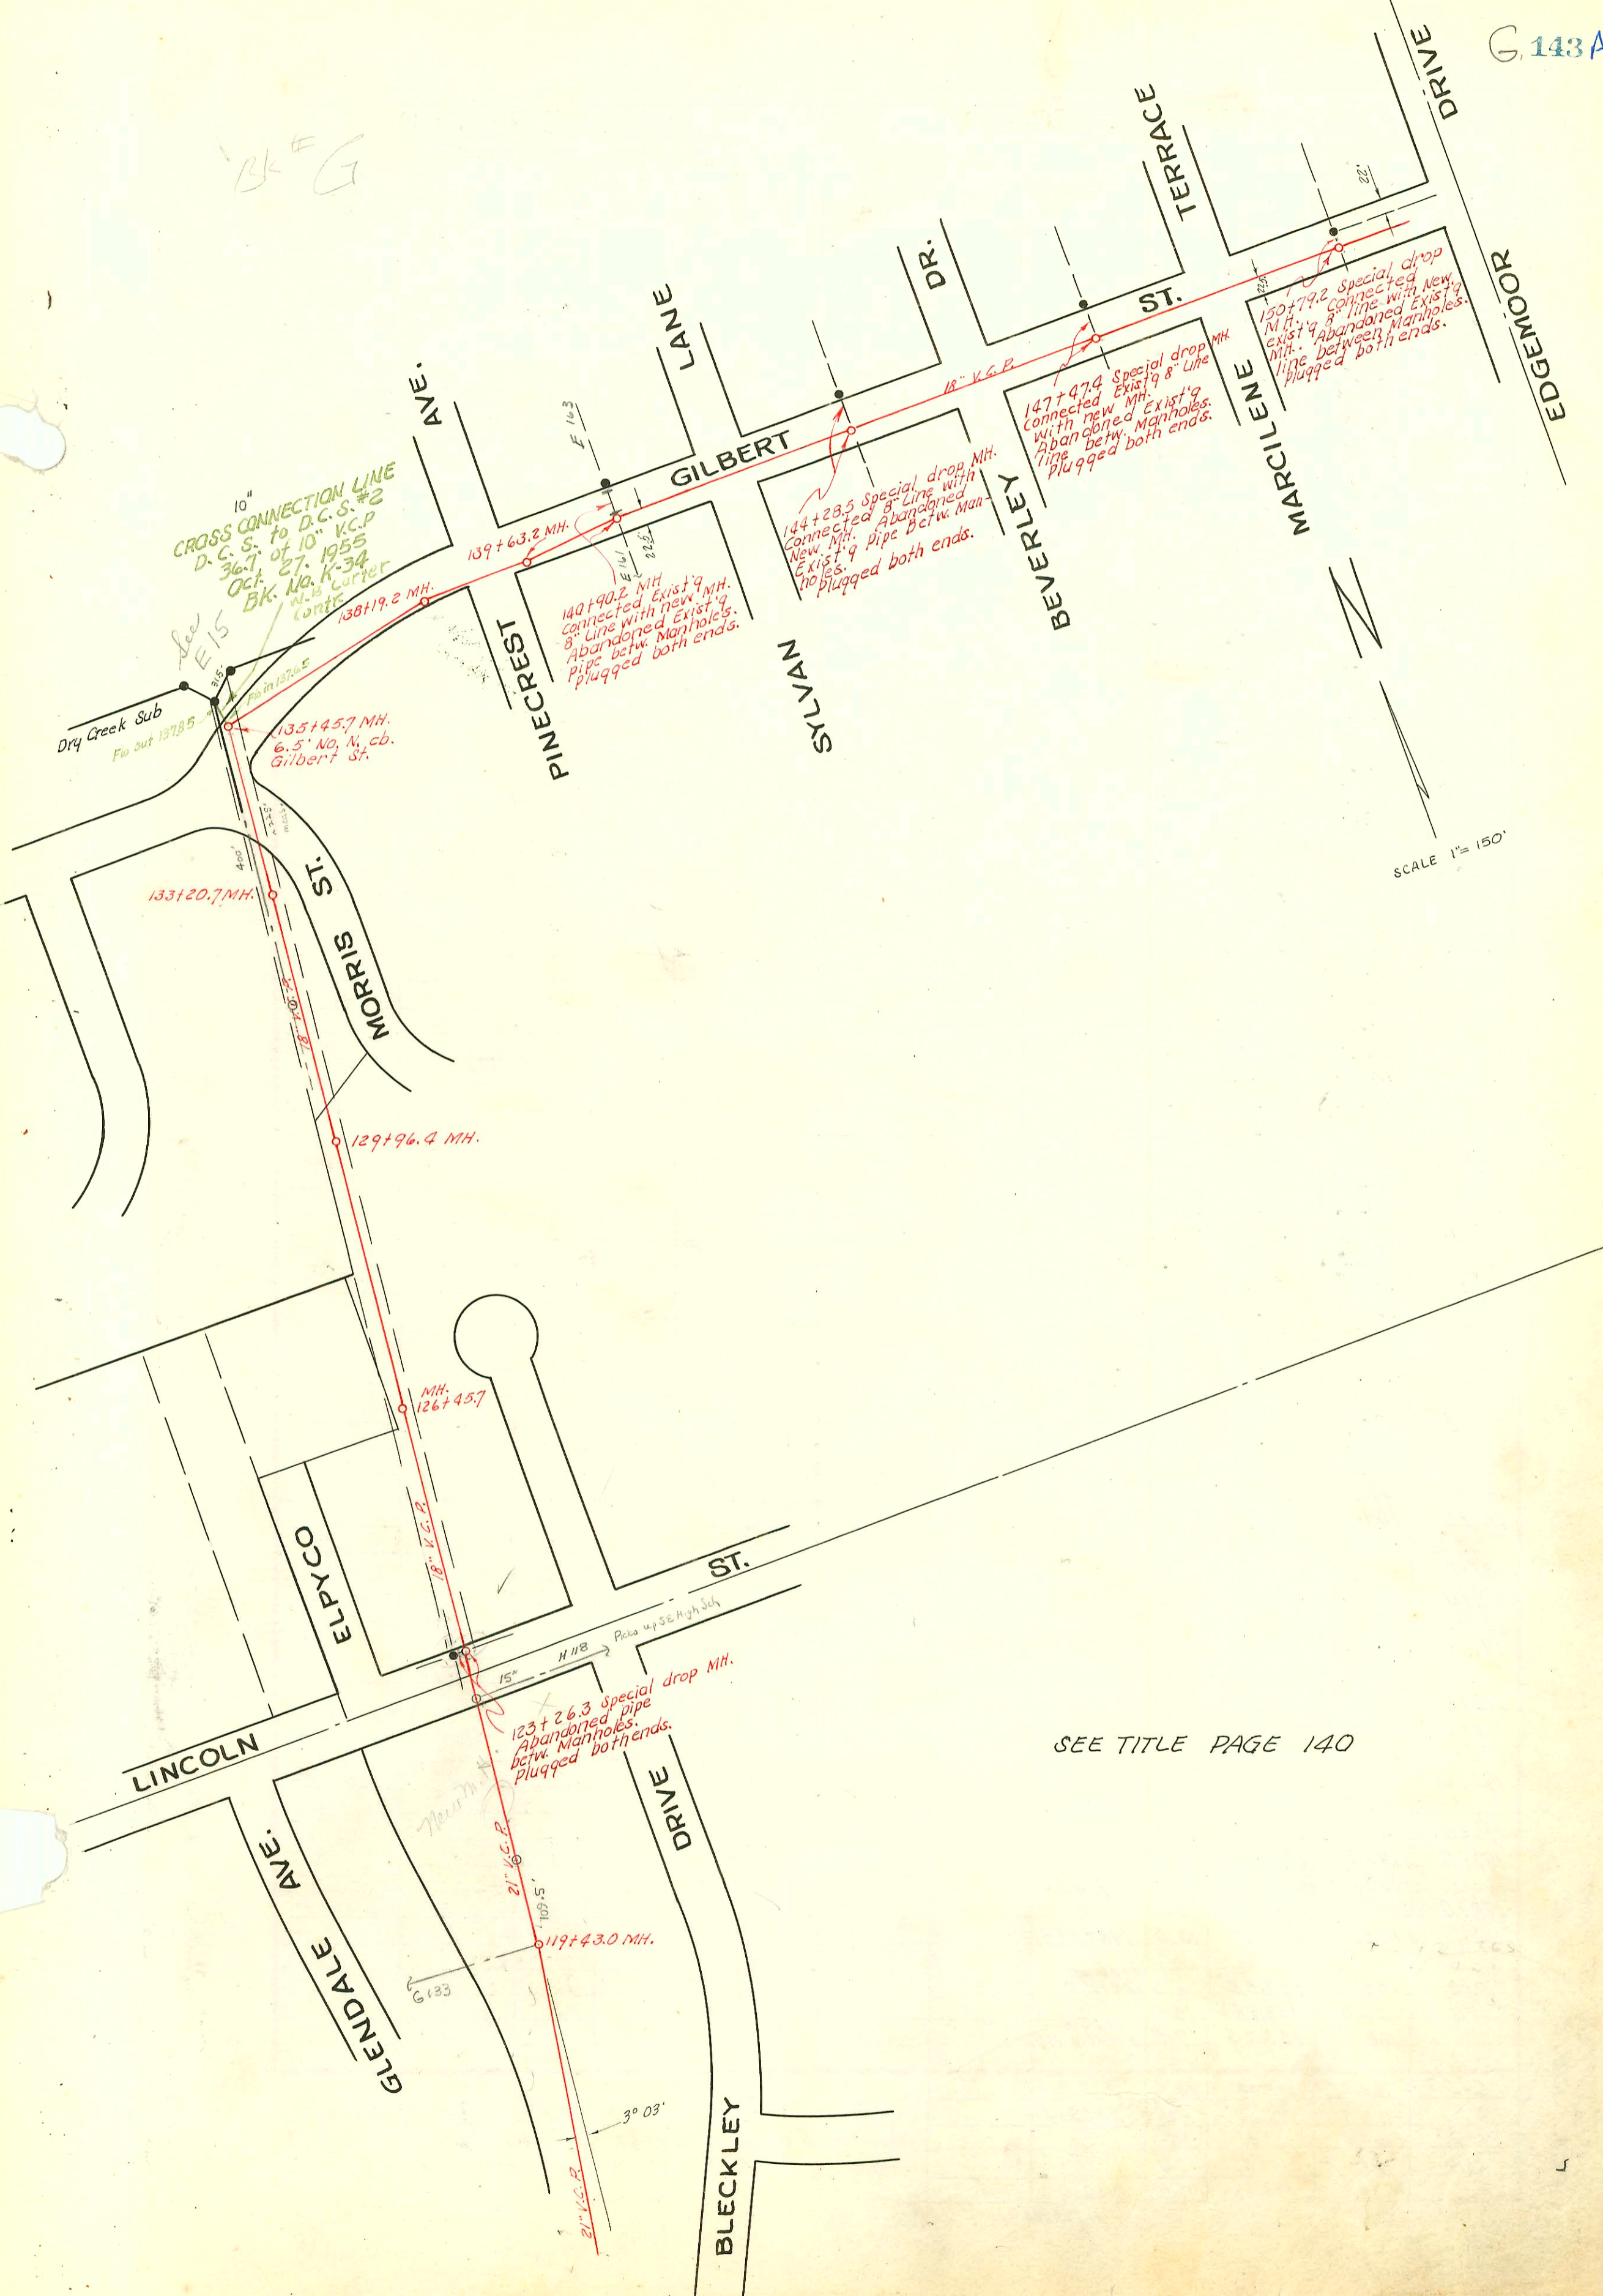

10" CROSS CONNECTION LINE  
 D.C.S. to D.C.S. #2  
 36.7' of 10" V.C.P.  
 Oct. 27, 1955  
 BK. No. K-34  
 W.B. Carter  
 Cont'd.

140+90.2 MH  
 Connected Exist'g  
 8" Line with new  
 Abandoned Exist'g  
 Pipe betw. Manholes.  
 Plugged both ends.

144+28.5 Special drop MH.  
 Connected Exist'g  
 New MH. Abandoned  
 Exist'g pipe betw. Man  
 holes. Plugged both ends.

147+47.4 Special drop MH.  
 Connected Exist'g  
 with new MH. Abandoned  
 Exist'g pipe betw. Manholes.  
 Plugged both ends.

150+79.2 Special drop  
 MH. Connected  
 Exist'g 8" line with  
 new MH. Abandoned  
 Exist'g pipe betw. Manholes.  
 Plugged both ends.

135+45.7 MH.  
 6.5" No. 1, cb.  
 Gilbert St.

123+26.3 Special drop MH.  
 Abandoned pipe  
 betw. Manholes.  
 Plugged both ends.

SCALE 1" = 150'

SEE TITLE PAGE 140

CONSTRUCTION RECORD						SERVICE RECORD						
STATION	ELEVATION		Depth	MANHOLE	4-INCH "Y" BRANCHES		No. of Permit		House Number		DATE OF PERMITS	
	Ground	Grade			North West	South East	North West	South East	North West	South East	North West	South East
116+0	141.9	130.10	11.8									
117+0	138.0	130.32	7.7									
118+0	139.5	130.54	9.0									
119+0	141.0	130.76	10.2									
	139.4	130.84	8.6	119+43.0								
120+0	140.8	130.98	9.8									
121+0	142.6	131.20	11.4									
122+0	144.0	131.42	12.6									
123+0	146.7	131.64	15.1									
	146.4	131.89 Out 133.42 in	14.7 13.0	123+26.3								
124+0	145.7	133.60	12.1									
125+0	146.6	133.84	12.8									
126+0	146.2	134.08	12.1									
	145.9	134.19	11.7	126+45.7								
127+0	143.8	134.32	9.5									
128+0	142.2	134.56	7.6									
129+0	147.3	134.80	12.5									
	149.1	135.03	14.0	129+96.4								
130+0		135.04										
131+0	146.7	135.28	11.4									
132+0	142.7	135.52	7.2									
133+0	143.8	135.76	8.0									
	146.7	135.81	10.9	133+20.7								
134+0	148.0	136.00	12.0									
135+0	148.3	136.24	12.1									
	148.4	136.35	12.1	135+45.7								
136+0	148.2	136.48	11.7									
137+0	149.1	136.72	12.4									
138+0	150.2	136.96	13.2									
	150.9	137.00 Out 139.84 in	13.9 11.1	138+19.2								
139+0	152.0	140.03	12.0									
	154.4	140.19	14.2	139+63.2								
140+0	155.4	140.28	15.1									
	157.5	140.49	17.0	140+90.2								
141+0		140.52										
142+0	158.5	140.76	17.7									
143+0	159.2	141.00	18.2									
144+0	159.8	141.24	18.6									
	160.0	141.29	18.7	144+28.5								
145+0	160.1	141.48	18.6									
146+0	163.0	141.72	21.3									
147+0	162.0	141.96	20.0									
	161.7	142.07	19.6	147+47.4								
148+0	162.0	142.20	19.8									
149+0	162.3	142.44	19.9									
150+0	163.4	142.68	20.7									
	163.9	142.87	21.0	150+79.2								

# 15844 - 5051 E. Lincoln - Daniel Williams 7-3-62 (6" Blue S. from M.H.)  
 # 15845 " " " " (6" Steel N.E. of new M.H.)